


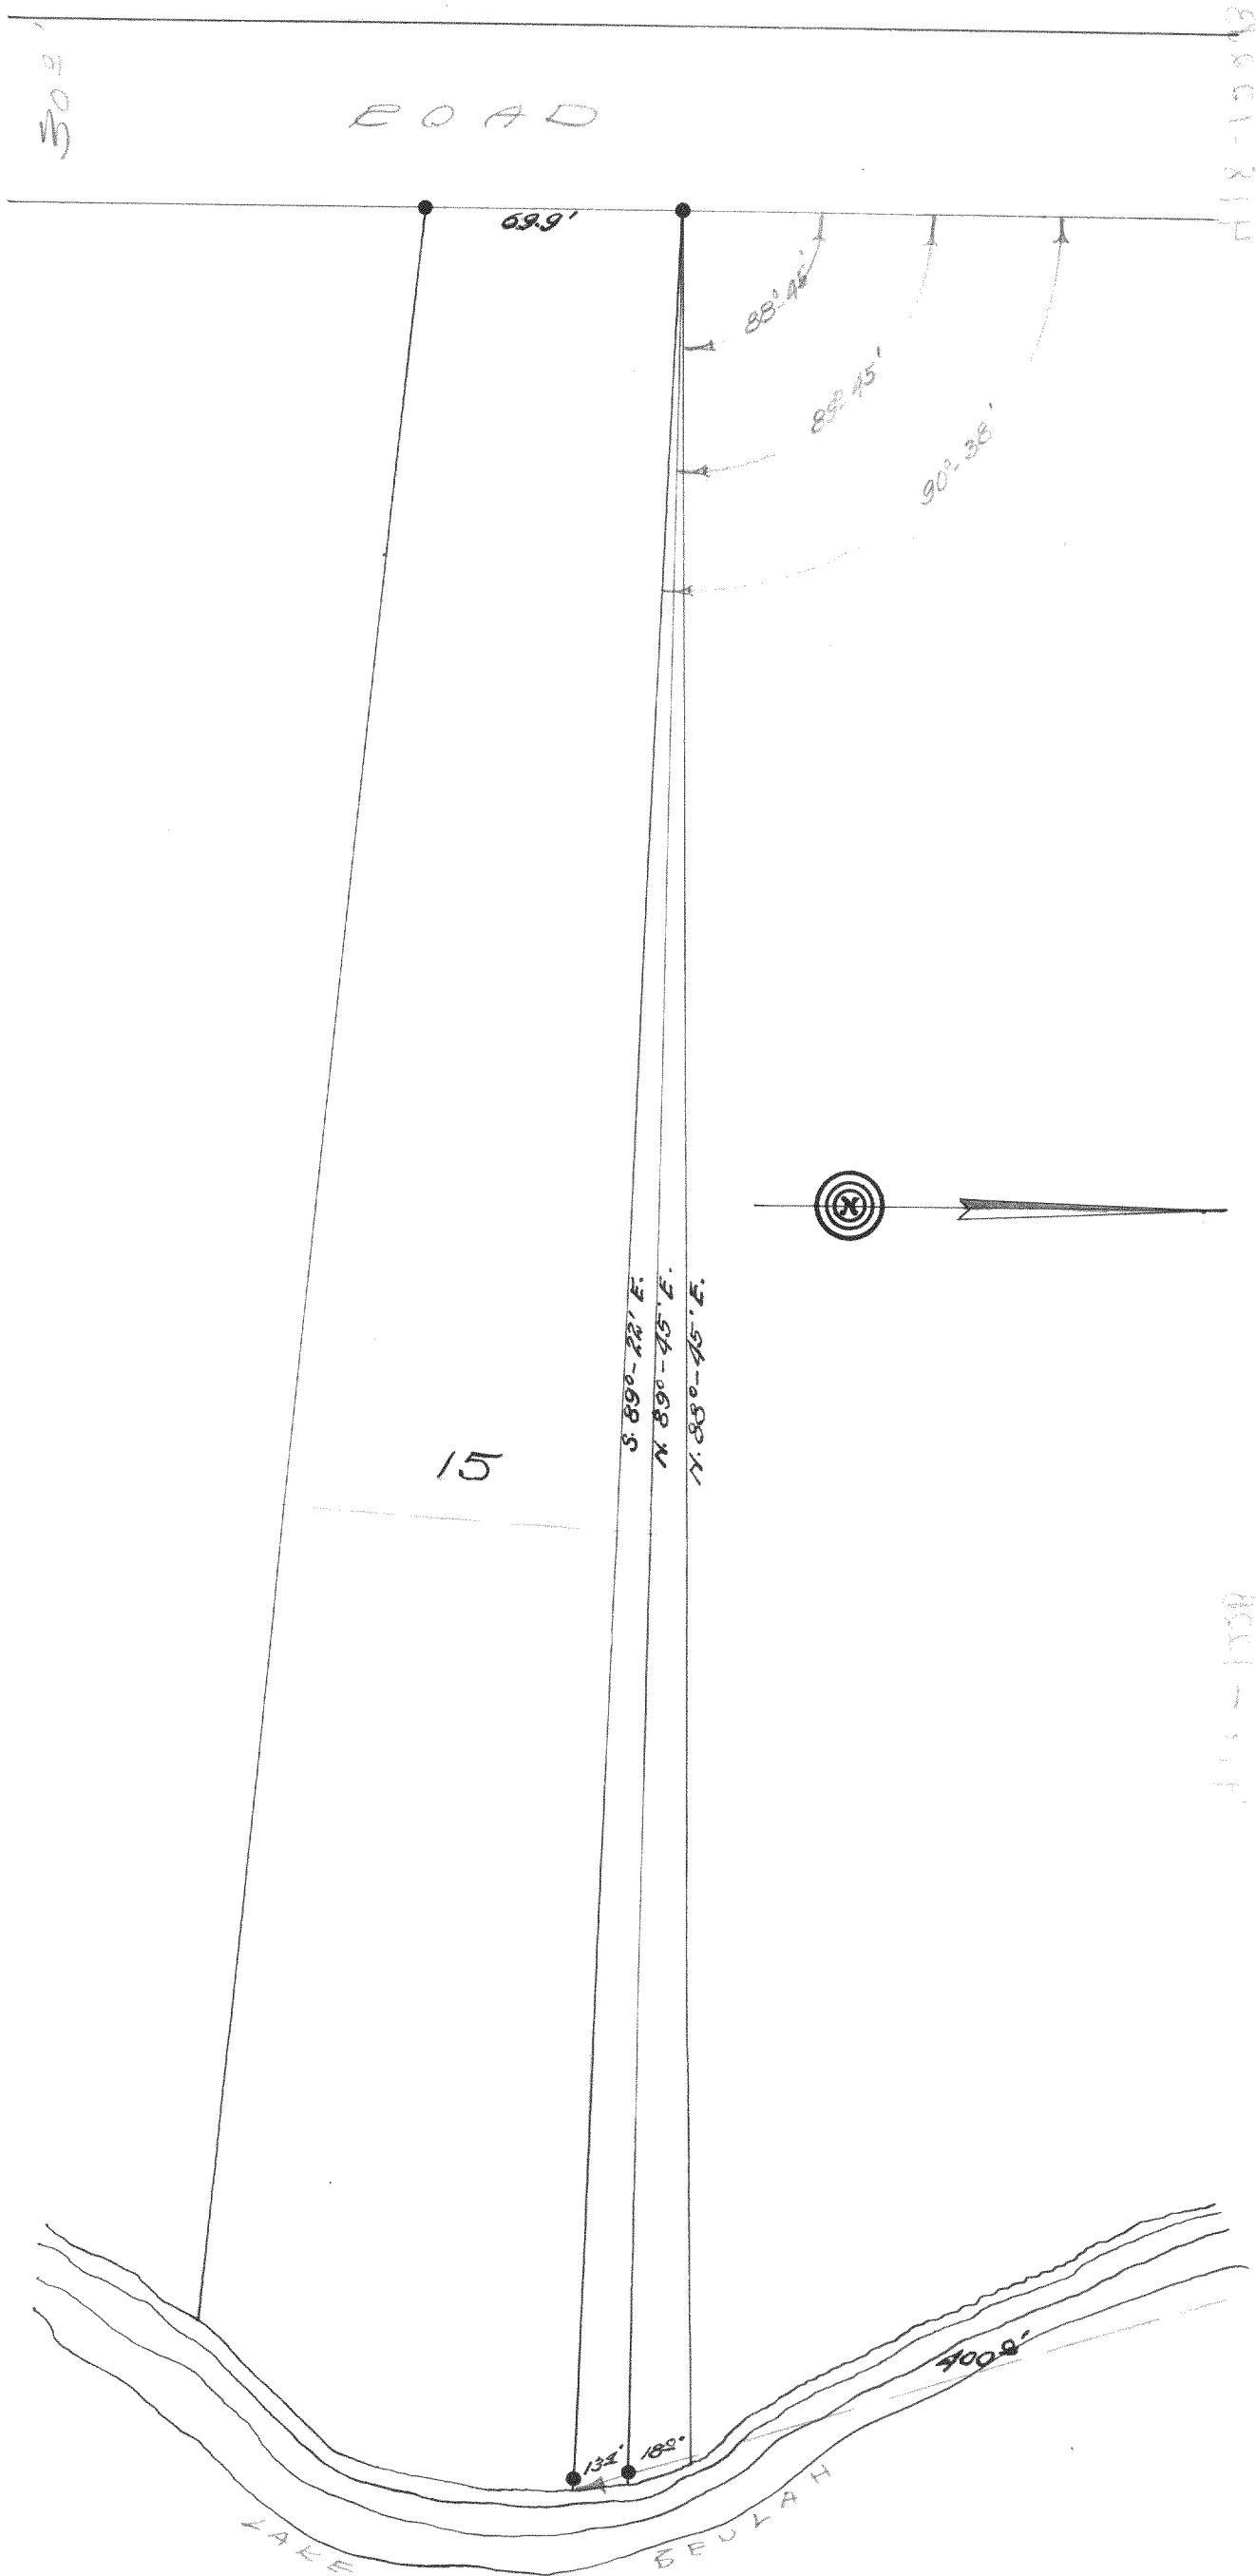

Northerly line of Lot 15 Bomadtko Park Subdivision on Lake Beulah Walworth County Wisconsin
 as surveyed by Joseph M. Pigi. Professional Engineer Elkhorn Wisconsin. June 8 1940.

Line; N. $88^{\circ}45'$ E., is line as taken from plat presented by Thomas Gowne.

Line; N. $89^{\circ}45'$ E., is line as shown upon the recorded plat.

Line; S. $89^{\circ}22'$ E., is line which crosses the meander line 400 feet southerly of the
 northeasterly corner of Lot 12 in said subdivision.

Joseph M. Pigi.
 Joseph M. Pigi. Professional Engineer
 Elkhorn Wisconsin.