


59-91

418-1530

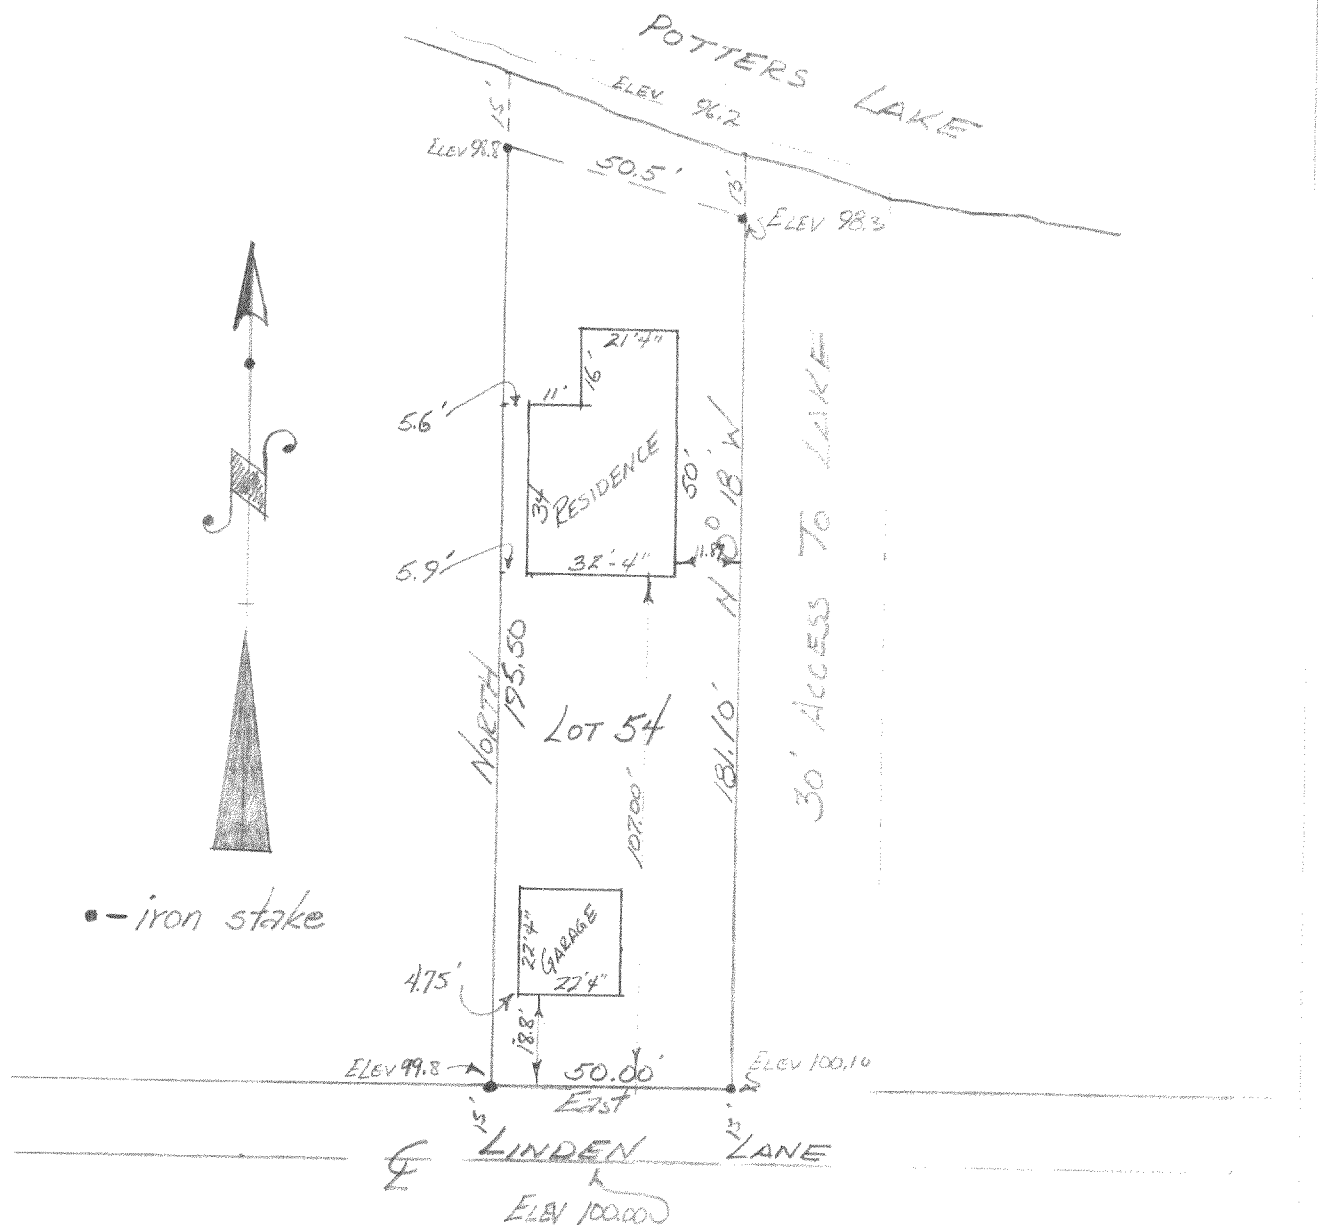

• - iron stake

DESCRIPTION: Lot 54 of Shorewood Subdivision in the Town of East Troy (T 4 N, R 18 E.) Walworth County, Wisconsin.

CERTIFICATE: I James F. Biagi, Surveyor, do hereby certify that I have surveyed the property hereon described, and that the location of all the improvements are as shown on the drawing above.

SIGNED AND SEALED THIS 1ST DAY OF SEPTEMBER 1959



James F. Biagi
SURVEYOR (272)

PS-51

418-123E