


HAROLD H. KOLB

REGISTERED PROFESSIONAL LAND SURVEYOR
LAKE GENEVA, WISCONSIN

POTTER'S LAKE

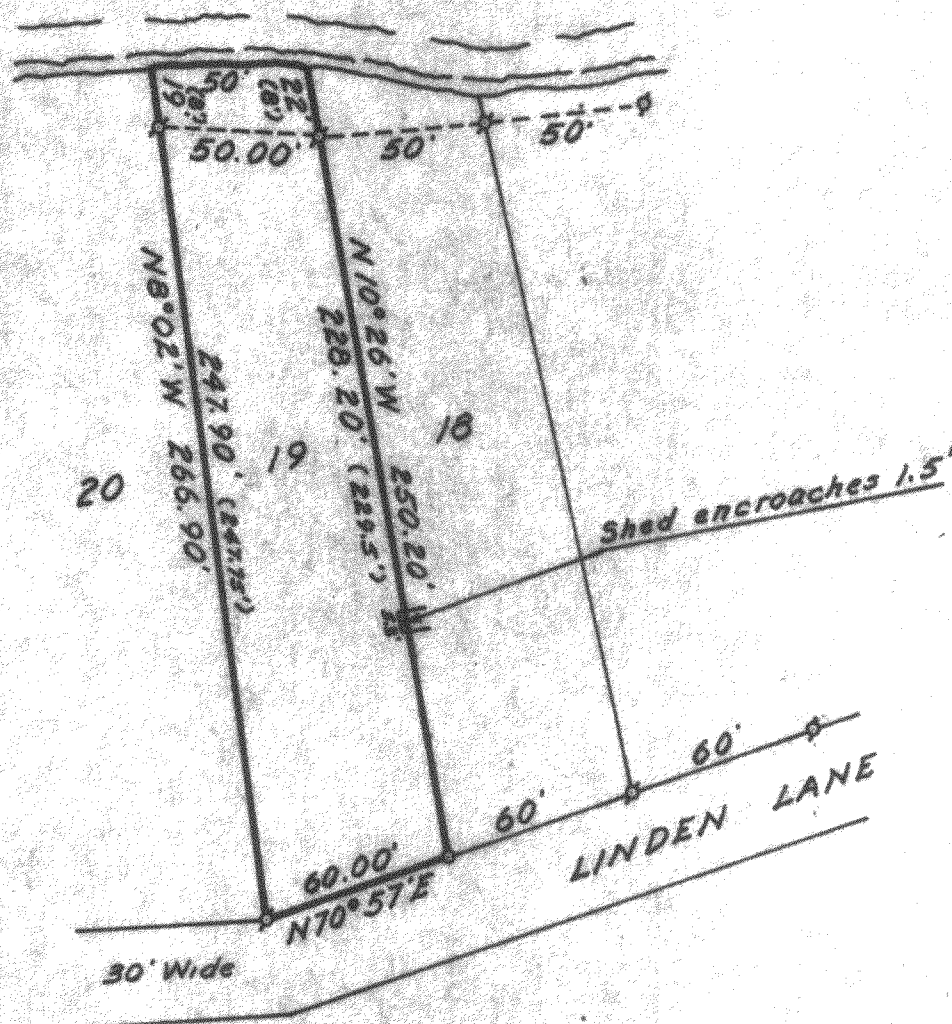

N



SCALE 1"=60'

LEGEND

- $\square$ - IRON PIPE FOUND
- $\circ$ - IRON PIPE PLACED
- $\bullet$ - CONCRETE MONUMENT
- $\times$ - SPIKE
- (g) - Platted Distance

PLAT OF SURVEY OF

Lot 19, Shorewood, a subdivision located in
Sections 10, 11, 14 & 15, T 4 N, R 18 E,
Walworth County, Wisconsin.

I, HAROLD H. KOLB, DO HEREBY CERTIFY THAT I HAVE
SURVEYED THE PROPERTY HEREON DESCRIBED ACCORDING
TO THE OFFICIAL RECORDS, AND THAT THE PLAT HEREON
IS A CORRECT REPRESENTATION OF THE LOT LINES, and all
the encroachments thereon.

Harold H. Kolb

HAROLD H. KOLB

WISCONSIN REGISTERED LAND SURVEYOR, S-187

DATE January 24, 1966