


#104-73

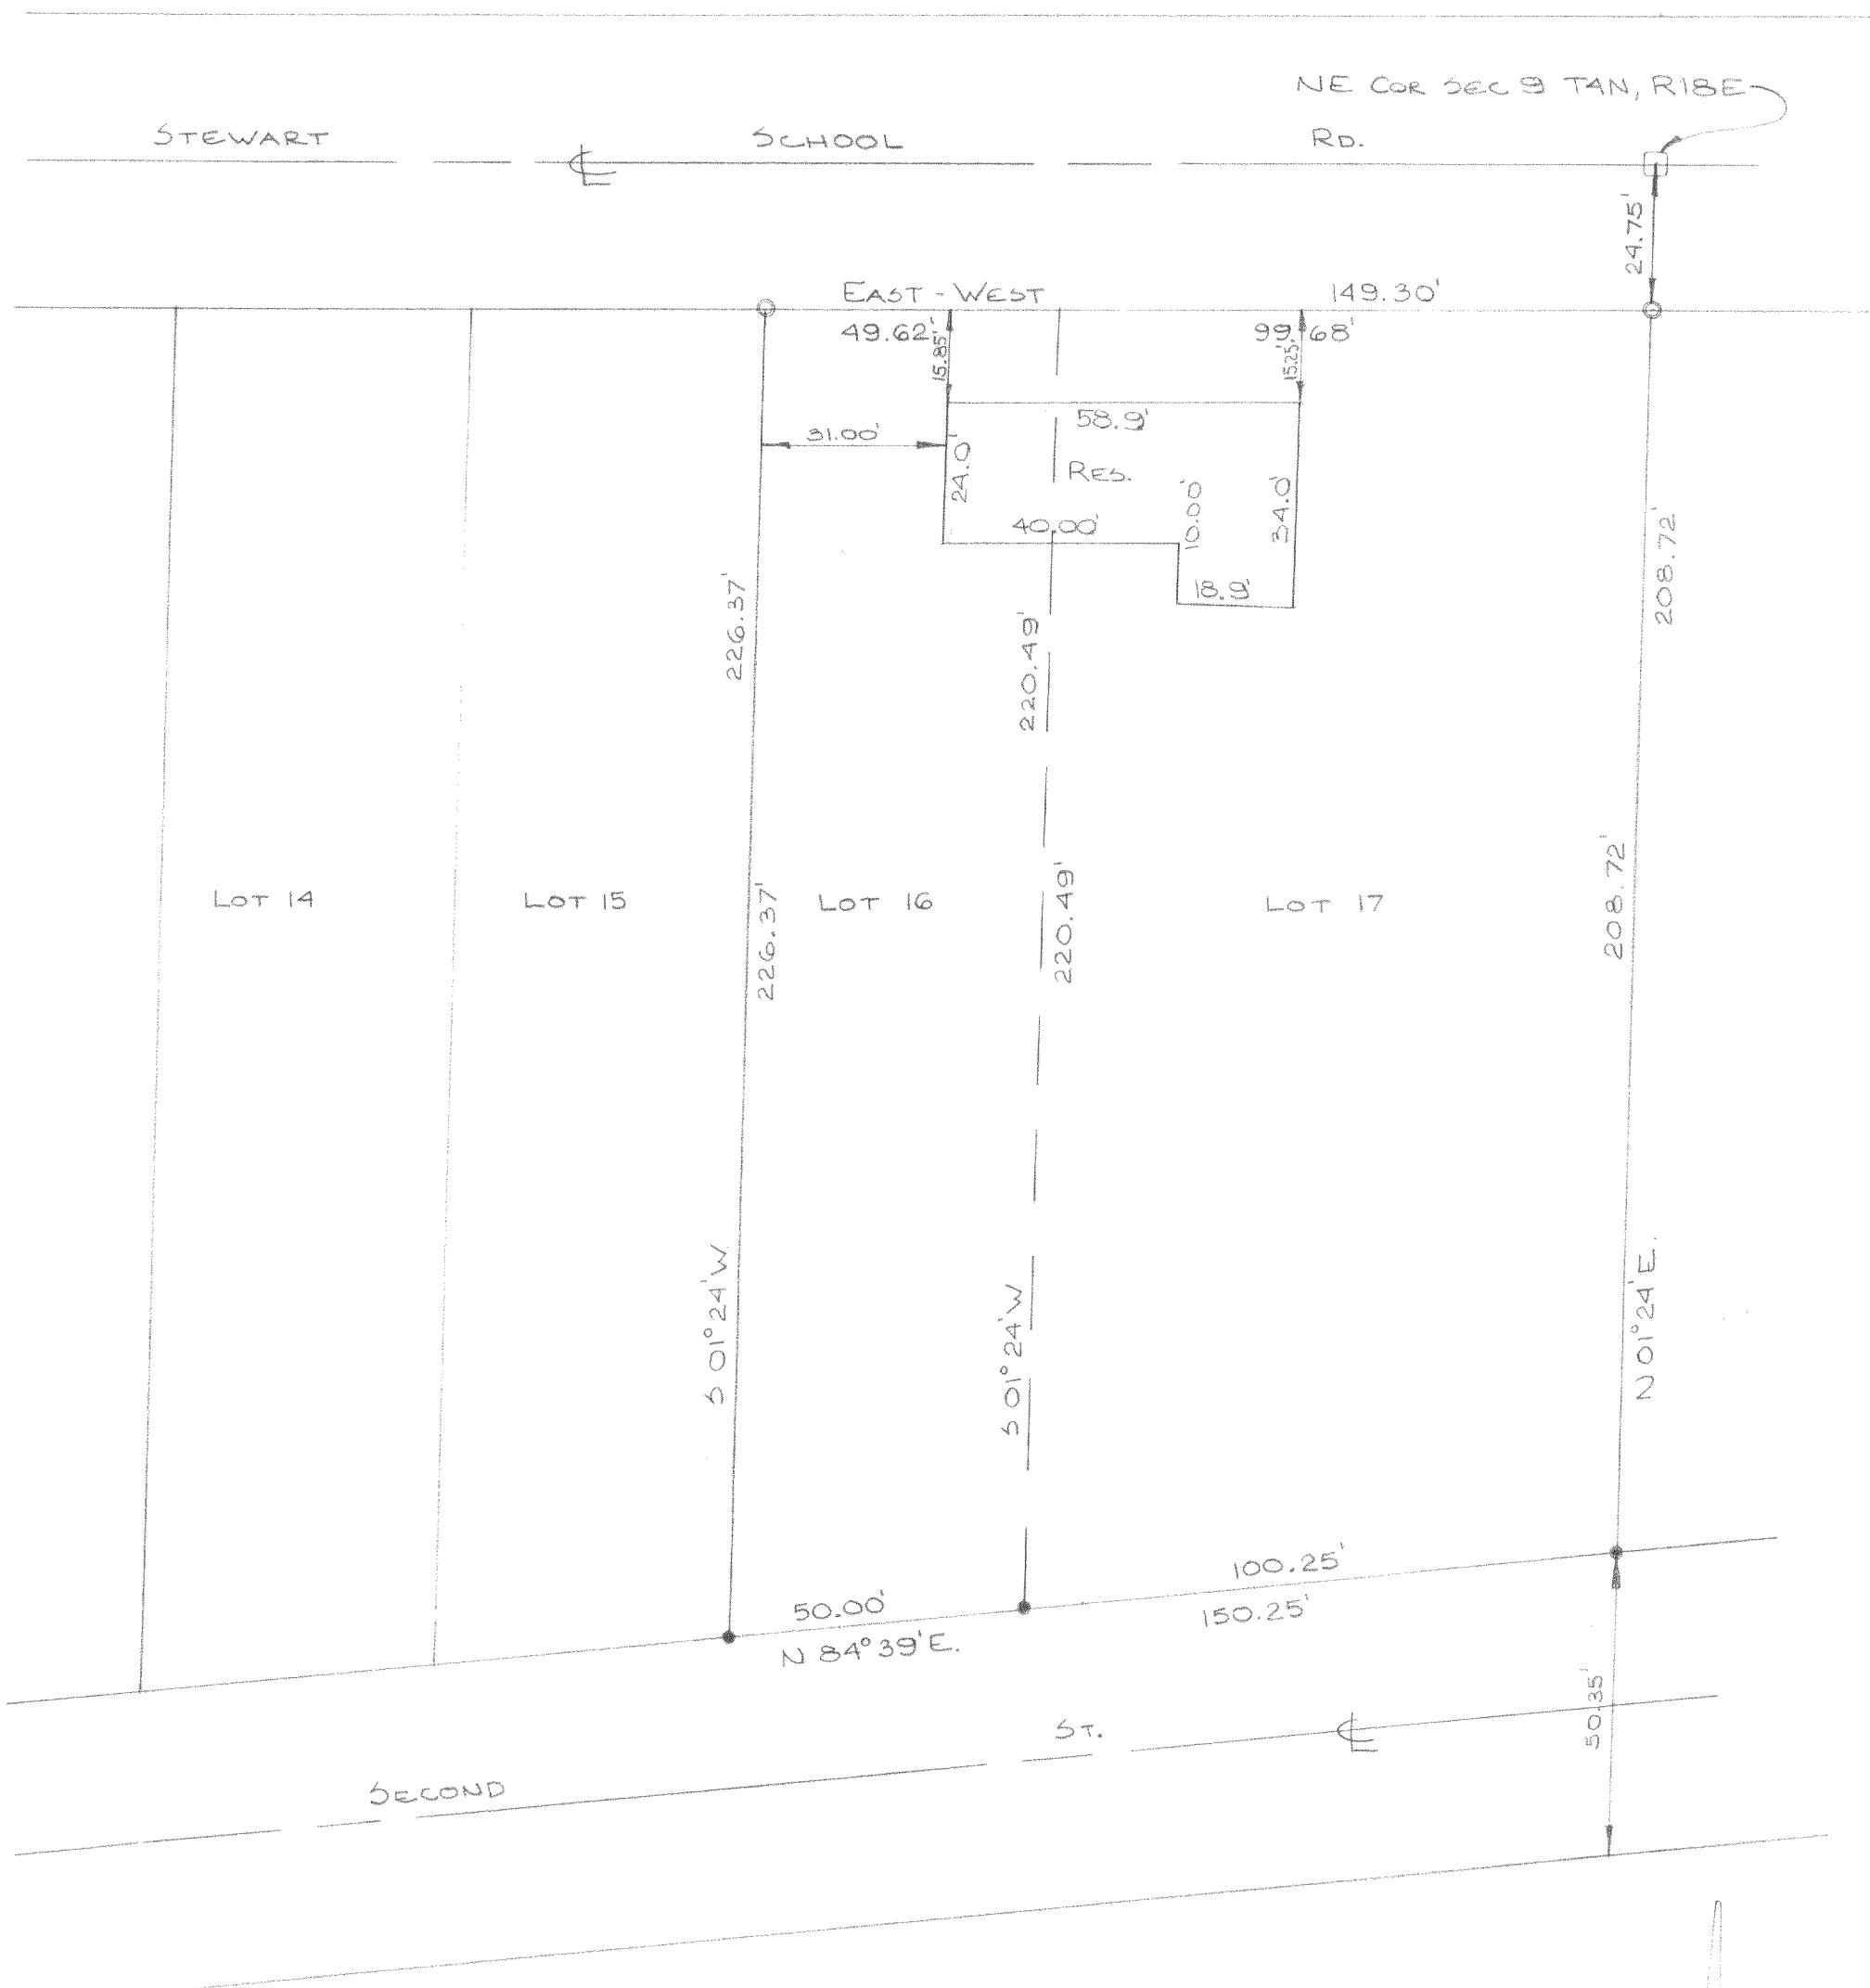


DESCRIPTION: Lots 16 & 17, Hart's Beulah View Subdivision, located in the NE $\frac{1}{4}$ of the NE $\frac{1}{4}$ of Section 9, T4N, R18E, Walworth County, Wisconsin.

CERTIFICATE: I, Joseph M. Biagi, Surveyor, do hereby certify that I have surveyed the lands hereon described, and that I have complied with Section 236 of the Wisconsin Statutes.

- SCALE 1"=30'
- — IRON PIPE SET
 - — IRON PIPE FOUND
 - — IRON PLATE FOUND

Joseph M. Biagi
Joseph M. Biagi
Elkhorn, Wisconsin
RLS #12

DATE: December 10, 1973

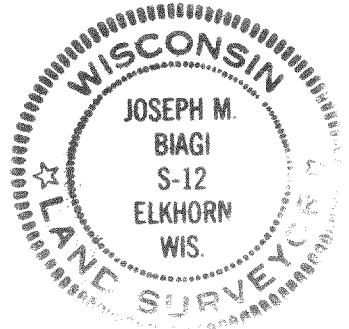

SCALE:	APPROVED BY:	DRAWN BY
DATE:		REVISED
		DRAWING NUMBER

FHS-16, 17

418-133B