

PLAT OF SURVEY
-OF-

LOT 14, BLOCK 20, MIRAMAR ADDITION NO. 1, BEING A SUBDIVISION OF PART OF THE NORTHWEST 1/4 AND PART OF THE SOUTHWEST 1/4 OF THE NORTHEAST 1/4 OF SECTION 10, TOWNSHIP 4 NORTH, RANGE 18 EAST OF THE FOURTH PRINCIPAL MERIDIAN IN THE TOWNSHIP OF EAST TROY, WALWORTH COUNTY, WISCONSIN.


SURVEY FOR: HACKBARTH BUILDERS
SURVEY LOCATION: _____ ELM STREET

PROPOSED DWELLING WAS STAKED ON ACTUAL CORNERS WITH FIVE FOOT CONTROL ON THE LONGEST HOUSE LINE. THE CONTRACTOR WILL BE RESPONSIBLE TO FIELD VERIFY ALL STAKES FOR LOCATION AND DIMENSION PRIOR TO CONSTRUCTION. THIS OFFICE SHOULD BE NOTIFIED AT ONCE IF ANY DISCREPANCIES OCCUR.

PROPOSED FN. FL.: _____
PROPOSED YD. GR.: _____


"I hereby certify that I have surveyed the above described property and that the above map is a correct representation thereof and shows the size and location of the property, its exterior boundaries, the location of all visible structures and dimensions of all principal buildings thereon, boundary fences, apparent easements, roadways and encroachments, if any."

"This survey is made for the use of the present owners of the property, and those who purchase, mortgage, or guarantee the title thereto within one year from date hereof."

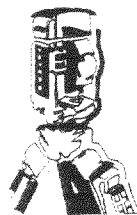




B.W. SURVEYING

412 N. PINE STREET
BURLINGTON, WI 53105
(414)-767-0225

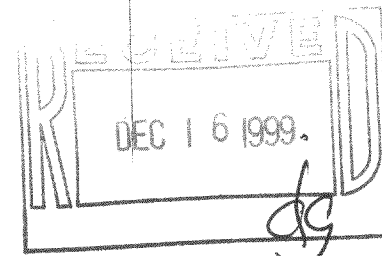

I HEREBY CERTIFY THAT THE EXISTING FOUNDATION SHOWN ON THIS PLAT OF SURVEY IS LOCATED AS SHOWN THUS (), DATED THIS 18TH DAY OF OCTOBER, 1999.

Robert J. Wetzel
ROBERT J. WETZEL S-1778

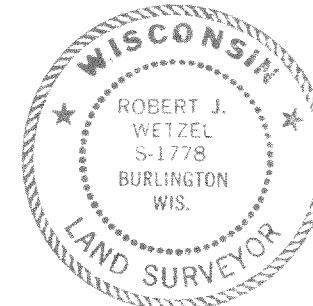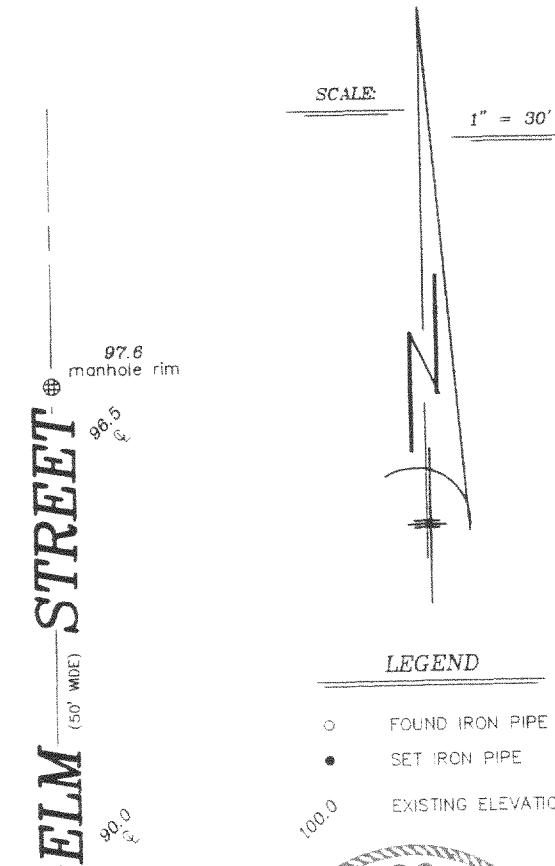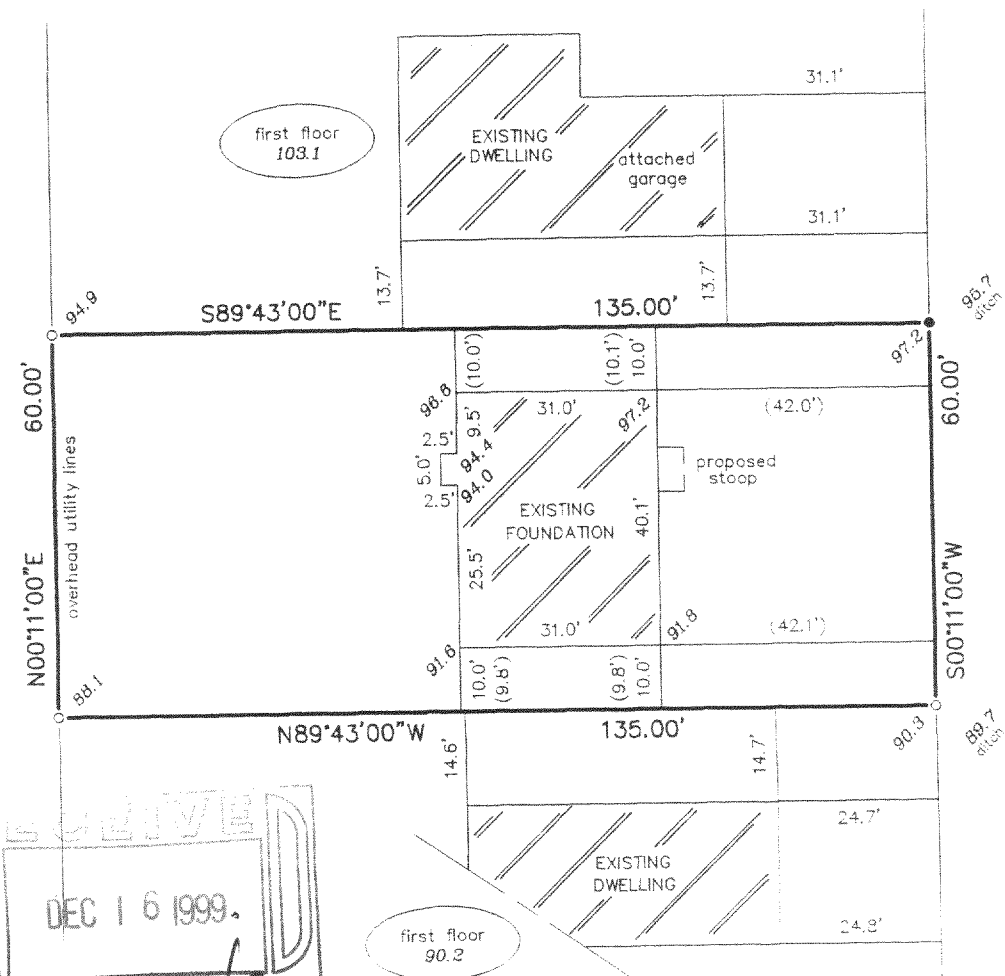

Robert J. Wetzel
ROBERT J. WETZEL S-1778

AUGUST 20, 1999
DATE

4143
JOB NUMBER

PMR1-33

418-1356

PLAT OF SURVEY
-OF-

LOT 14, BLOCK 20, MIRAMAR ADDITION NO.
1, BEING A SUBDIVISION OF PART OF THE
NORTHWEST 1/4 AND PART OF THE SOUTHWEST
1/4 OF THE NORTHEAST 1/4 OF SECTION 10,
TOWNSHIP 4 NORTH, RANGE 18 EAST OF THE
FOURTH PRINCIPAL MERIDIAN IN THE TOWNSHIP
OF EAST TROY, WALWORTH COUNTY, WISCONSIN.


SURVEY FOR: HACKBARTH BUILDERS
SURVEY LOCATION: _____ ELM STREET

PROPOSED DWELLING WAS STAKED ON ACTUAL
CORNERS WITH FIVE FOOT CONTROL ON THE
LONGEST HOUSE LINE. THE CONTRACTOR WILL
BE RESPONSIBLE TO FIELD VERIFY ALL STAKES
FOR LOCATION AND DIMENSION PRIOR TO CON-
STRUCTION. THIS OFFICE SHOULD BE NOTIFIED
AT ONCE IF ANY DISCREPANCIES OCCUR.

PROPOSED FN. FL.: _____
PROPOSED YD. GR.: _____



"I hereby certify that I have surveyed the above described
property and that the above map is a correct representation thereof
and shows the size and location of the property, its exterior
boundaries, the location of all visible structures and dimensions
of all principal buildings thereon, boundary fences, apparent
easements, roadways and encroachments, if any."

"This survey is made for the use of the present owners of the
property, and those who purchase, mortgage, or guarantee the
title thereto within one year from date hereof."

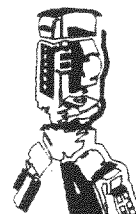

B.W. SURVEYING

412 N. PINE STREET
BURLINGTON, WI 53105
(414)-767-0225

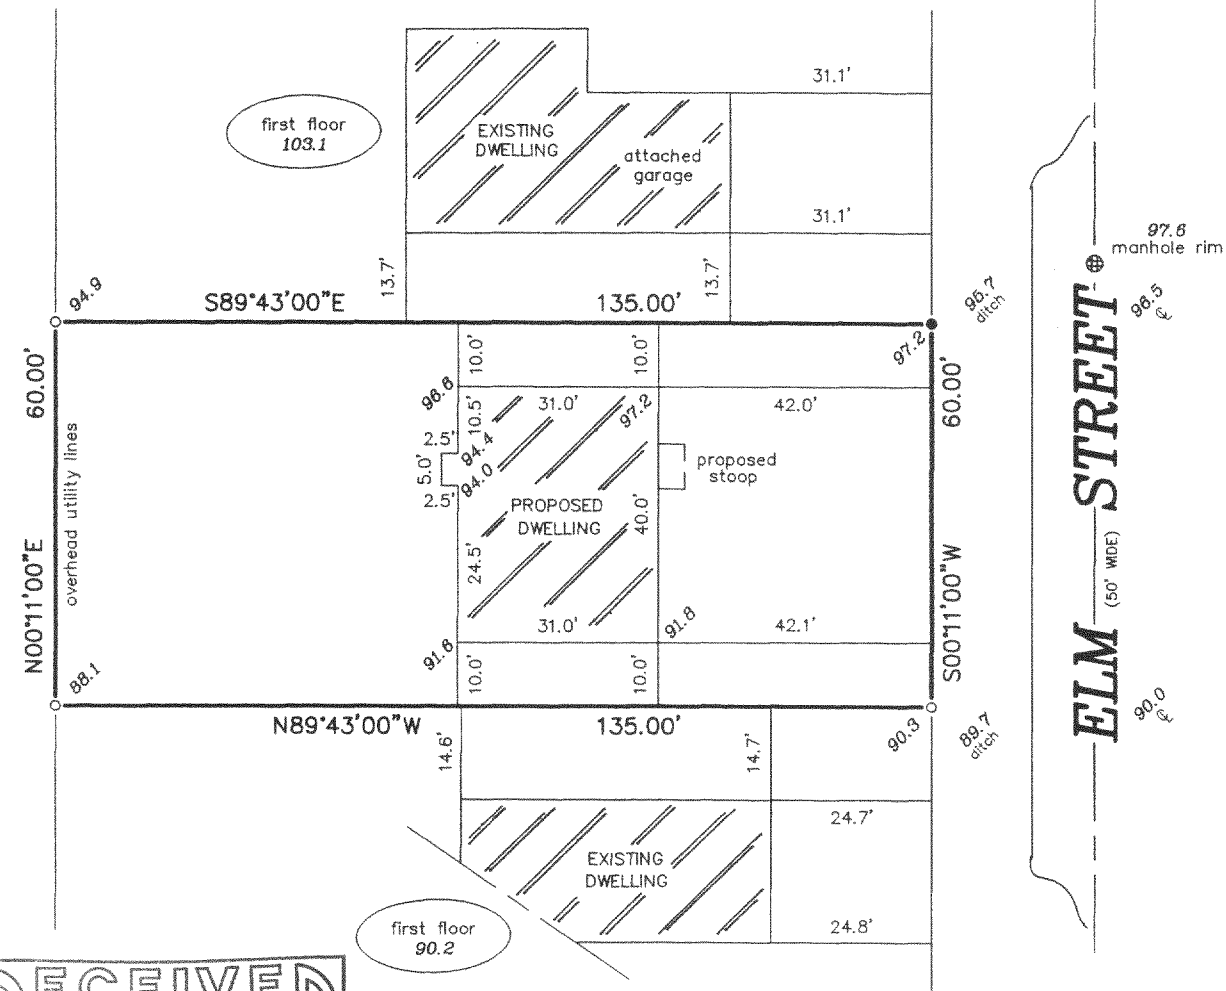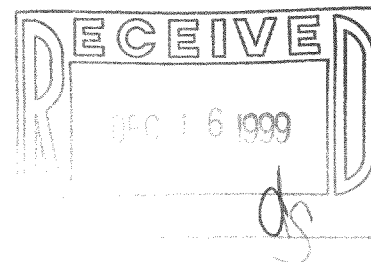


SCALE

1" = 30'

LEGEND

- FOUND IRON PIPE
- SET IRON PIPE
- 100.0 EXISTING ELEVATION

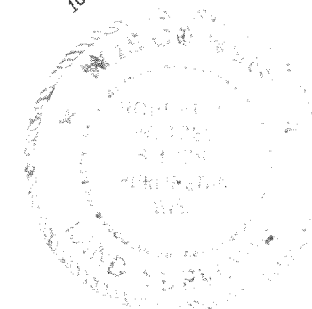

Robert J. Wetzel
ROBERT J. WETZEL S-1778

AUGUST 20, 1999
DATE

4143
JOB NUMBER

PMR1-33

418-1356