


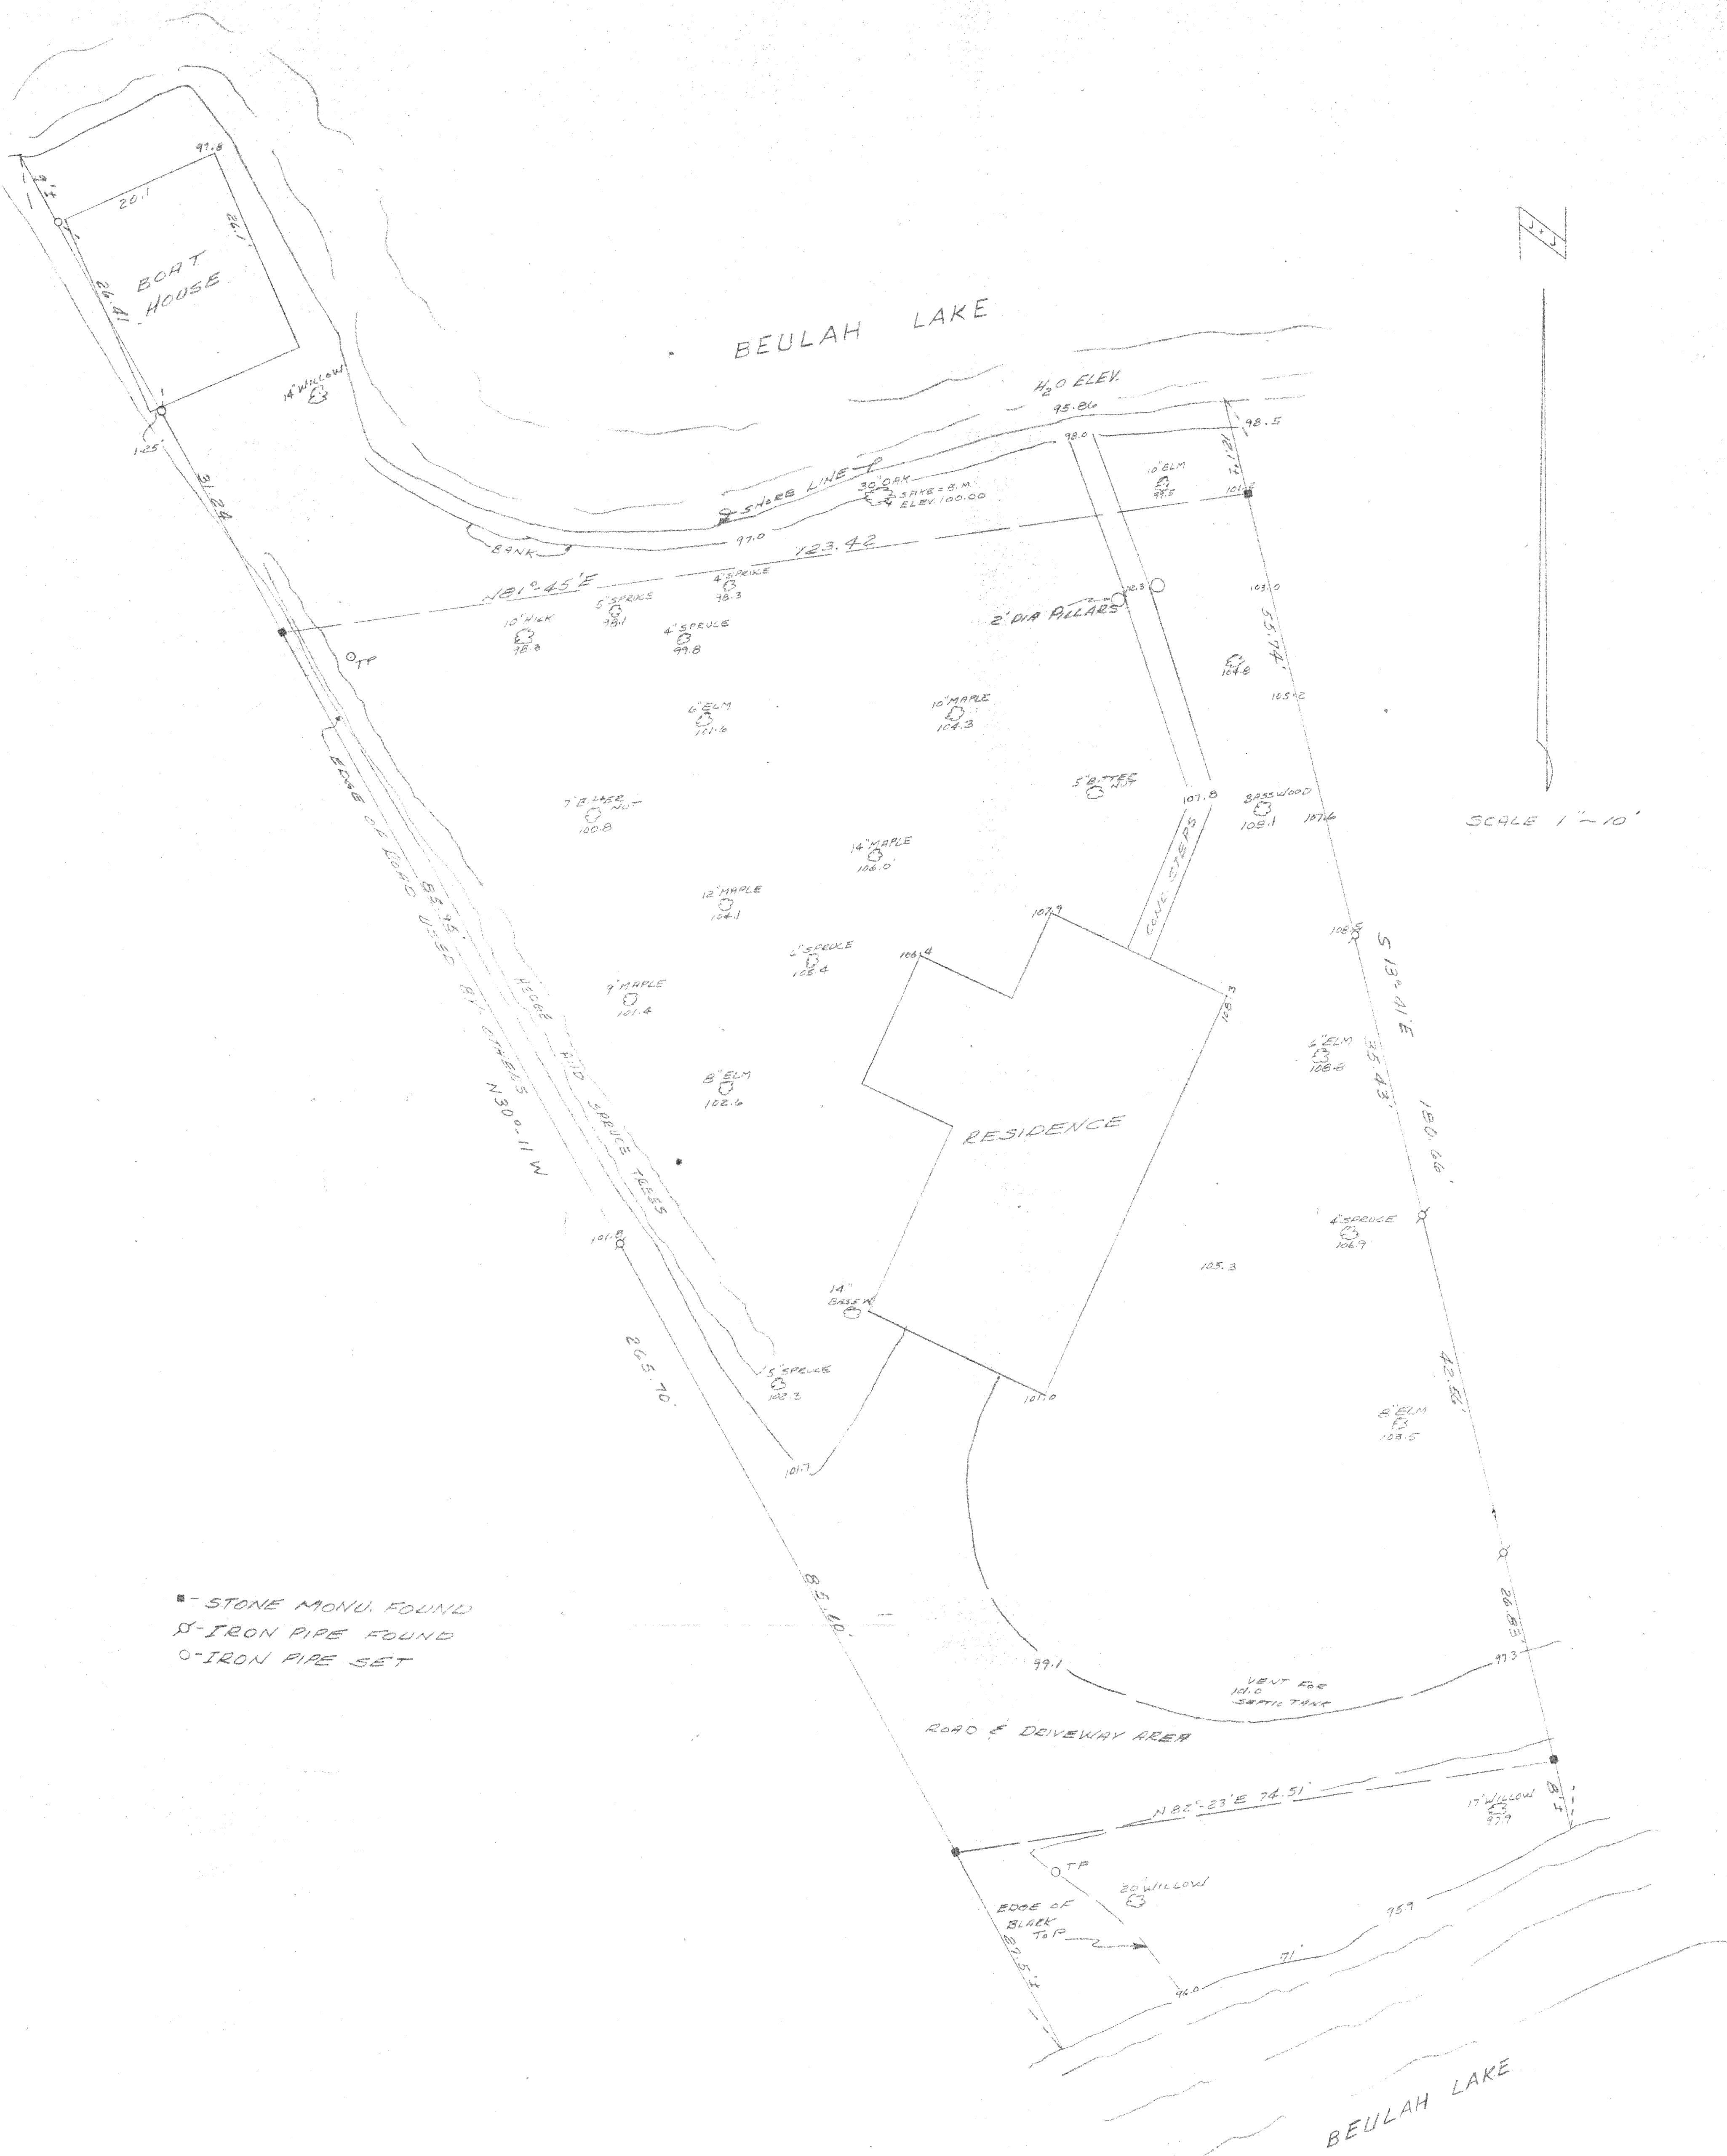


■ - STONE MONU. FOUND
 X - IRON PIPE FOUND
 ○ - IRON PIPE SET

PLAT OF SURVEY
 OF
 LOT 4 OF CHAMBERLAIN'S SUBDIVISION LOCATED
 IN THE NW 1/4 OF SECTION 9, T4N R16E, WALWORTH
 COUNTY, WIS.

AUGUST 1968

Lloyd L. Jensen
 Lloyd L. JENSEN
 COUNTY SURVEYOR

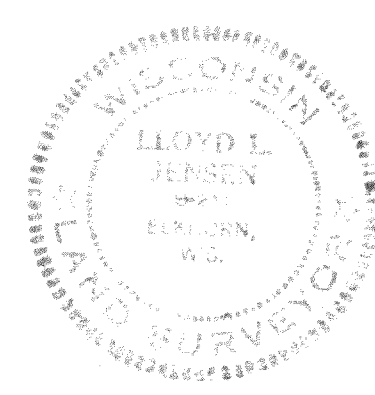

418-135 A