
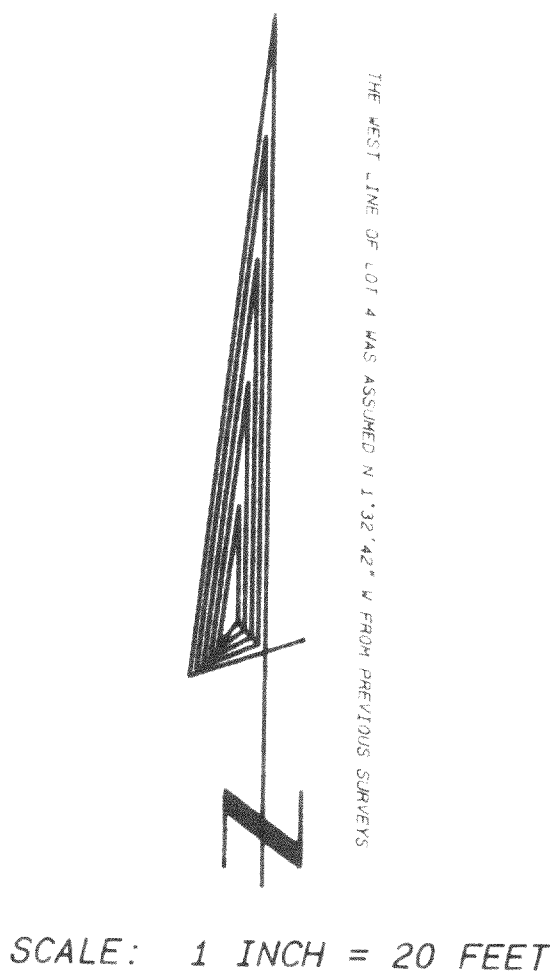


PLAT OF SURVEY


LOT 4, BLOCK 1 OF MIRAMAR SUBDIVISION,
LOCATED IN SECTIONS 10 AND 11, TOWN 4
NORTH, RANGE 18 EAST, EAST TROY TOWNSHIP,
WALWORTH COUNTY, WISCONSIN.

ORDERED BY: CONNIE POGGENSEE
THE RAULAND AGENCY INC.
POST OFFICE BOX 159
WALWORTH, WISCONSIN
53184-0159

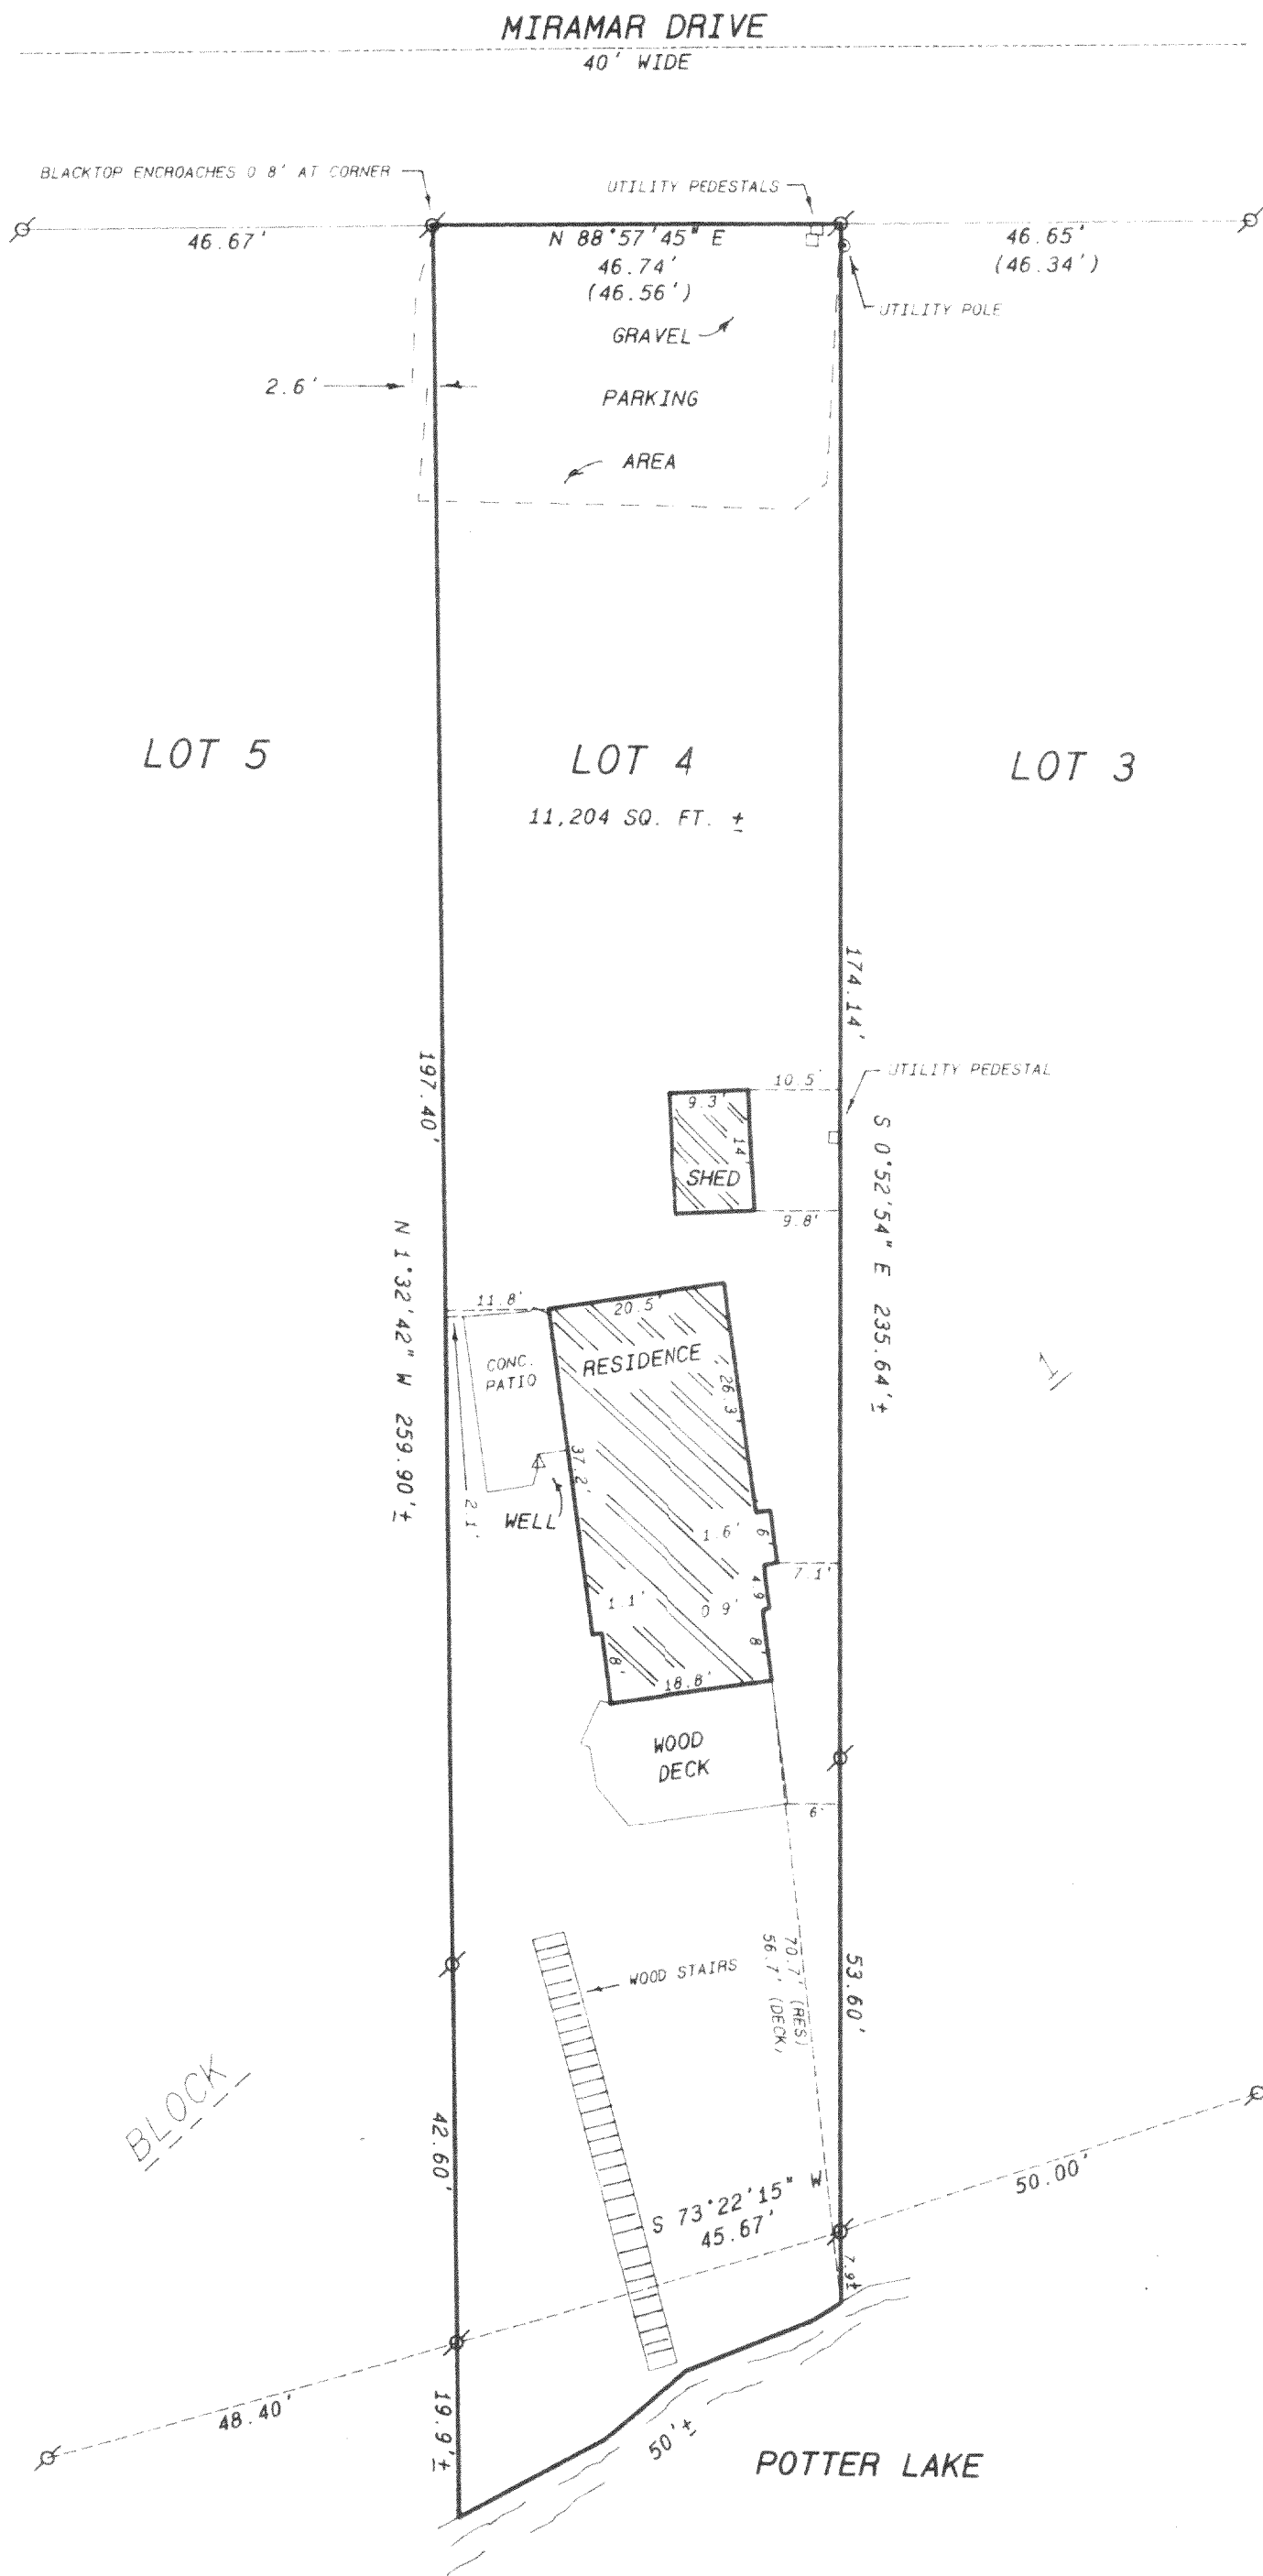

SCALE: 1 INCH = 20 FEET

- Legend**
- FOUND IRON PIPE
 - FOUND IRON ROD
 - FOUND BRASS CAPPED MONUMENT
 - ★ FOUND CONCRETE MONUMENT
 - ✦ CHISEL CUT IN CONCRETE
 - SET IRON ROD, 24" LONG, WEIGHING 1.5 LBS., LINEAL FT., 1/4" DIA.
 - SET IRON ROD, 30" LONG, WEIGHING 4.5 LBS., LINEAL FT., 1/4" DIA.
 - (XX) RECORDED AS DIMENSION
 - - - EXISTING FENCE

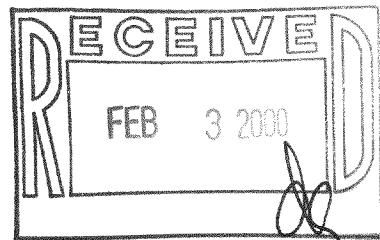

SCALE: 1" = 20 FEET



"I hereby certify that the above described property has been surveyed by me or under my direction and that the above map is a true representation thereof and shows the size and location of the property, its exterior boundaries, the location of all visible structures and dimensions of all principal buildings thereon, boundary fences, apparent easements, roadways and visible encroachments, if any."

"This survey is made for the use of the present owners of the property and also those who purchase, mortgage, or guarantee the title thereto within one year from date hereof."

Kenneth B. Abernathy
KENNETH B. ABERNATHY, JR.
WISCONSIN REGISTERED LAND SURVEYOR,
S-1594
Date: 10-8-99 Job No. 99-916

PMR-3

418-1371