


Plat of Survey

Survey For
Location

Description: TOT 1/2 BLOCK 2 CLEARVIEW, a subdivision located in the Town of East Troy, Range 18 East, Town of East Troy, Walworth County, Wisconsin.

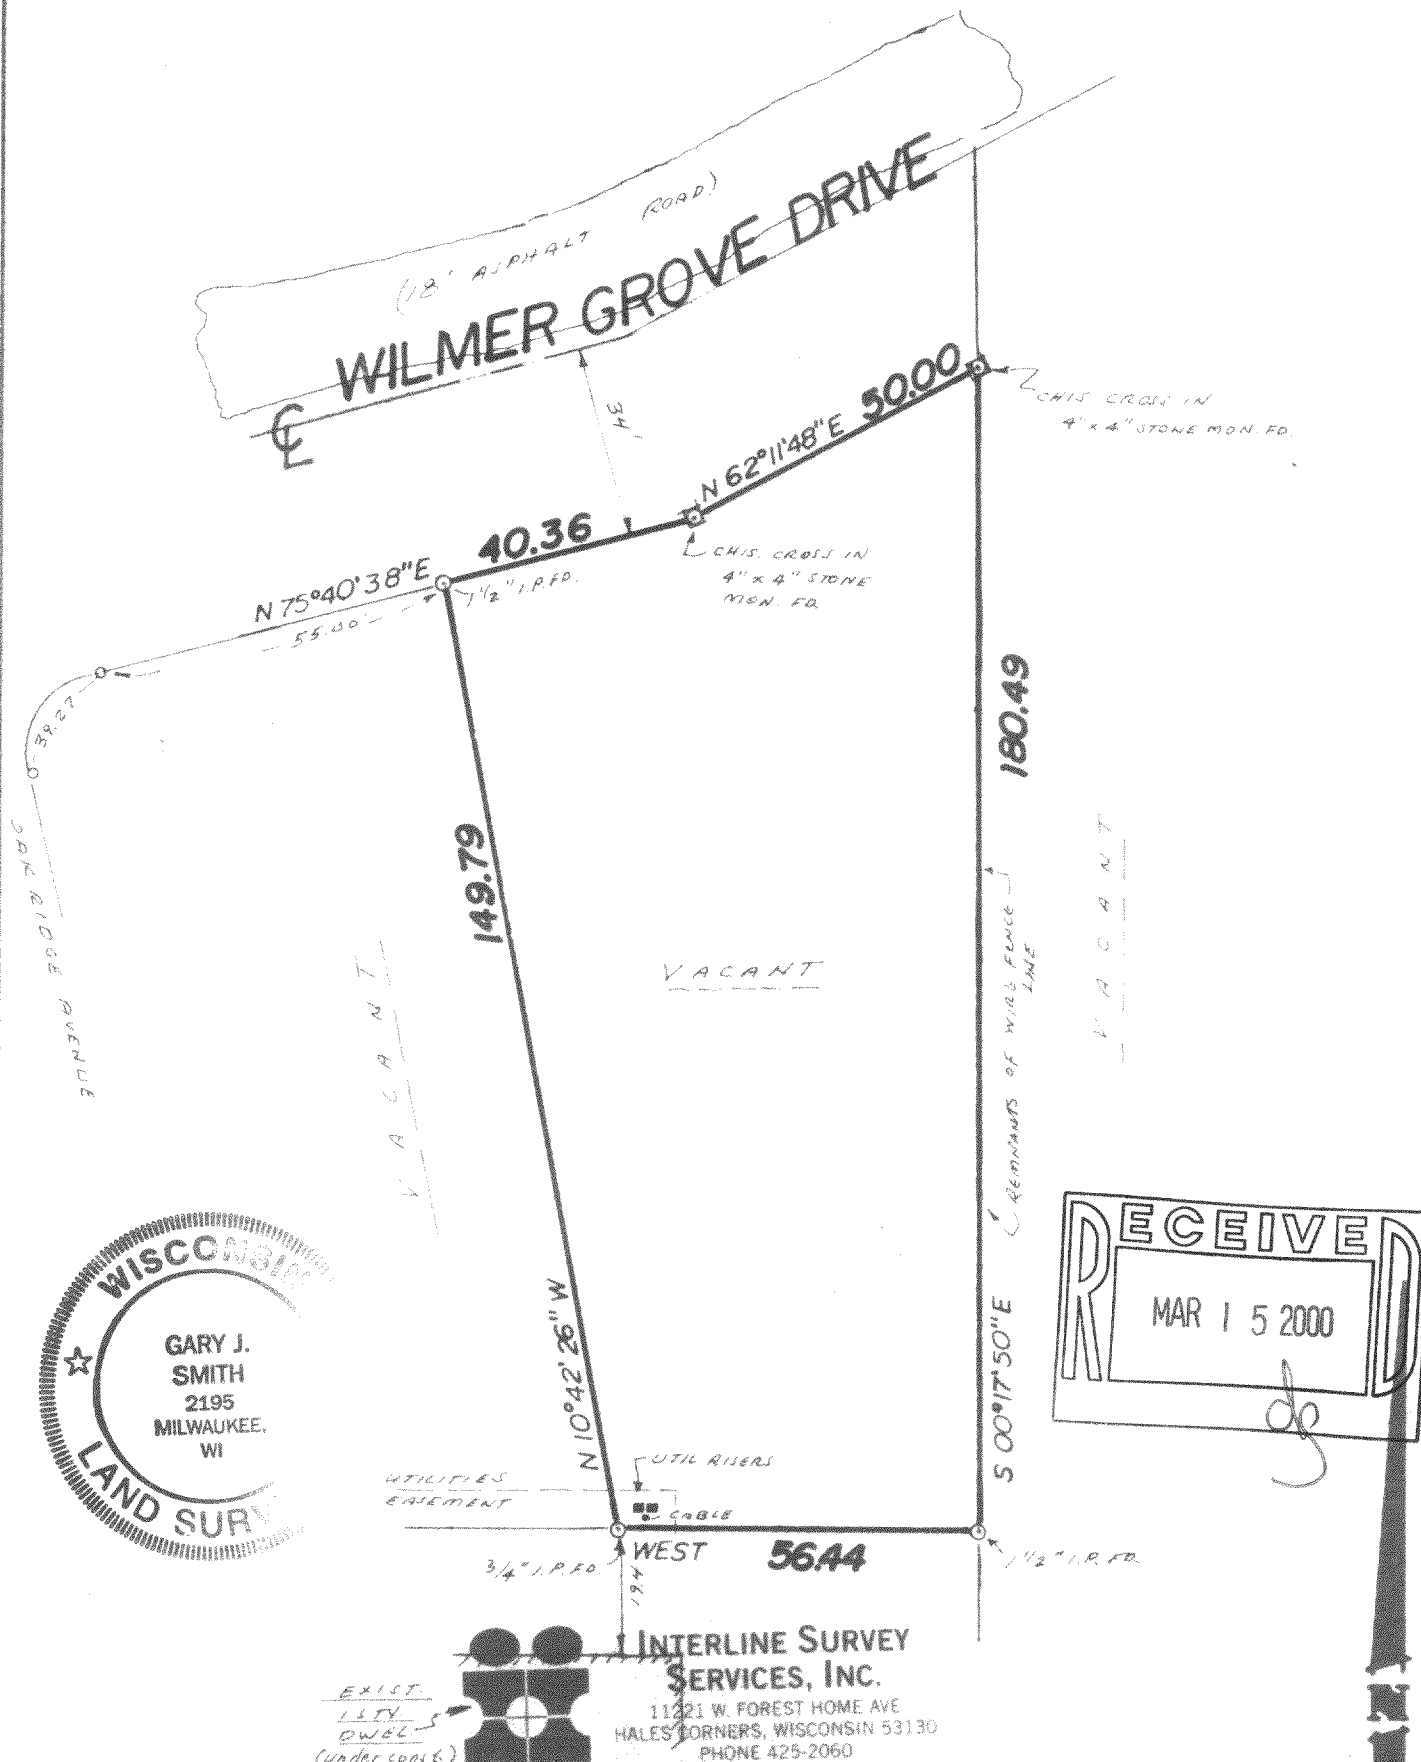

State of Wisconsin ss
Milwaukee County

SURVEY CERTIFICATE

Scale: 1" = 30'

We, Interline Survey Services, Inc., certify that we have surveyed the above described property and the above map is a true representation thereof, and shows the size and location of the property, its exterior boundaries, the location and dimensions of all visible structures thereon, fences, apparent easements and roadways and visible encroachments, if any.

This survey is made for the exclusive use of the present owners of the Property, and also those who purchase, mortgage, or guarantee the title thereto, within one (1) year from date hereof.

[Signature]
Wisconsin Registered Land

Date: 1/12/00
Job No. 27359

PCV-28

418-1378