

PLAT OF SURVEY


FOR:
DOUGLAS & KATHY NALBERT

RSV ENGINEERING, INC.
ENGINEERS, PLANNERS, SURVEYORS
CONSTRUCTION MANAGERS,
ENVIRONMENTAL SCIENTISTS
801 MAIN STREET, MUKWONAGO, WISCONSIN 53149 (414) 363-2004

GAR. RECERTIFICATION:
DATE 5/23/00
DATE: 3/9/00

DESCRIPTION:


LOT 1 OF NALBERT SUBDIVISION, BEING LOT 7 OF PORTERS SUBDIVISION AND THE EAST 10' OF LOT 3 OF THE ORIGINAL STEVENS SUBDIVISION LOCATED IN GOVERNMENT LOT NO. 1 OF SECTION 8, TOWN 4 NORTH, RANGE 18 EAST, TOWN OF EAST TROY, WALWORTH COUNTY, WISCONSIN

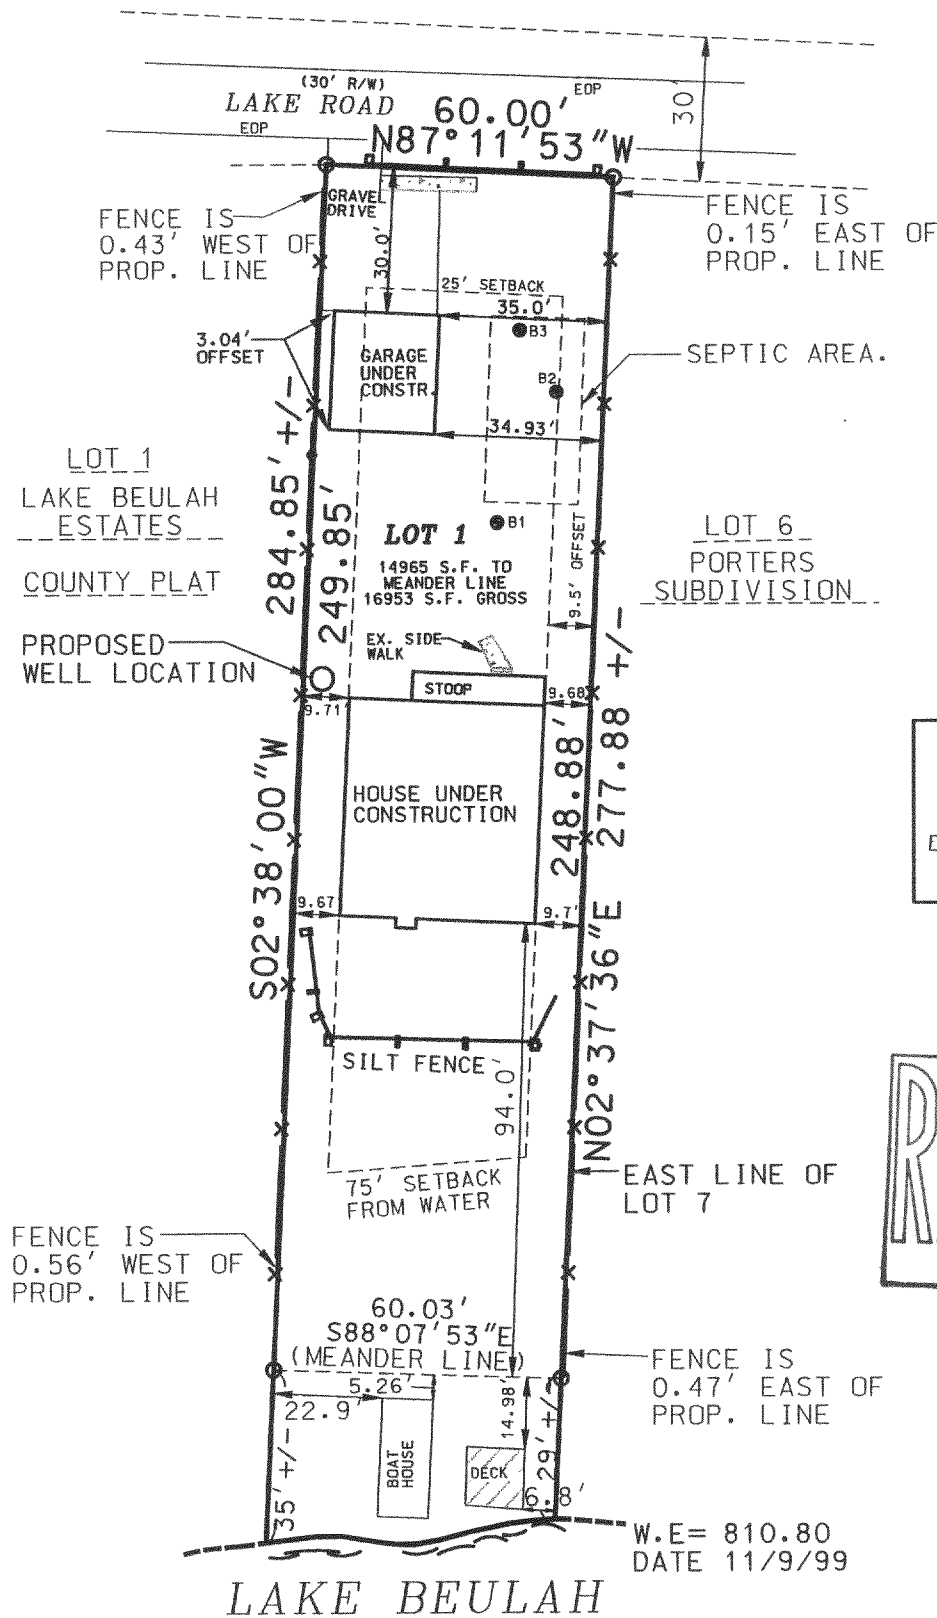

SCALE 1" = 40'

LEGEND

- IRON PIPE FOUND
- B1 ● SOIL BORING
- ▨ CONCRETE AREA

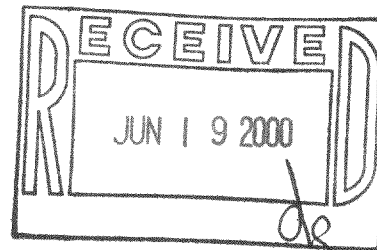


THE ABOVE MAP IS A TRUE REPRESENTATION THEREOF AND SHOWS THE SIZE AND LOCATION OF ALL THE PROPERTY, EXTERIOR BOUNDARIES, THE LOCATION OF ALL VISIBLE BOUNDARY FENCES, APPARENT EASEMENTS, ROADWAYS AND VISIBLE ENCROACHMENTS, IF ANY.

THIS SURVEY IS MADE FOR THE USE OF THE PRESENT OWNERS OF THE PROPERTY, AND ALSO THOSE WHO PURCHASE, MORTGAGE OR GUARANTEE TITLE THERETO WITHIN ONE (1) YEAR FROM DATE HERETO.

BRADFORD L. SPENCER, R.L.S. S-2069
RSV#99268SITE

THIS IS ORIGINAL
PRINT ONLY IF
SEAL IS IMPRINTED
IN RED

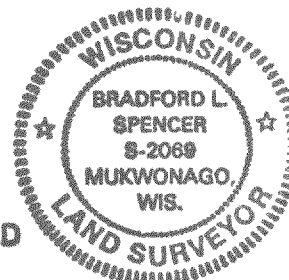

PLAT OF SURVEY



FOR:
DOUGLAS & KATHY NALBERT



DATE: 3/9/00


DESCRIPTION:

LOT 1 OF NALBERT SUBDIVISION, BEING LOT 7 OF PORTERS SUBDIVISION AND THE EAST 10' OF LOT 3 OF THE ORIGINAL STEVENS SUBDIVISION LOCATED IN GOVERNMENT LOT NO. 1 OF SECTION 8, TOWN 4 NORTH, RANGE 18 EAST, TOWN OF EAST TROY, WALWORTH COUNTY, WISCONSIN

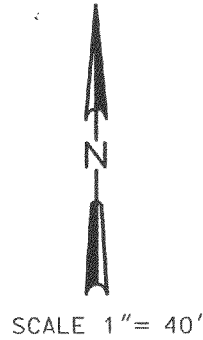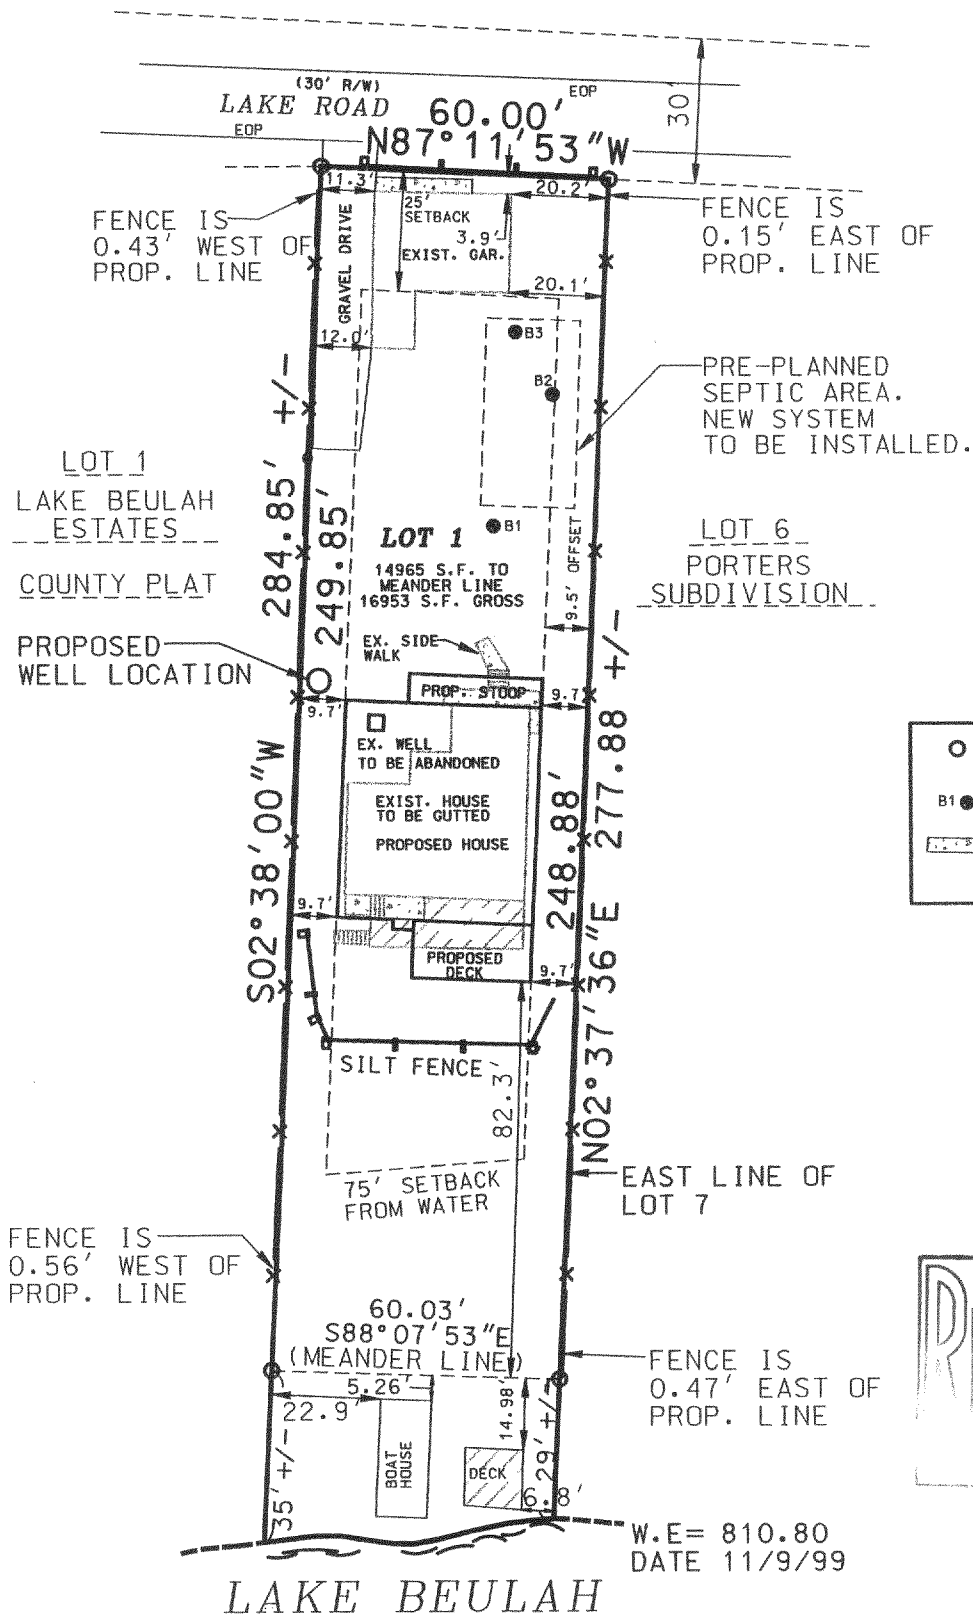

LEGEND

- IRON PIPE FOUND
- B1 ● SOIL BORING
- ▨ CONCRETE AREA

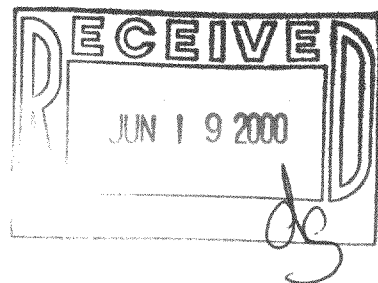


THE ABOVE MAP IS A TRUE REPRESENTATION THEREOF AND SHOWS THE SIZE AND LOCATION OF ALL THE PROPERTY, EXTERIOR BOUNDARIES, THE LOCATION OF ALL VISIBLE BOUNDARY FENCES, APPARENT EASEMENTS, ROADWAYS AND VISIBLE ENCROACHMENTS, IF ANY.

THIS SURVEY IS MADE FOR THE USE OF THE PRESENT OWNERS OF THE PROPERTY, AND ALSO THOSE WHO PURCHASE, MORTGAGE OR GUARANTEE TITLE THEREIN WITHIN ONE (1) YEAR FROM DATE HERETO.

BRADFORD L. SPENCER, R.L.S. S-2069
RSV#99268SITE

THIS IS ORIGINAL
PRINT ONLY IF
SEAL IS IMPRINTED
IN RED

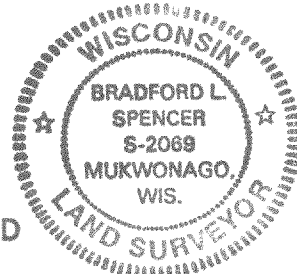

418-1394

FINAL-1 PPT-S + BT-1A