


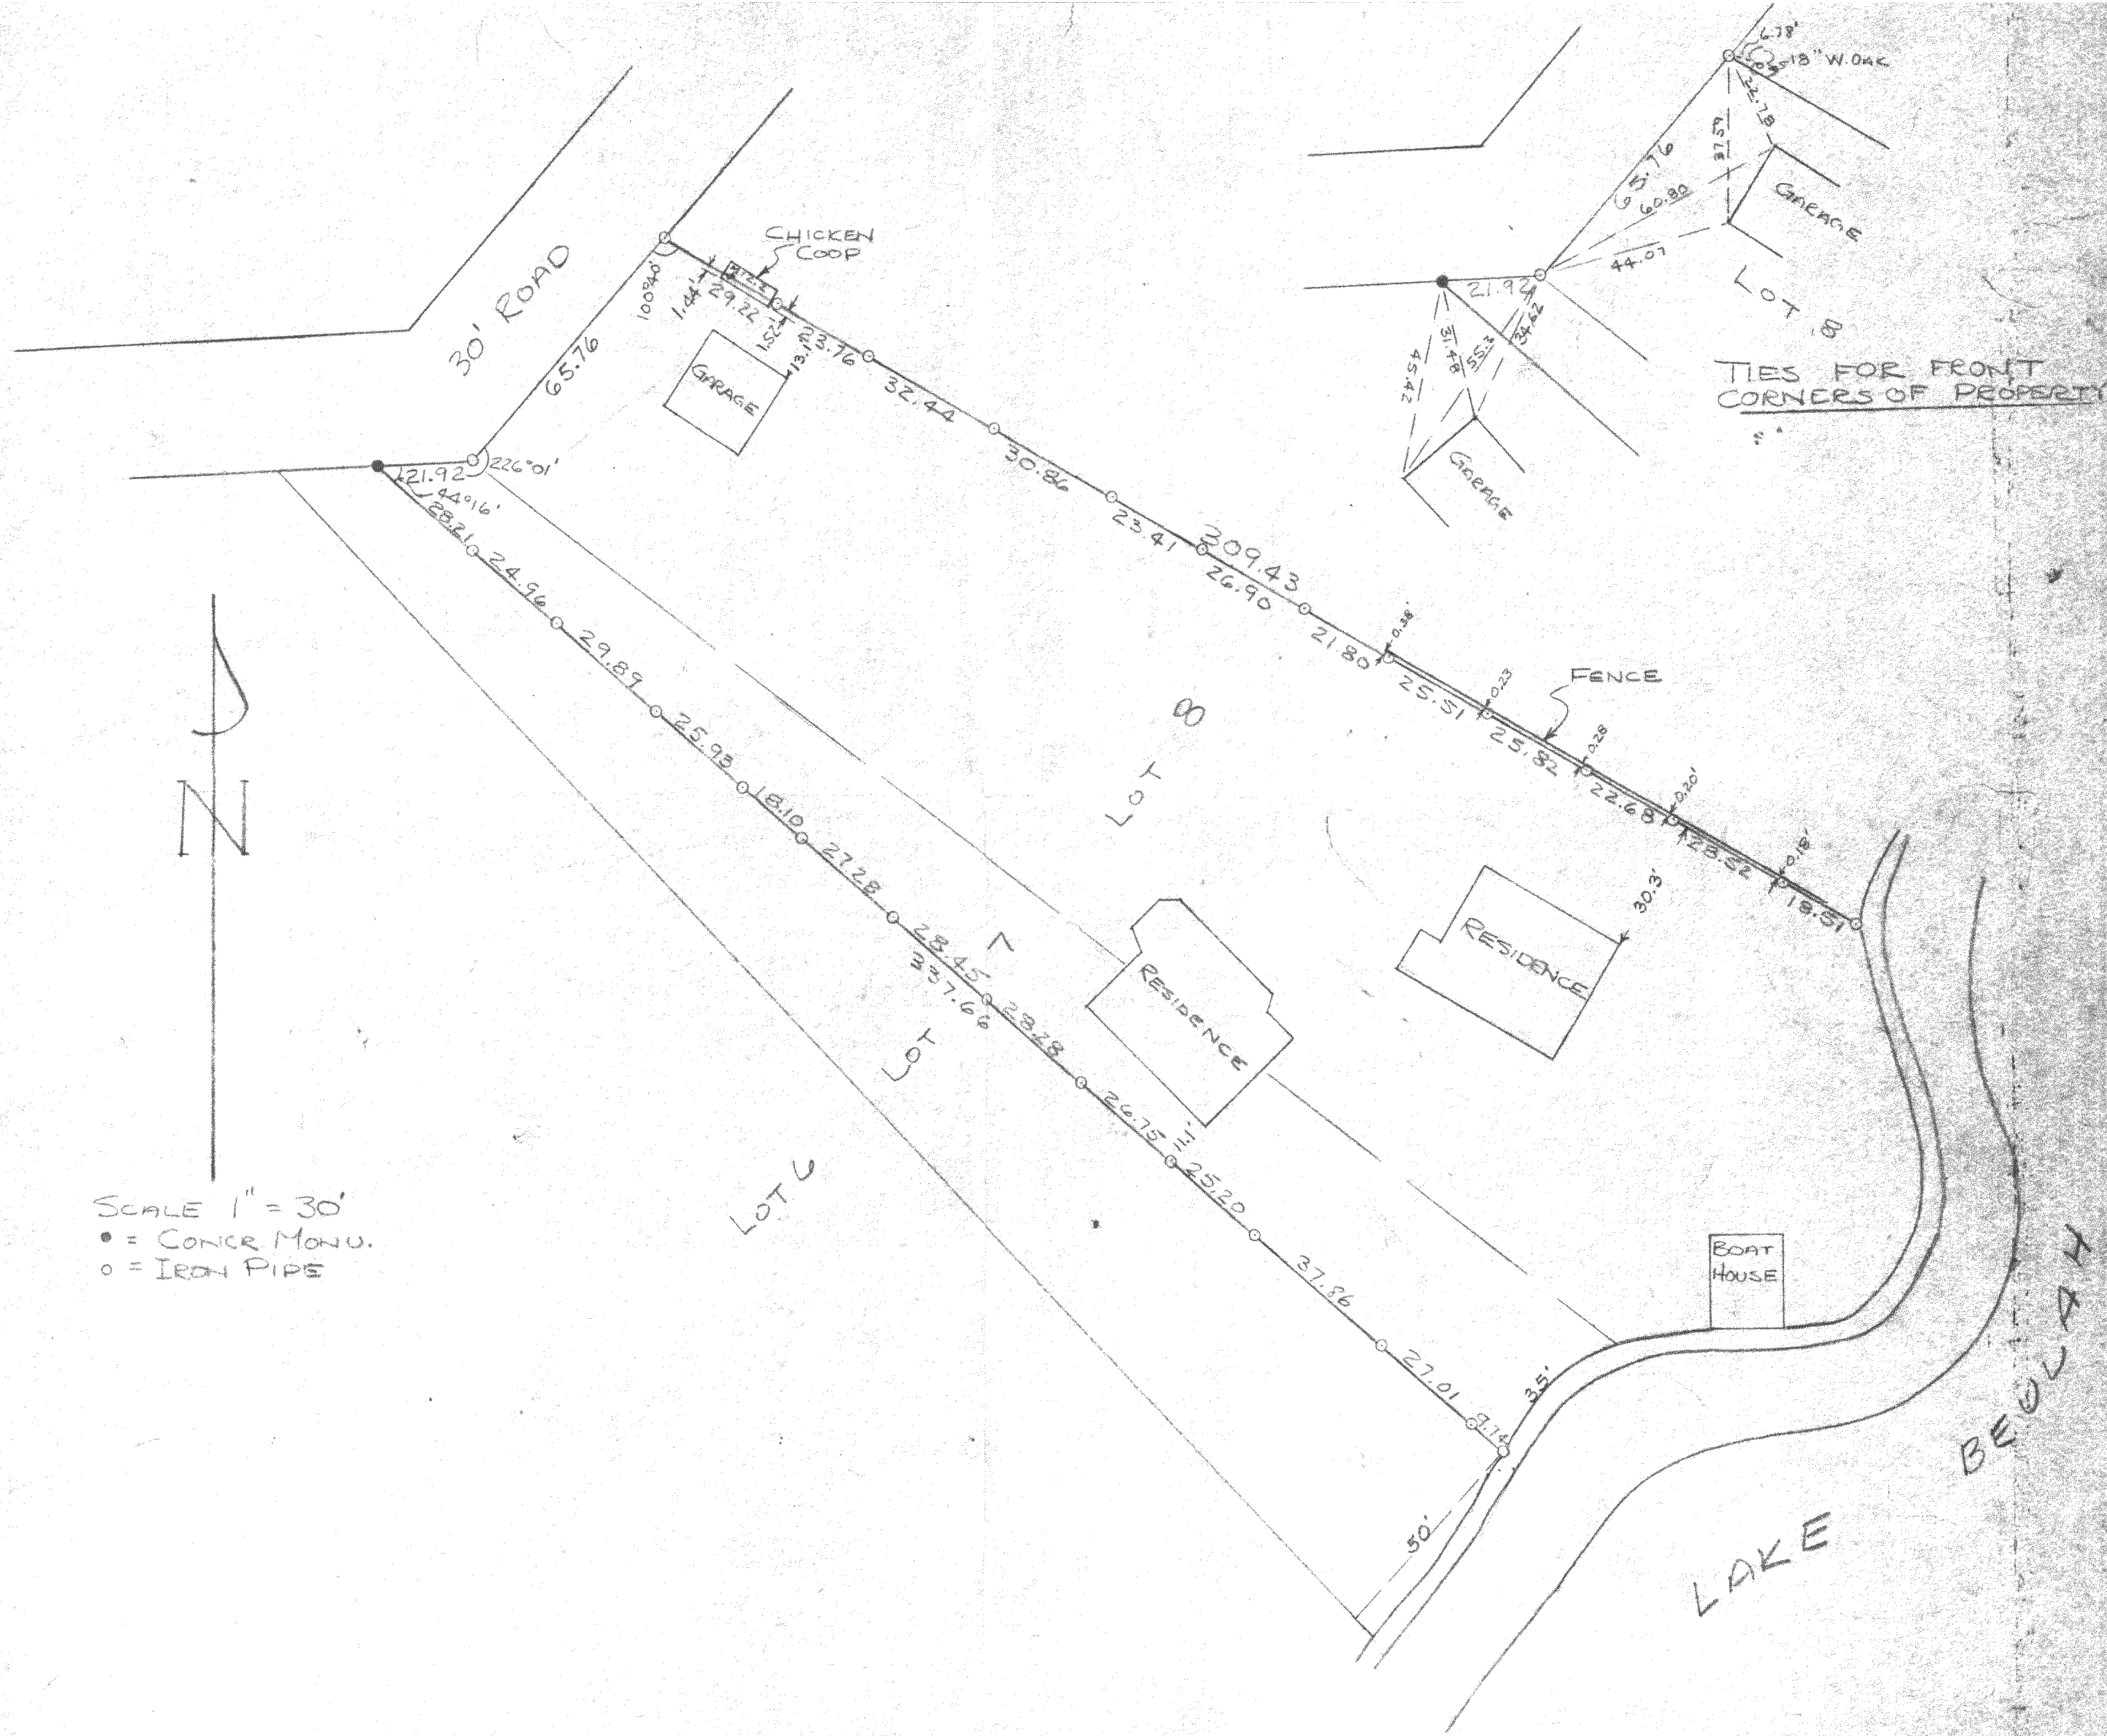

PLAT OF SURVEY OF LOT 8 AND PART OF
LOT 7 OF ROMADKA PARK LOCATED
IN SECTIONS 5 & 8 OF T4N R18E,
WALWORTH COUNTY, WISCONSIN.

Lloyd L. Jensen
COUNTY SURVEYOR

JULY, 1950

RP-8
11-9

418-140J