

PLAT OF SURVEY

RSV ENGINEERING, INC
ENGINEERS, PLANNERS, SURVEYORS
CONSTRUCTION MANAGERS
ENVIRONMENTAL SCIENTISTS
801 MAIN STREET, MUKWONAGO, WISCONSIN 53149 (262) 363-2004



LEGEND

- 1" IP ● FOUND IRON ROD OR IRON PIPE
- 1/2" R ○ 1"x24" IRON PIPE SET
- A ○ ANTENNA
- ST ○ SEPTIC TANK
- SV ○ SEPTIC VENT
- PK ▲ PK NAIL FOUND
- () RECORDED AS
- EDP EDGE OF PAVEMENT

DATE: 11/6/00

DESCRIPTION:


LOT 12 OF ISLAND CLUB,
LOCATED IN PART OF
SECTION 4, TOWN 4 NORTH,
RANGE 18 EAST, TOWN OF
EAST TROY, WALWORTH
COUNTY, WISCONSIN.

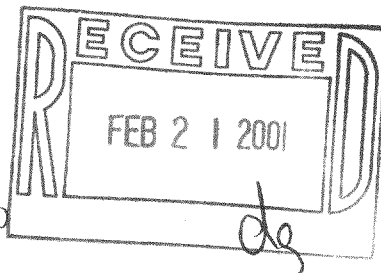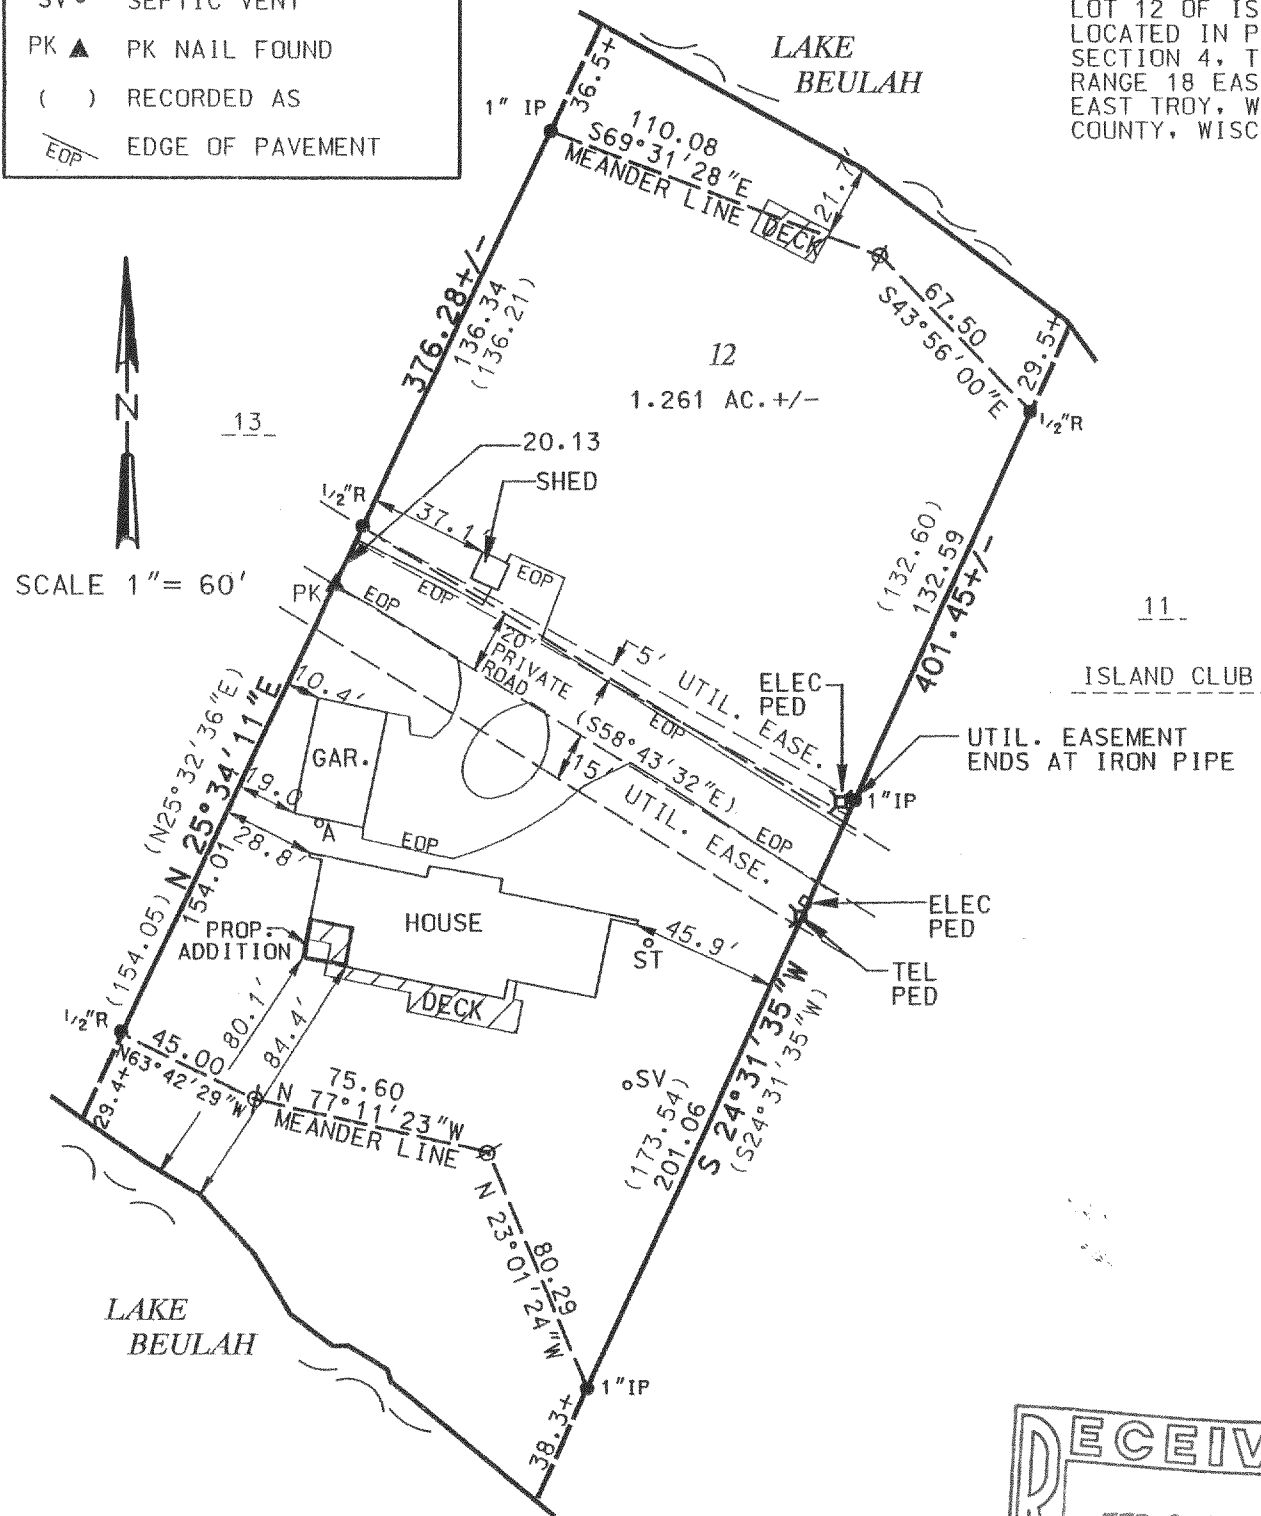

THE ABOVE MAP IS A TRUE REPRESENTATION THEREOF AND SHOWS THE SIZE AND LOCATION OF ALL THE PROPERTY, EXTERIOR BOUNDARIES, THE LOCATION OF ALL VISIBLE BOUNDARY FENCES, APPARENT EASEMENTS, ROADWAYS AND VISIBLE ENCROACHMENTS, IF ANY.

THIS SURVEY IS MADE FOR THE USE OF THE PRESENT OWNERS OF THE PROPERTY, AND ALSO THOSE WHO PURCHASE, MORTGAGE OR GUARANTEE TITLE THERETO WITHIN ONE (1) YEAR FROM DATE HERETO.

THIS IS ORIGINAL
PRINT ONLY IF
SEAL IS IMPRINTED
IN RED

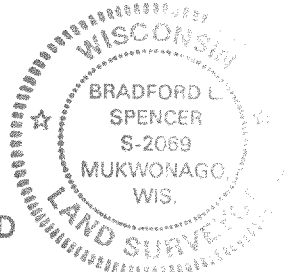

BRADFORD L. SPENCER, R.L.S. 2069
RSV#00224

418-1441

PI-12