


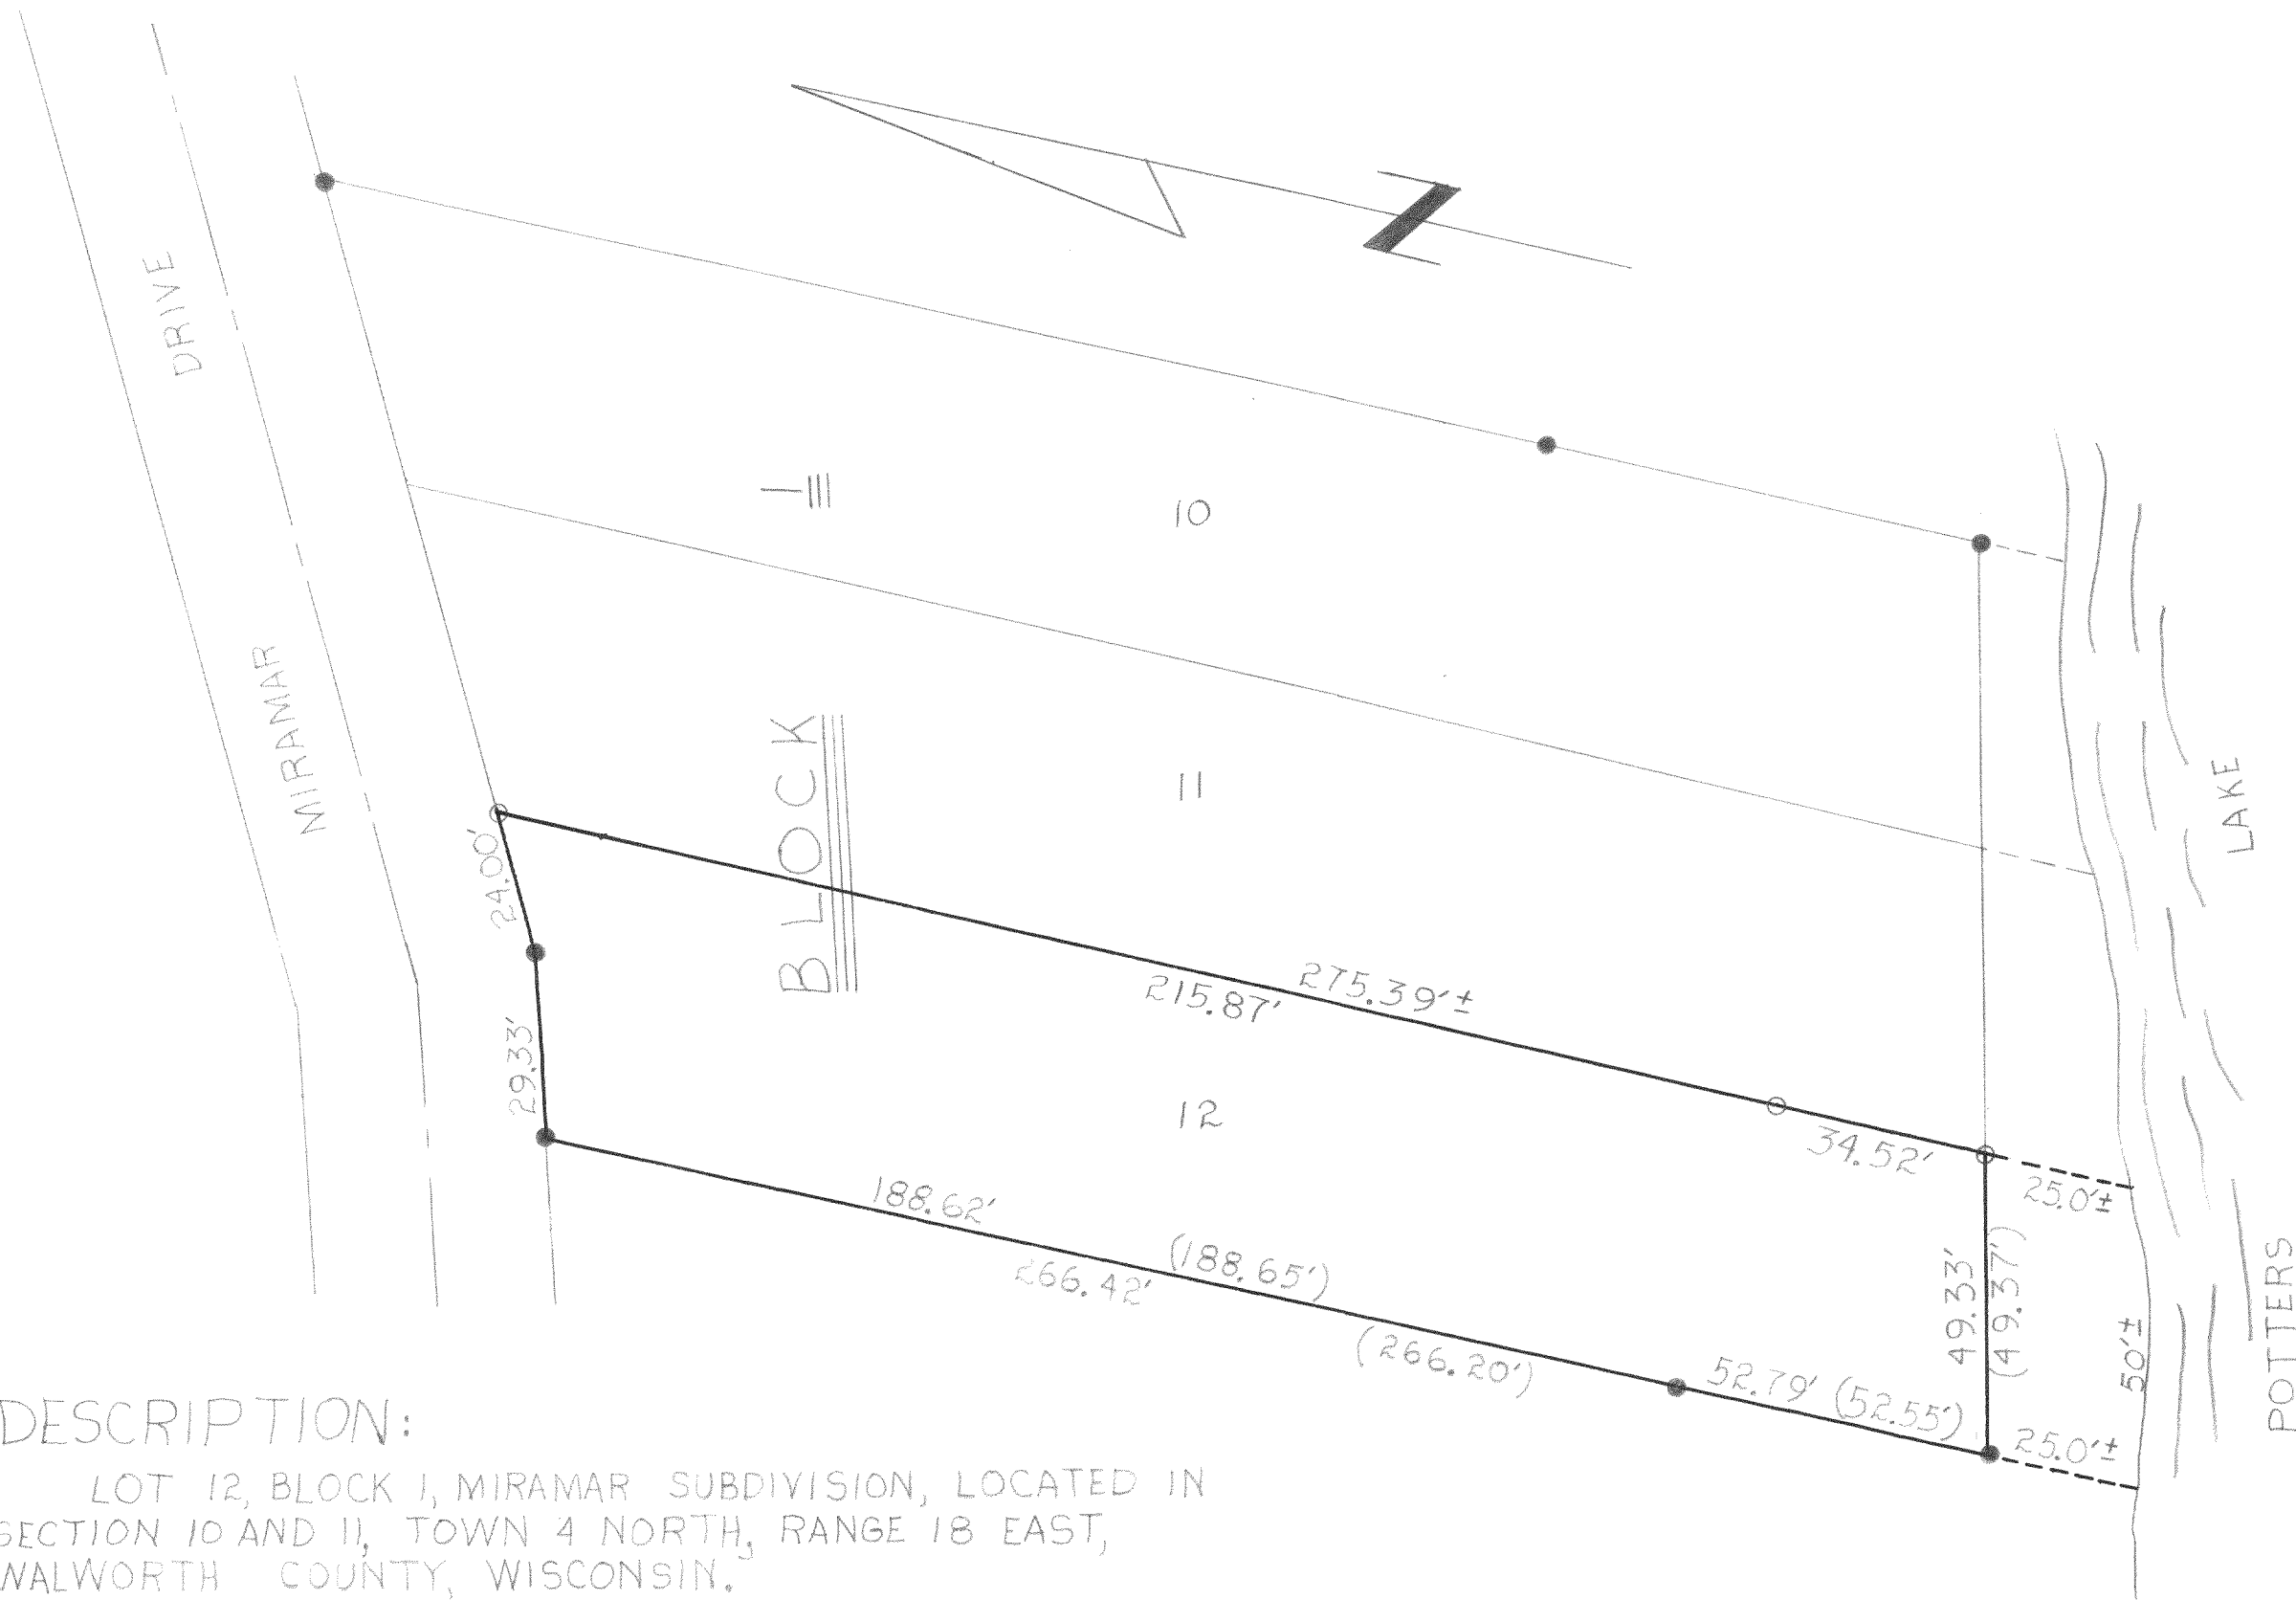

DESCRIPTION:


LOT 12, BLOCK 1, MIRAMAR SUBDIVISION, LOCATED IN SECTION 10 AND 11, TOWN 4 NORTH, RANGE 18 EAST, WALWORTH COUNTY, WISCONSIN.

CERTIFICATE:

I, JOSEPH M. BIAGI, SURVEYOR, DO HEREBY CERTIFY THAT I HAVE SURVEYED THE LANDS HEREON DESCRIBED.

JOSEPH M. BIAGI

R.L.S.#12

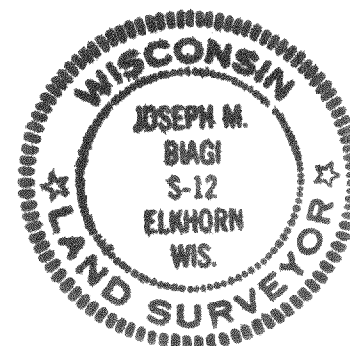

REVISIONS			JANIS JANSONS		
NO.	DATE	BY			
1			LOT 12, BLK. 1, MIRAMAR SUB.		
2			T.4N, R.18E. WALWORTH CTY. WIS.		
3			DRAWN BY HWG	SCALE 1"=30'	MATERIAL
4			CHK'D	DATE 9-26-75	DRAWING NO.
5			TRACED	APP'D	#95-75

DRIVE

MIRAMAR

BLOCK

10

11

12

LAKE

POTTERS

LEGEND

- IRON PIPE FOUND
- IRON PIPE SET
- () RECORDED AS

DATE: SEPTEMBER 26, 1975


DESCRIPTION:

LOT 12, BLOCK 1, MIRAMAR SUBDIVISION, LOCATED IN SECTION 10 AND 11, TOWN 4 NORTH, RANGE 18 EAST, WALWORTH COUNTY, WISCONSIN,

CERTIFICATE:

I, JOSEPH M. BIAGI, SURVEYOR, DO HEREBY CERTIFY THAT I HAVE SURVEYED THE LANDS HEREON DESCRIBED.

Joseph M. Biagi
JOSEPH M. BIAGI
R.S. 12

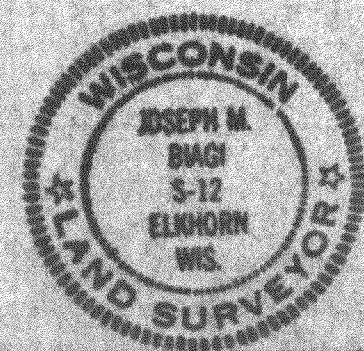

REVISIONS			JANIS JANSON'S		
NO.	DATE	BY	LOT 12, BLK. 1, MIRAMAR SUB.		
1			T4N. R. 18E. WALWORTH CTY. WIS.		
2			DRAWN BY	SCALE 1" = 30'	MATERIAL
3			CHK'D	DATE 9-26-75	DRAWING NO.
4			TRACED	APP'D	#95-75
5					

PMR-11

418-263