

# PLAT OF SURVEY

**PATHFINDER SURVEYING**  
FORMERLY KOLB LAND CONSULTING  
929 WILLIAMS STREET LAKE GENEVA, WI. 53147  
(262) 248-3697


ORDERED BY: MILL VALLEY HOMES  
P.O. BOX 114  
EAST TROY, WI 53120

DATE: 4-14-2000


DATE OF LAST REVISION 12 / 05 / 2000

DESCRIPTION: LOT 4 OF BLOCK 2 OF CLEARVIEW A SUBDIVISION LOCATED IN  
SECTION 18, TOWN 4 NORTH, RANGE 18 EAST, WALWORTH  
COUNTY, WISCONSIN.

*C.L. OAK RIDGE AVENUE (50') WIDE*

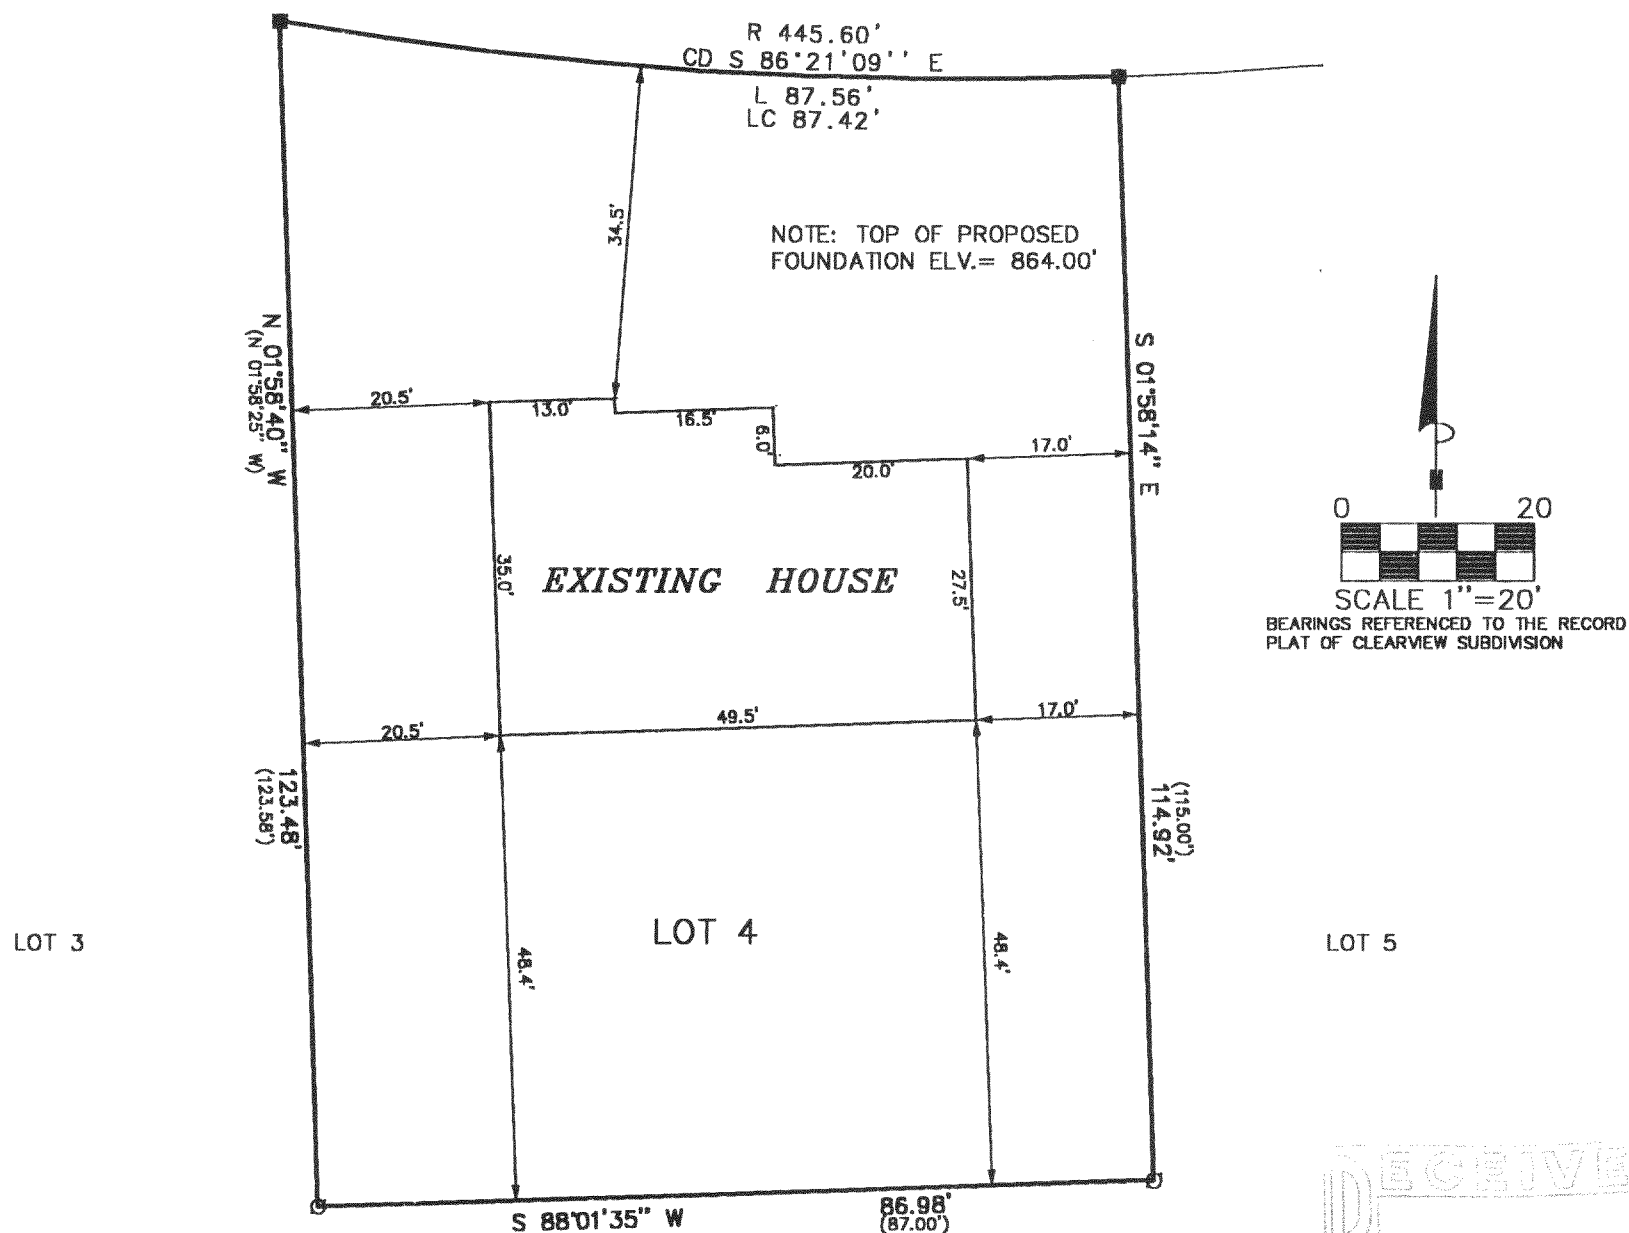

0 20  
SCALE 1"=20'  
BEARINGS REFERENCED TO THE RECORD  
PLAT OF CLEARVIEW SUBDIVISION

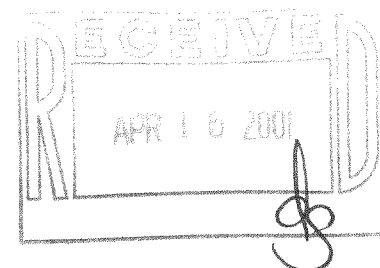

## LEGEND


- FOUND IRON PIPE
- FOUND IRON PIN

(XXXX) RECORDED AS

THE ABOVE MAP IS A TRUE REPRESENTATION THEREOF AND  
SHOWS THE SIZE AND LOCATION OF ALL THE PROPERTY,  
EXTERIOR BOUNDARIES, THE LOCATION OF ALL VISIBLE  
BOUNDARY FENCES, APPARENT EASEMENTS, ROADWAYS  
AND VISIBLE ENCROACHMENTS, IF ANY

THIS SURVEY IS MADE FOR THE USE OF THE PRESENT  
OWNERS OF THE PROPERTY, AND ALSO THOSE WHO  
PURCHASE, MORTGAGE OR GUARANTEE TITLE THERETO  
WITHIN ONE (1) YEAR FROM DATE HERETO.

*John P. Krott*  
JOHN P. KROTT, R.L.S. 2258

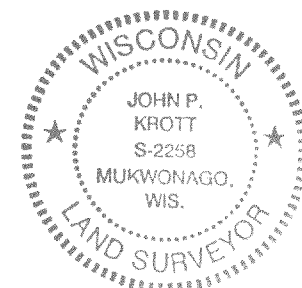

NOTE: THIS IS NOT A CERTIFIED COPY  
UNLESS SEAL IS IN RED.

JOB NUMBER #00054 4-18-PCV 00015

PCV-15

418-1465