


PLAT OF SURVEY

LOTS 28, 29, 30 AND 31 OF O-TON-KAH SUBDIVISION, according to the plat thereof recorded in Volume 8 of Plats pages 111 and 112, being located in the Town of East Troy, Walworth County, Wisconsin. Together with a right of way substantially as now traveled from the highway on the shores of Lake Beulah through the Hotel properties to O-Ton-Kah Subdivision according to the recorded plat thereof, and also a thoroughfare over a channel as now located from Lake Beulah to O-Ton-Kah Subdivision aforesaid said right of way and thoroughfare are hereby declared to be appurtenant to Lots 25, 26, 27, 28, 29, 30 and 31 of O-Ton-Kah Subdivision, and are to be used and maintained by the owner or owners of said Lots and the owners of all other Lots in O-Ton-Kah Subdivision and of other land abutting thereon. ALSO that certain piece or parcel of land located in O-Ton-Kah Subdivision in Town 4 North, Range 18 East, the recorded plat of which is on file in the Office of the Register of Deeds for Walworth County, Wisconsin, described as follows, to-wit: Commencing at the Northwest corner of Lot 26 of O-Ton-Kah Subdivision and extending the Northerly line of Lot 26 Southwesterly across the road to the place of beginning; thence Southwesterly on said extended Northerly line of Lot 26 to the edge of the channel; thence Southeasterly along the edge of the channel 25 feet; thence Northeasterly on a line parallel with the extended North line of lot 26 to the Southerly edge of the road abutting Lot 26; thence Northwesterly along the edge of the road to the point of beginning.

ALSO: That part of abandoned Terrace Drive as set forth in Resolution 98-4, recorded in Vol 657 page 4255 by the Town of East Troy.

Surveyed for: James Neitman

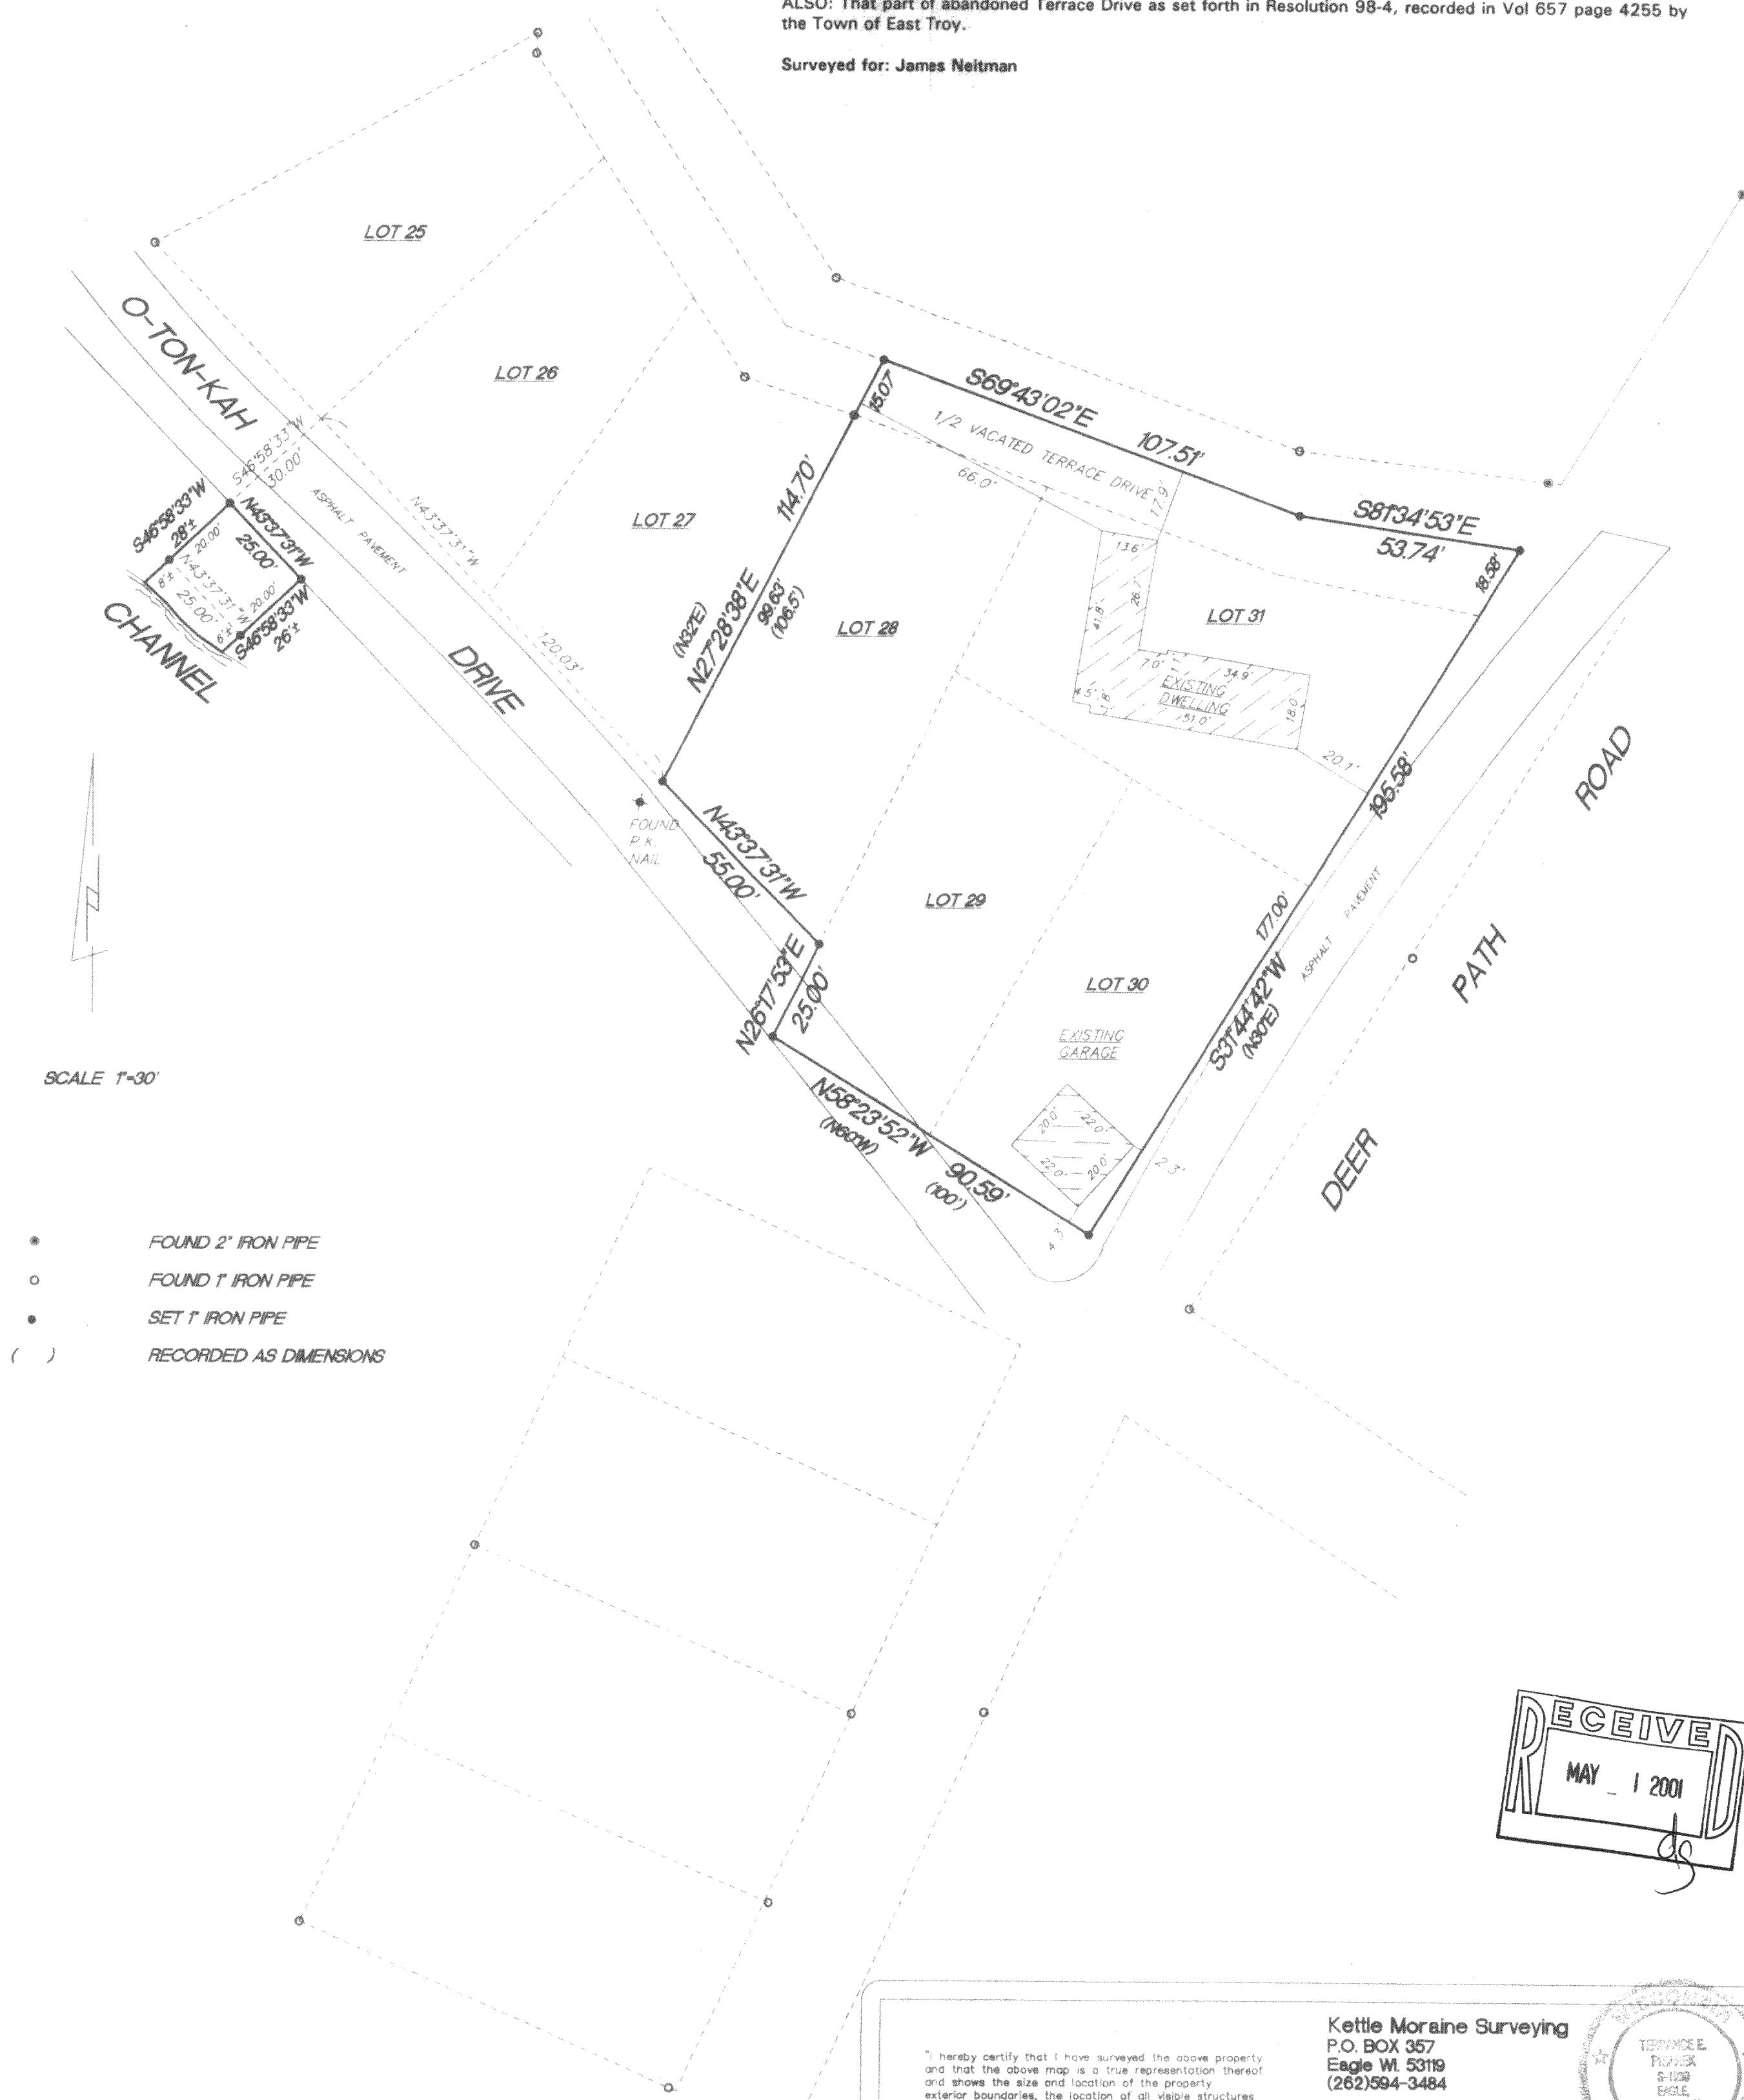

SCALE 1"=30'

* FOUND 2" IRON PIPE
 ○ FOUND 1" IRON PIPE
 • SET 1" IRON PIPE
 () RECORDED AS DIMENSIONS

RECEIVED
MAY 1 2001

I hereby certify that I have surveyed the above property and that the above map is a true representation thereof and shows the size and location of the property exterior boundaries, the location of all visible structures and dimensions of all principal buildings thereon, boundary fences, apparent easements, roadways and encroachments if any.

This survey is made for the use of the present owners of the property, and also those who purchase, mortgage or guarantee the title thereto within one year from date hereof.

Kettle Moraine Surveying
P.O. BOX 357
Eagle WI. 53119
(262)594-3484

TERENCE E. MORAN
REGISTERED
SURVEYOR
STATE OF WISCONSIN

THIS IS NOT AN ORIGINAL SURVEY UNLESS THE SEAL IS RED.

4/19/01 DATE TEP/DW FIELD WORK BY TEP DRAWN BY 01053-1 JOB NUMBER

418-1468
Pot-8