


PLAT OF SURVEY

LOCATION: Stringer Bridge Road, East Troy, Wisconsin


DESCRIPTION: Lot 2 of Certified Survey Map No. 3317, Being a part of the SE 1/4 of the the SW 1/4 of Section 7 and part of the NE 1/4 and NW 1/4 of the NW 1/4 of Section 18, Town 4 North, Range 18 East, Town of East Troy, Walworth County, Wisconsin

October 2, 2001

Survey No. 94006

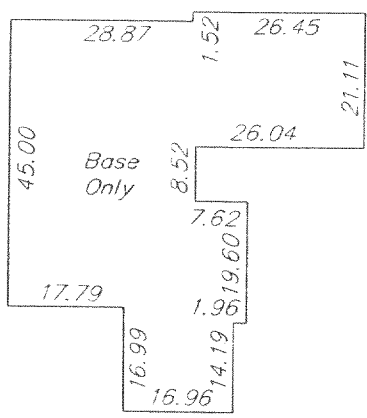


SCALE
1"=50'

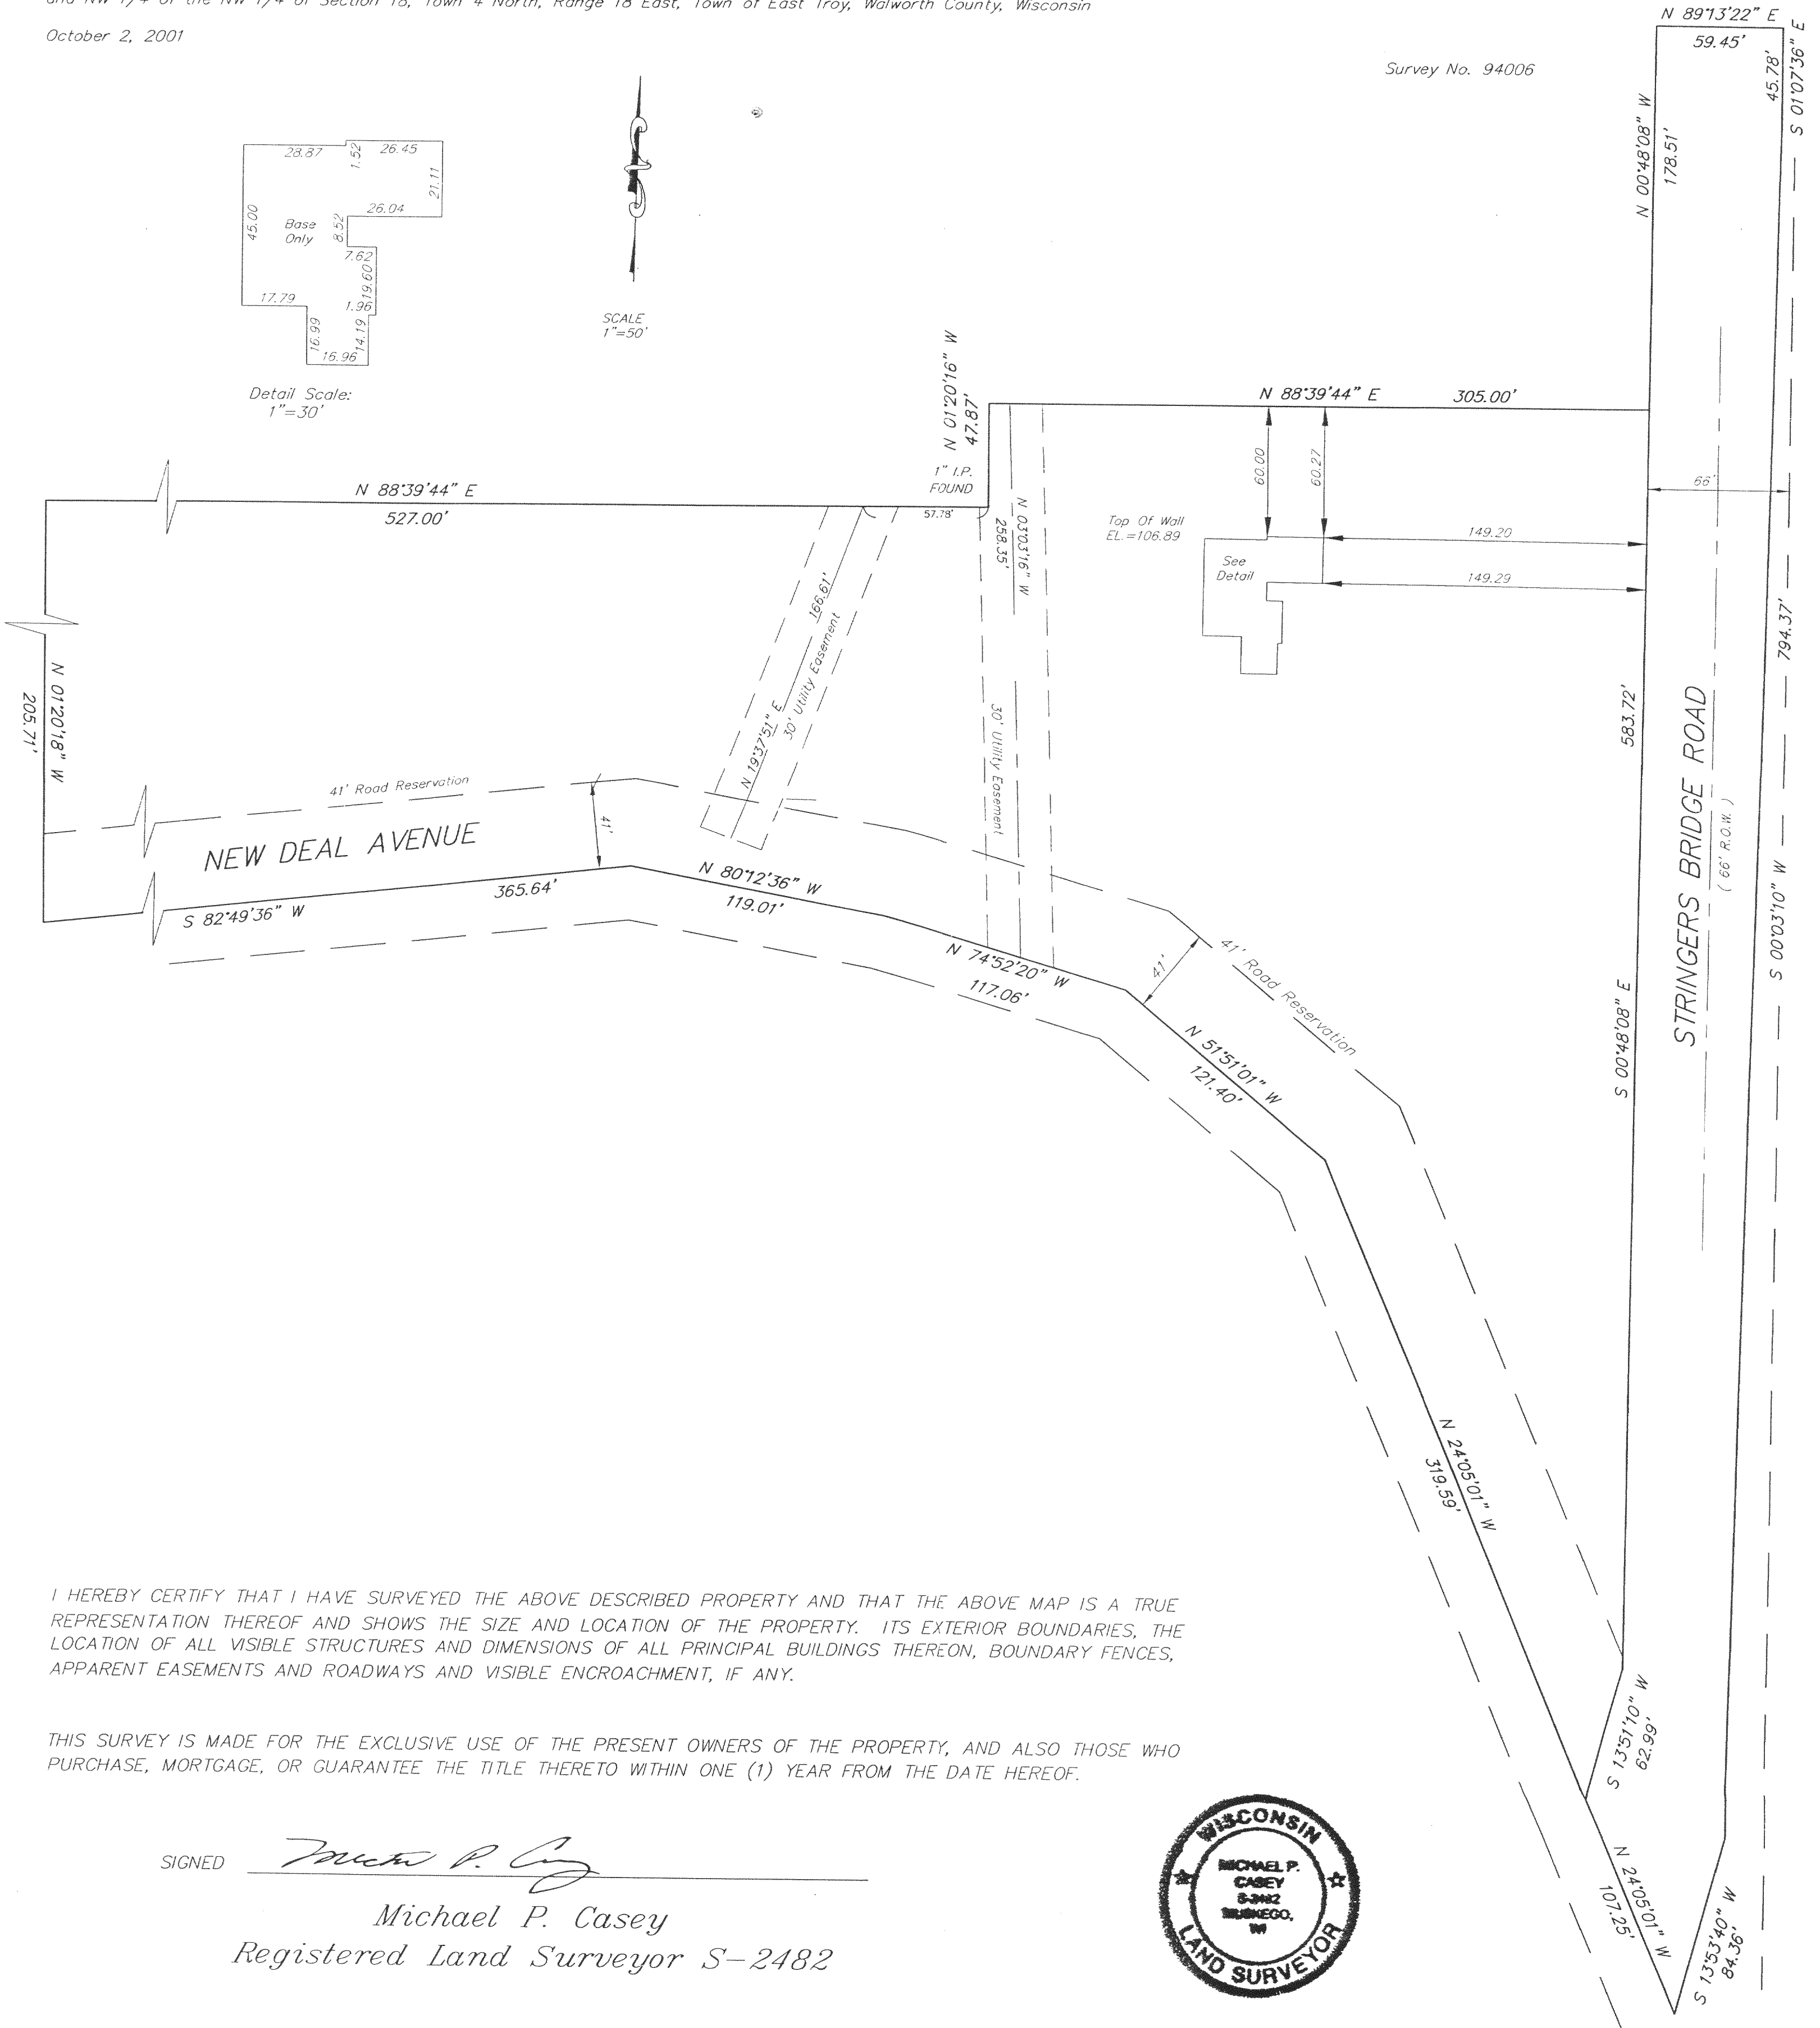

I HEREBY CERTIFY THAT I HAVE SURVEYED THE ABOVE DESCRIBED PROPERTY AND THAT THE ABOVE MAP IS A TRUE REPRESENTATION THEREOF AND SHOWS THE SIZE AND LOCATION OF THE PROPERTY. ITS EXTERIOR BOUNDARIES, THE LOCATION OF ALL VISIBLE STRUCTURES AND DIMENSIONS OF ALL PRINCIPAL BUILDINGS THEREON, BOUNDARY FENCES, APPARENT EASEMENTS AND ROADWAYS AND VISIBLE ENCROACHMENT, IF ANY.

THIS SURVEY IS MADE FOR THE EXCLUSIVE USE OF THE PRESENT OWNERS OF THE PROPERTY, AND ALSO THOSE WHO PURCHASE, MORTGAGE, OR GUARANTEE THE TITLE THERETO WITHIN ONE (1) YEAR FROM THE DATE HEREOF.

SIGNED Michael P. Casey
Michael P. Casey
Registered Land Surveyor S-2482

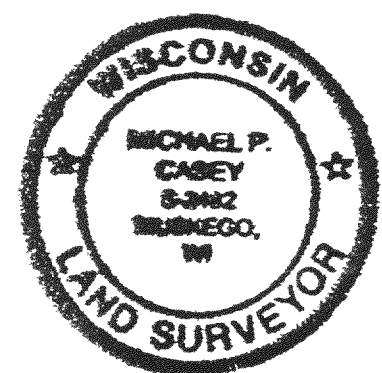

PA-3317-2

418-1488