

# PLAT OF SURVEY

**RSV**

ENGINEERING, INC.

Engineers • Land Surveyors • Environmental Scientists  
801 MAIN STREET MUKWONAGO, WISCONSIN 53149 (262)363-2004

FOR: ELAINE JACKSON


DATE: 10/30/01

DESCRIPTION: LOT 6 OF MIRAMAR ADDITION NO. 2, BEING A SUBDIVISION  
IN THE NE<sup>1</sup>/<sub>4</sub> OF SECTION 10 AND THE SW<sup>1</sup>/<sub>4</sub> OF SECTION 11, TOWNSHIP 4  
NORTH, RANGE 18 EAST, TOWN OF EAST TROY, WALWORTH COUNTY, WISCONSIN.

UNPLATTED LANDS.

## LEGEND

- $\frac{1}{2}$ " ●  $\frac{1}{2}$ " IRON PIPE FOUND
- Ø SET 1" IRON PIPE
- EOP EDGE OF PAVEMENT
- ( ) RECORDED AS


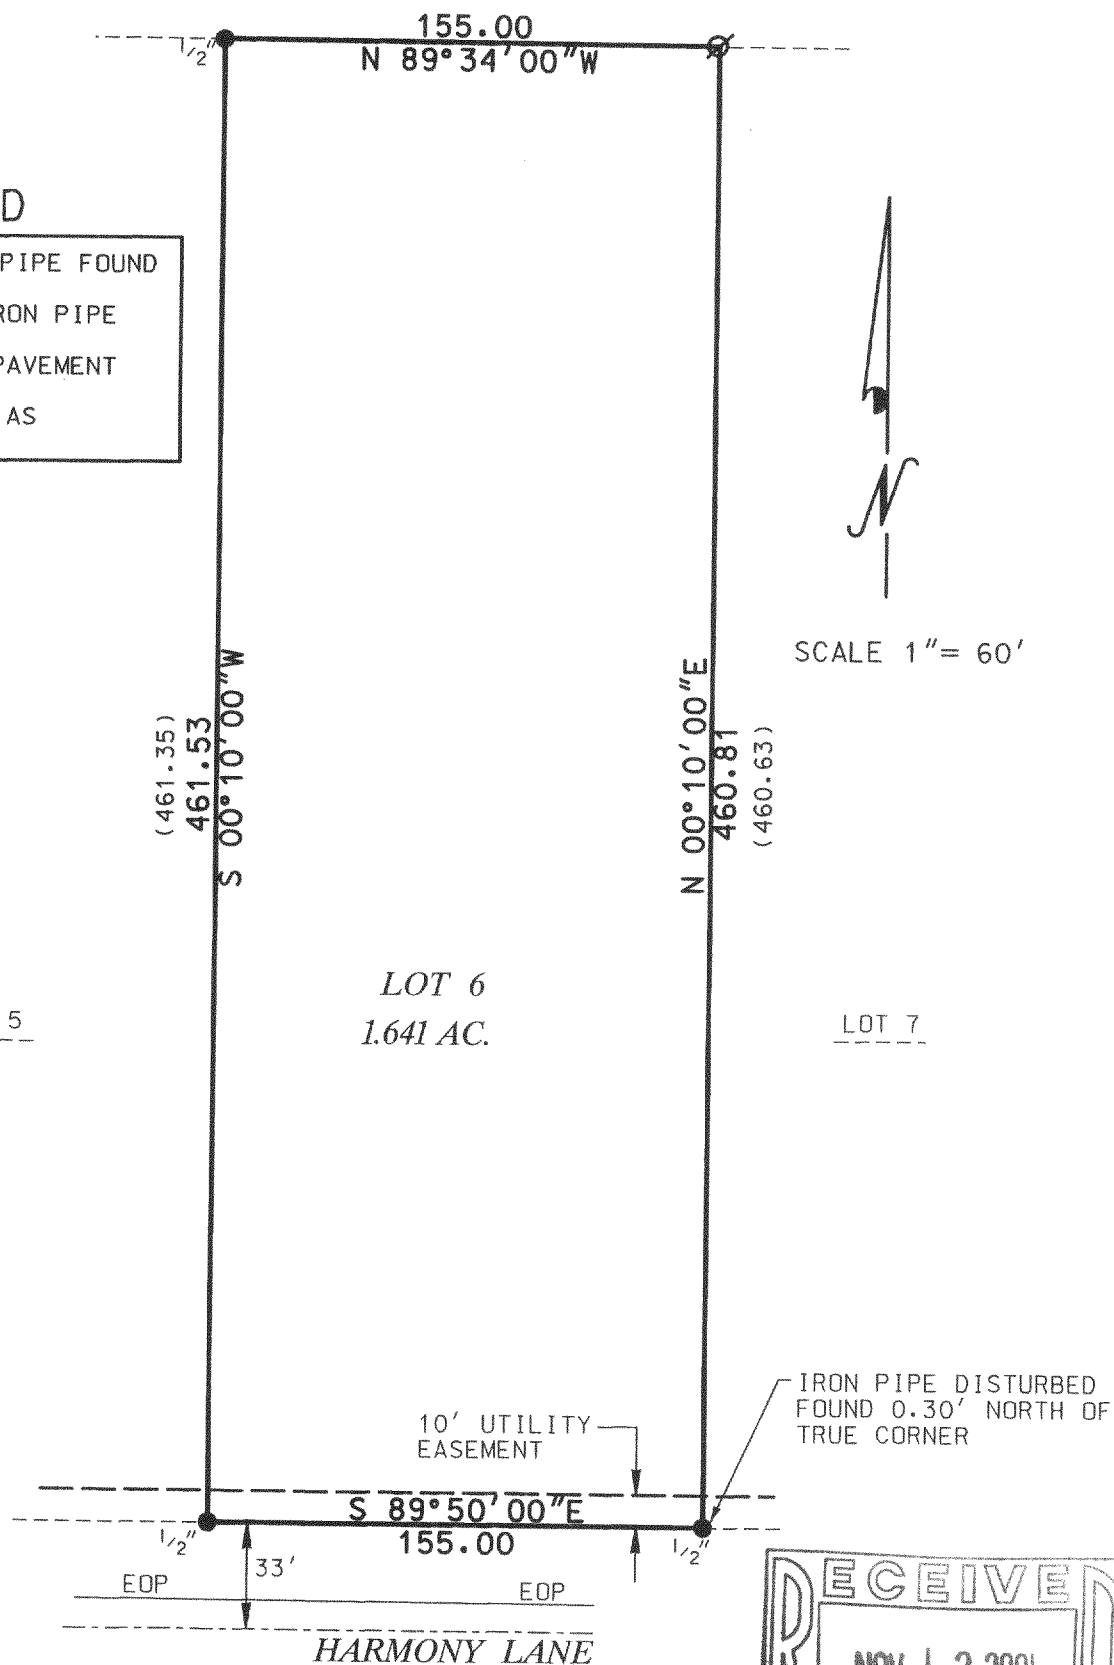


SCALE 1" = 60'

THE ABOVE MAP IS A TRUE REPRESENTATION THEREOF AND  
SHOWS THE SIZE AND LOCATION OF ALL THE PROPERTY,  
EXTERIOR BOUNDARIES, THE LOCATION OF ALL VISIBLE  
BOUNDARY FENCES, APPARENT EASEMENTS, ROADWAYS  
AND VISIBLE ENCROACHMENTS, IF ANY.

THIS SURVEY IS MADE FOR THE USE OF THE PRESENT  
OWNERS OF THE PROPERTY, AND ALSO THOSE WHO  
PURCHASE, MORTGAGE OR GUARANTEE TITLE THEREIN  
WITHIN ONE (1) YEAR FROM DATE HERETO.

THIS IS ORIGINAL  
PRINT ONLY IF  
SEAL IS IMPRINTED  
IN RED

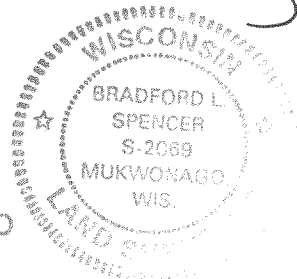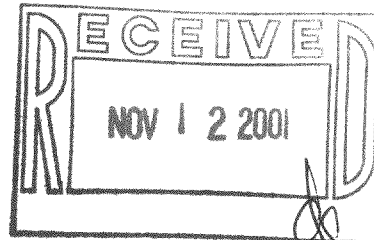

BRADFORD L. SPENCER, R.L.S., 2069  
RSV#01287

PMR2-6 ✓ 418-1505