


PLAT OF SURVEY

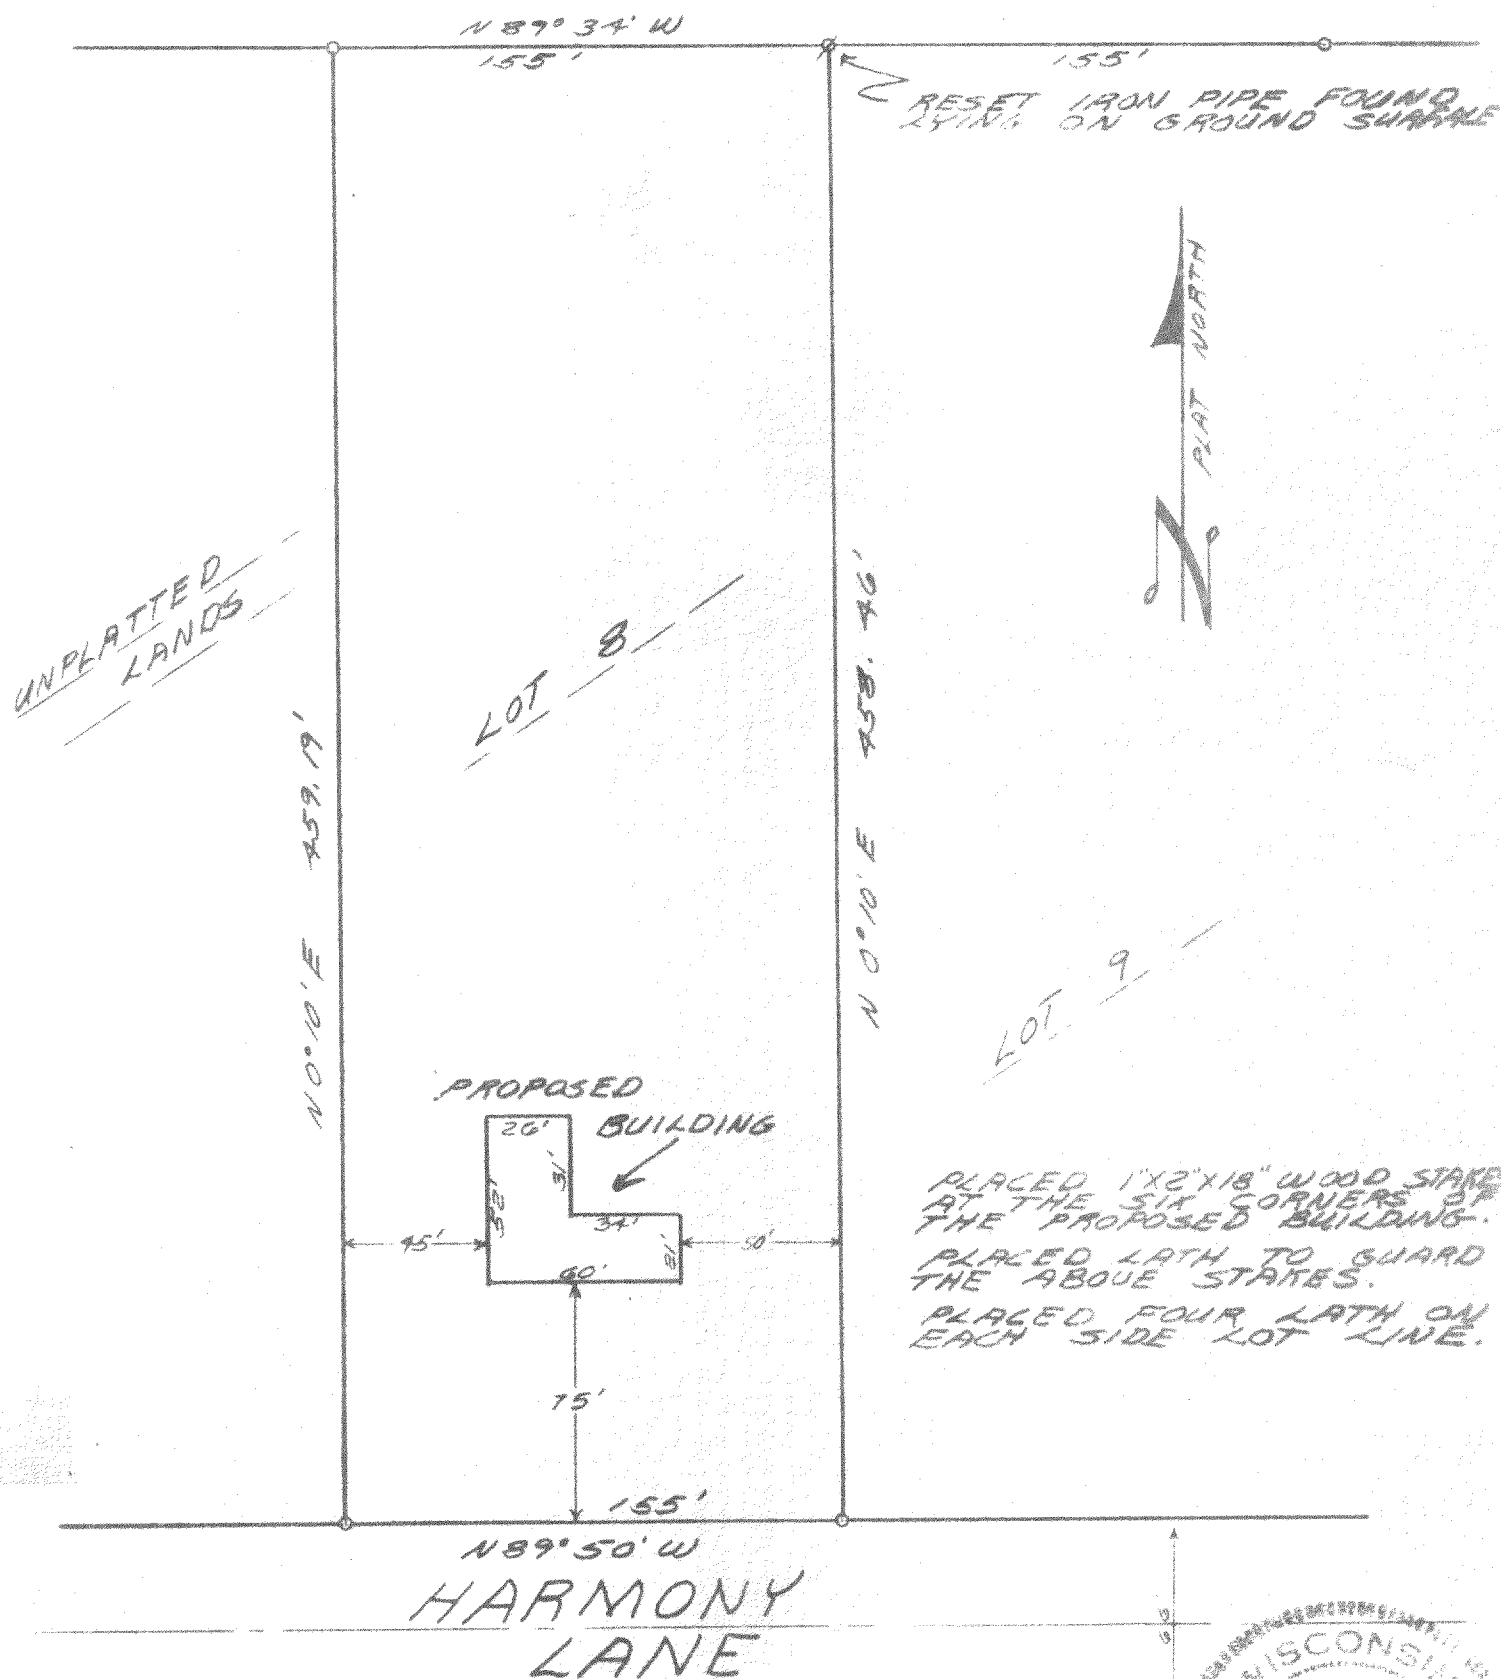

LOT 8, MIRAMAR ADD. NO 2
SEC. 10, T. 4 N., R. 18 E.

SURVEY AND PLAT BY

JENSEN & JOHNSON, INC.
CIVIL ENGINEERS AND SURVEYORS

Elkhorn, Wisconsin

LEGEND


- — Iron Pipe Found
- — Concrete Monument
- Scale 1" = 60'
- Iron Pipe Set

WE CERTIFY: That we have surveyed the above described property and that the plat shown hereon is an accurate survey and a true representation thereof and correctly shows the exterior boundary lines and all divisions of said property.

Date 27 MAR. 1972

Lloyd L. Jensen
LLOYD L. JENSEN,

Wisconsin Registered Land Surveyor, No. S-211

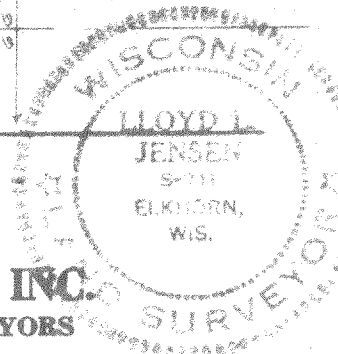

PMR 2-8

RAE, A.K.

418-150J