

Engineers • Land Surveyors • Environmental Scientists
801 MAIN STREET MUKWONAGO, WISCONSIN 53149 (262)363-2004



DATE: 1/14/02

LEGEND

	SET 1" IRON PIPE
	FENCE
SVO	SEPTIC VENT
	CONCRETE WALK
	EDGE OF PAVEMENT
P/L	PROPERTY LINE


SET SPIKE IN——
30" STUMP 4' +/-
ABOVE GROUND

SCALE 1" = 40'

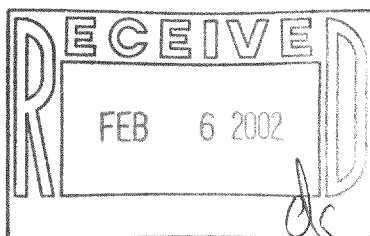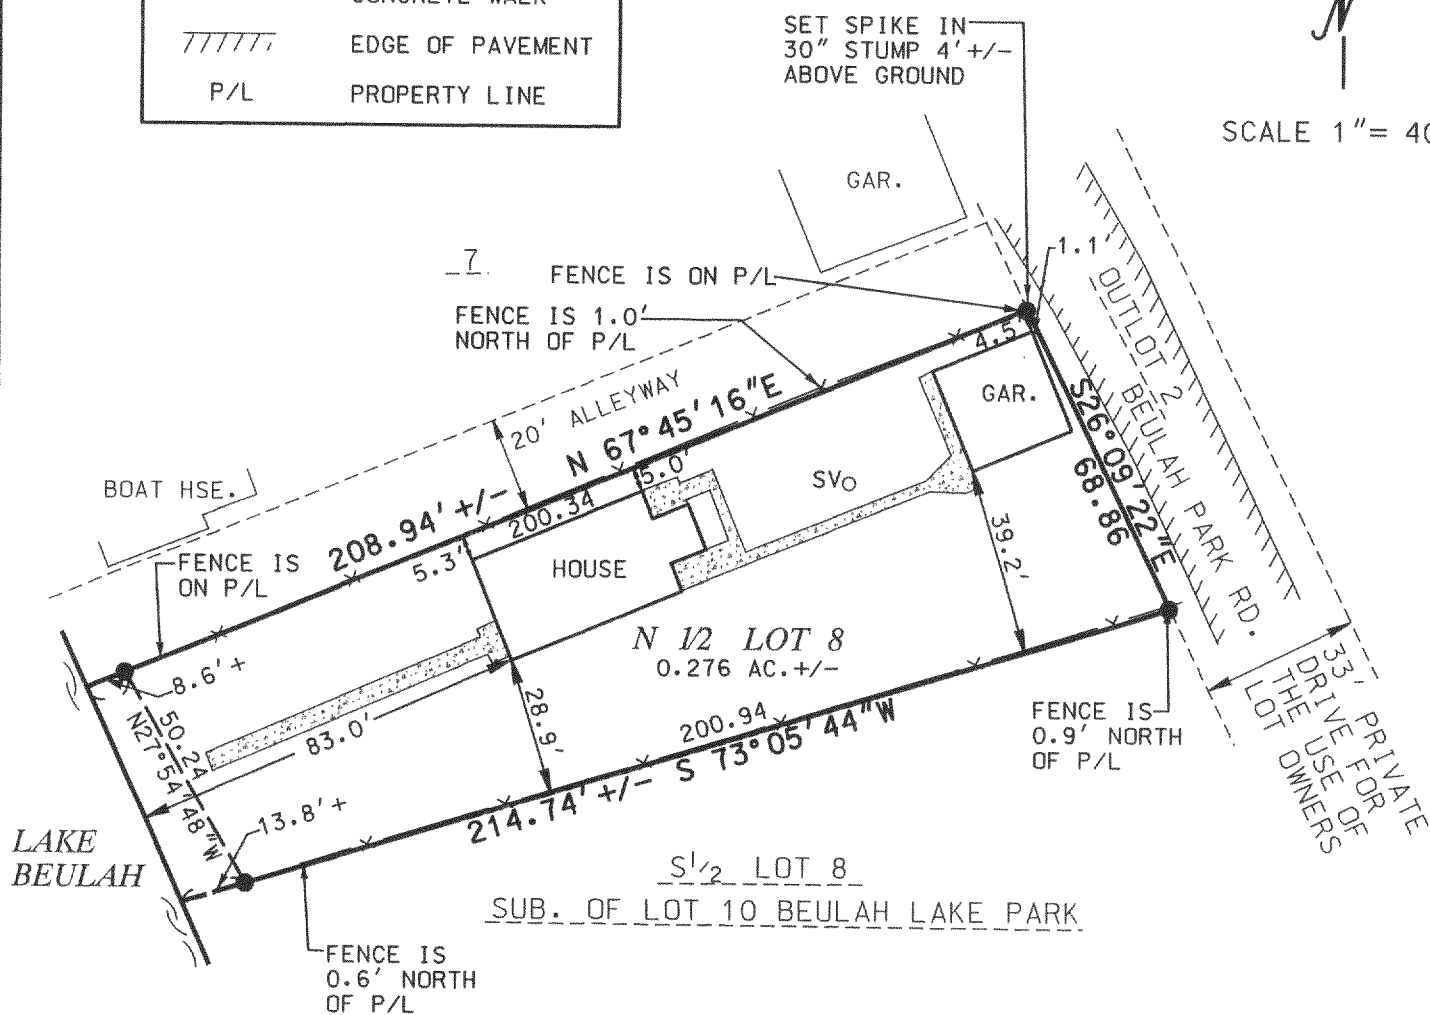

BRADFORD L. SPENCER, R.L.S. 2069
RSV#02002

THIS IS ORIGINAL
PRINT ONLY IF
SEAL IS IMPRINTED
IN RED

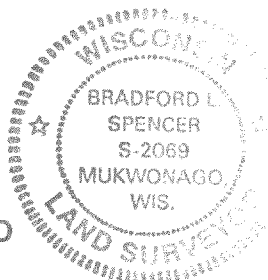

PBLA-8 ✓ 418-1525