
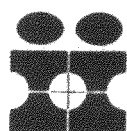
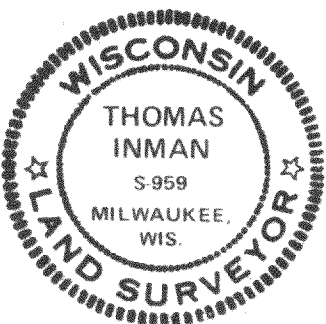


Plat of Survey

Survey For: **HEFFERNAN REALTY, INC.**
Location: **1416 Shorewood Drive**

Description: Lot 55, in SHOREWOOD, being a subdivision of part of the S.E. 1/4 of Section 10, the S.W. 1/4 of Section 11, the N.W. 1/4 of Section 14, and the N.E. 1/4 of Section 15, all in the Township numbered Four (4) North, Range 18 East, in the Town of East Troy, Walworth County, and State of Wisconsin.

Tax Key No. SW 55

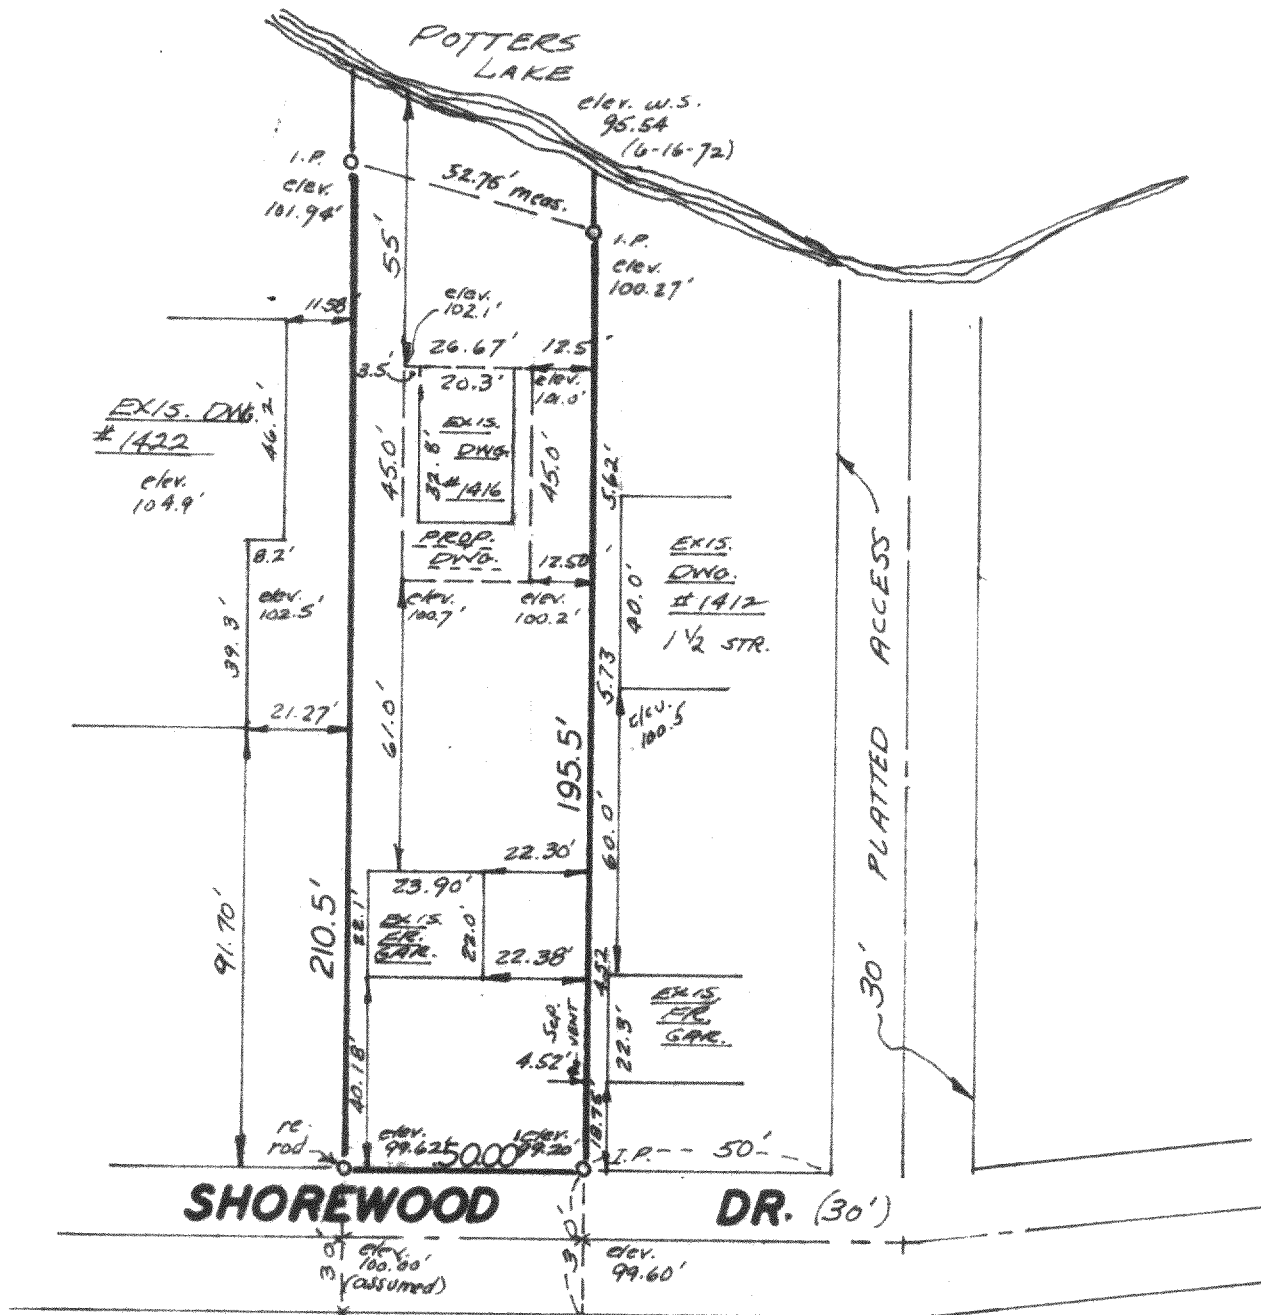

inman, inc.
ENGINEERS
SURVEYORS
LAND PLANNERS

Scale: 1" = 40'



State of Wisconsin) ss
Milwaukee County) I hereby certify that I have surveyed the above described property, that the above plat is a true representation thereof and correctly shows the exterior boundary lines, location of principal buildings and other visible improvements relative to said boundary lines.

Thomas Inman
Thomas Inman, Registered Land Surveyor

Date: 6/19/72
Job No: 5702

ps-53

418-154