

PLAT OF SURVEY

RSV
ENGINEERING, INC.


Engineers • Land Surveyors • Environmental Scientists
801 MAIN STREET MUKWONAGO, WISCONSIN 53149 (262)363-2004

FOR: TOM AND CHERYL BERG

DATE: 3/15/2002

DESCRIPTION:

LOTS 8, 9, AND 10 IN BLOCK 2 OF THE PLAT OF MIRAMAR SUBDIVISION,
WHICH SUBDIVISION IS LOCATED IN SECTIONS 10 AND 11, T4N, R18E,
OF WALWORTH COUNTY, WISCONSIN.

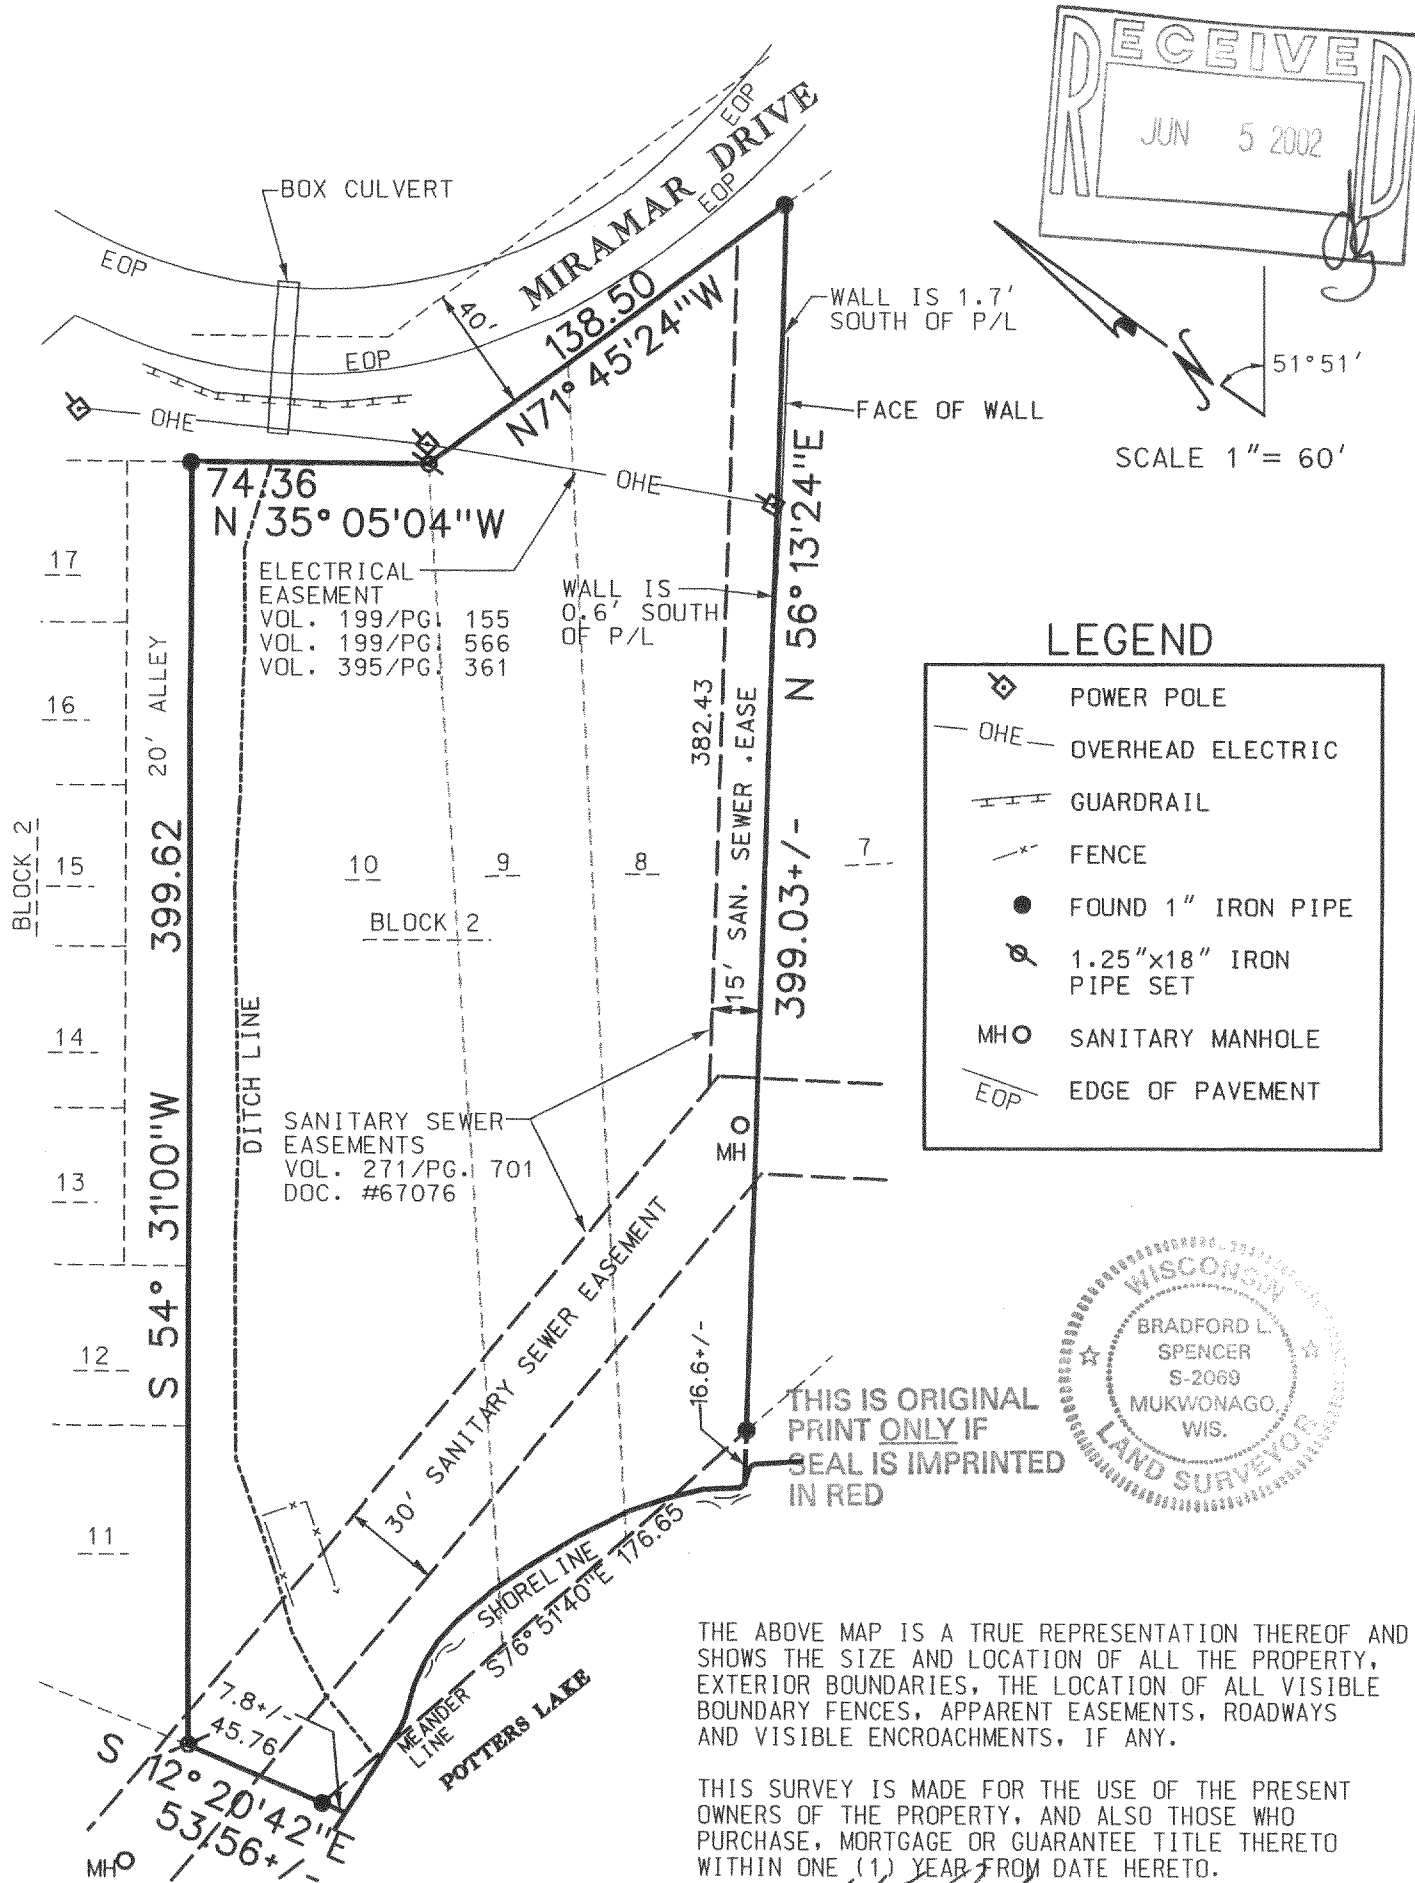

THE ABOVE MAP IS A TRUE REPRESENTATION THEREOF AND SHOWS THE SIZE AND LOCATION OF ALL THE PROPERTY, EXTERIOR BOUNDARIES, THE LOCATION OF ALL VISIBLE BOUNDARY FENCES, APPARENT EASEMENTS, ROADWAYS AND VISIBLE ENCROACHMENTS, IF ANY.

THIS SURVEY IS MADE FOR THE USE OF THE PRESENT OWNERS OF THE PROPERTY, AND ALSO THOSE WHO PURCHASE, MORTGAGE OR GUARANTEE TITLE THERETO WITHIN ONE (1) YEAR FROM DATE HERETO.

BRADFORD L. SPENCER, R.L.S. 2069
RSV#02022PLAT.DGN

PMR-32
418-1545