


MIRAMAR DRIVE

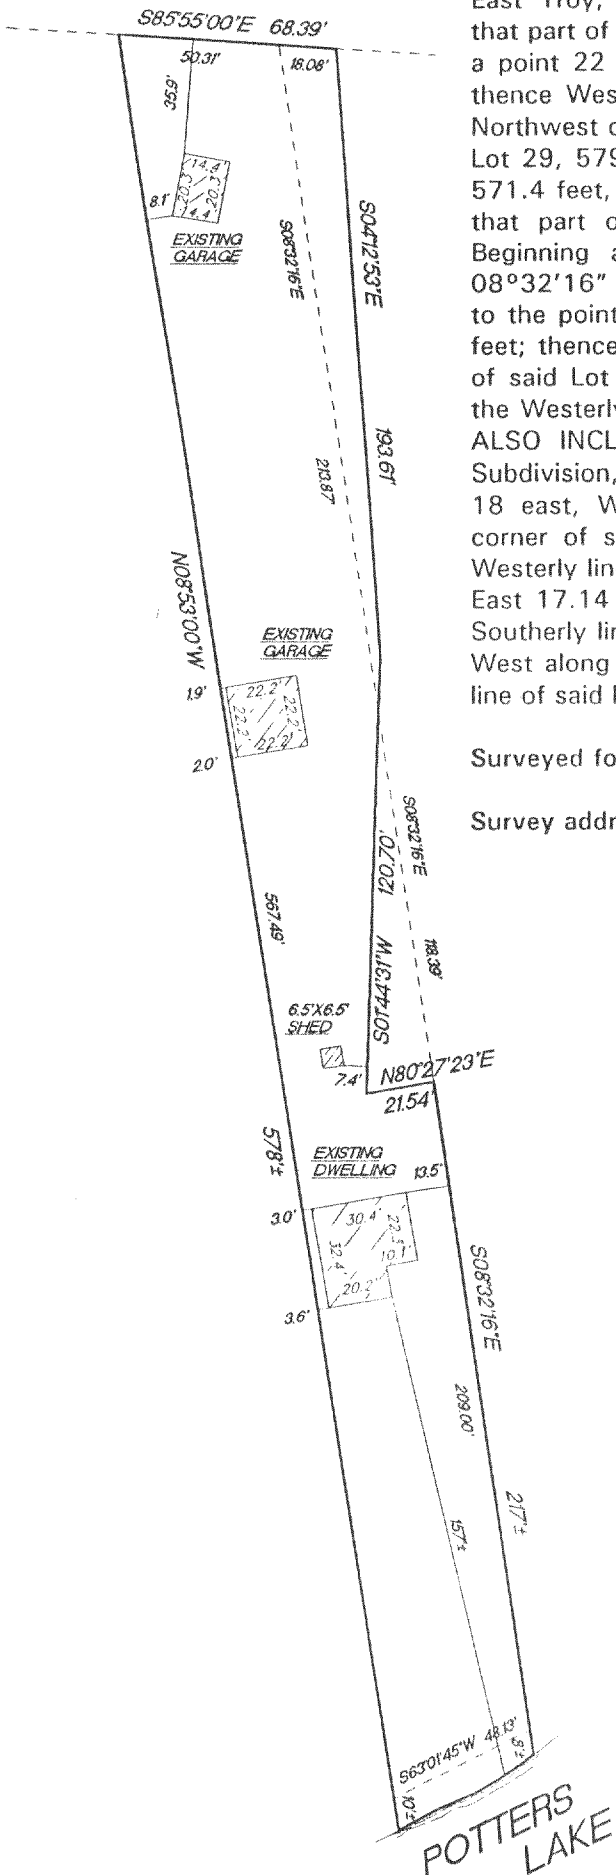


Plat of Survey

Lot 28, Block 1 in Miramar Subdivision, being a subdivision located in Sections 10 and 11, Town 4 North, Range 18 East, Town of East Troy, Walworth County, Wisconsin, EXCEPTING therefrom that part of Lot 29, bounded and described as follows: Beginning at a point 22 feet Easterly of the Northwest corner of said Lot 29; thence West along the North line of said Lot 29, 22 feet to the Northwest corner thereof; thence South along the West line of said Lot 29, 579.5 feet to the shore of Potters Lake; thence Northerly 571.4 feet, more or less, to the point of beginning, also excepting that part of said Lot 29, bounded and described as follows: Beginning at the Northwest corner of Lot 28; thence South 08°32'16\"/>

Surveyed for: Ron Jahnke

Survey address: W1015 Miramar Drive

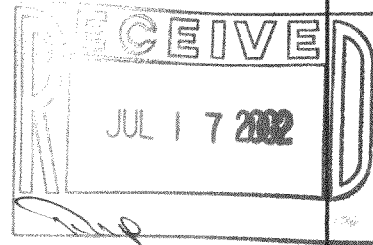


SCALE 1\"/>

MONUMENTATION AND LOCATION OF FENCES WAS WAIVED BY CLIENT IN ACCORDANCE WITH A-7.0(2) OF THE WISCONSIN ADMINISTRATIVE CODE.

"I hereby certify that I have surveyed the above described property and that the above map is a true representation thereof and shows the size and location of the property, its exterior boundaries, the location of all visible structures and dimension of all principal buildings thereon, boundary fences, apparent easements, roadways and encroachments if any."

"This survey is made for the use of the present owners of the property, and also those who purchase, mortgage or guarantee the title thereto within one year from date hereof."

KETTLE MORaine SURVEYING INC.
W356 S9050 Godfrey Lane
Eagle Wisconsin 53119
P.O. Box 357
(262) 594-3484
Terrance E. Pisarek R.L.S.

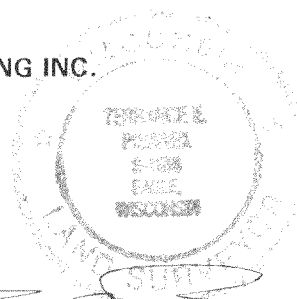

THIS IS NOT AN ORIGINAL SURVEY UNLESS THE SEAL IS RED.

6/15/02

DATE

TEP/DW

FIELD WORK BY

TEP

DRAWN BY

02078

JOB NUMBER

PMB-21

418-1549