

# PLAT OF SURVEY


THE RSV

**ENGINEERING, INC.**  
Engineers • Land Surveyors • Environmental Scientists  
801 MAIN STREET MUKWONAGO, WISCONSIN 53149 (262)363-2004

FOR: HACKBARTH BUILDERS

DATE: 6-12-02

DESCRIPTION: LOT 137 OF BEULAH HEIGHTS, BEING A SUBDIVISION OF A PART OF  
SECTIONS 7, 8, 17 AND 18 OF TOWN 4 NORTH, RANGE 18 EAST, WALWORTH COUNTY,  
WISCONSIN.

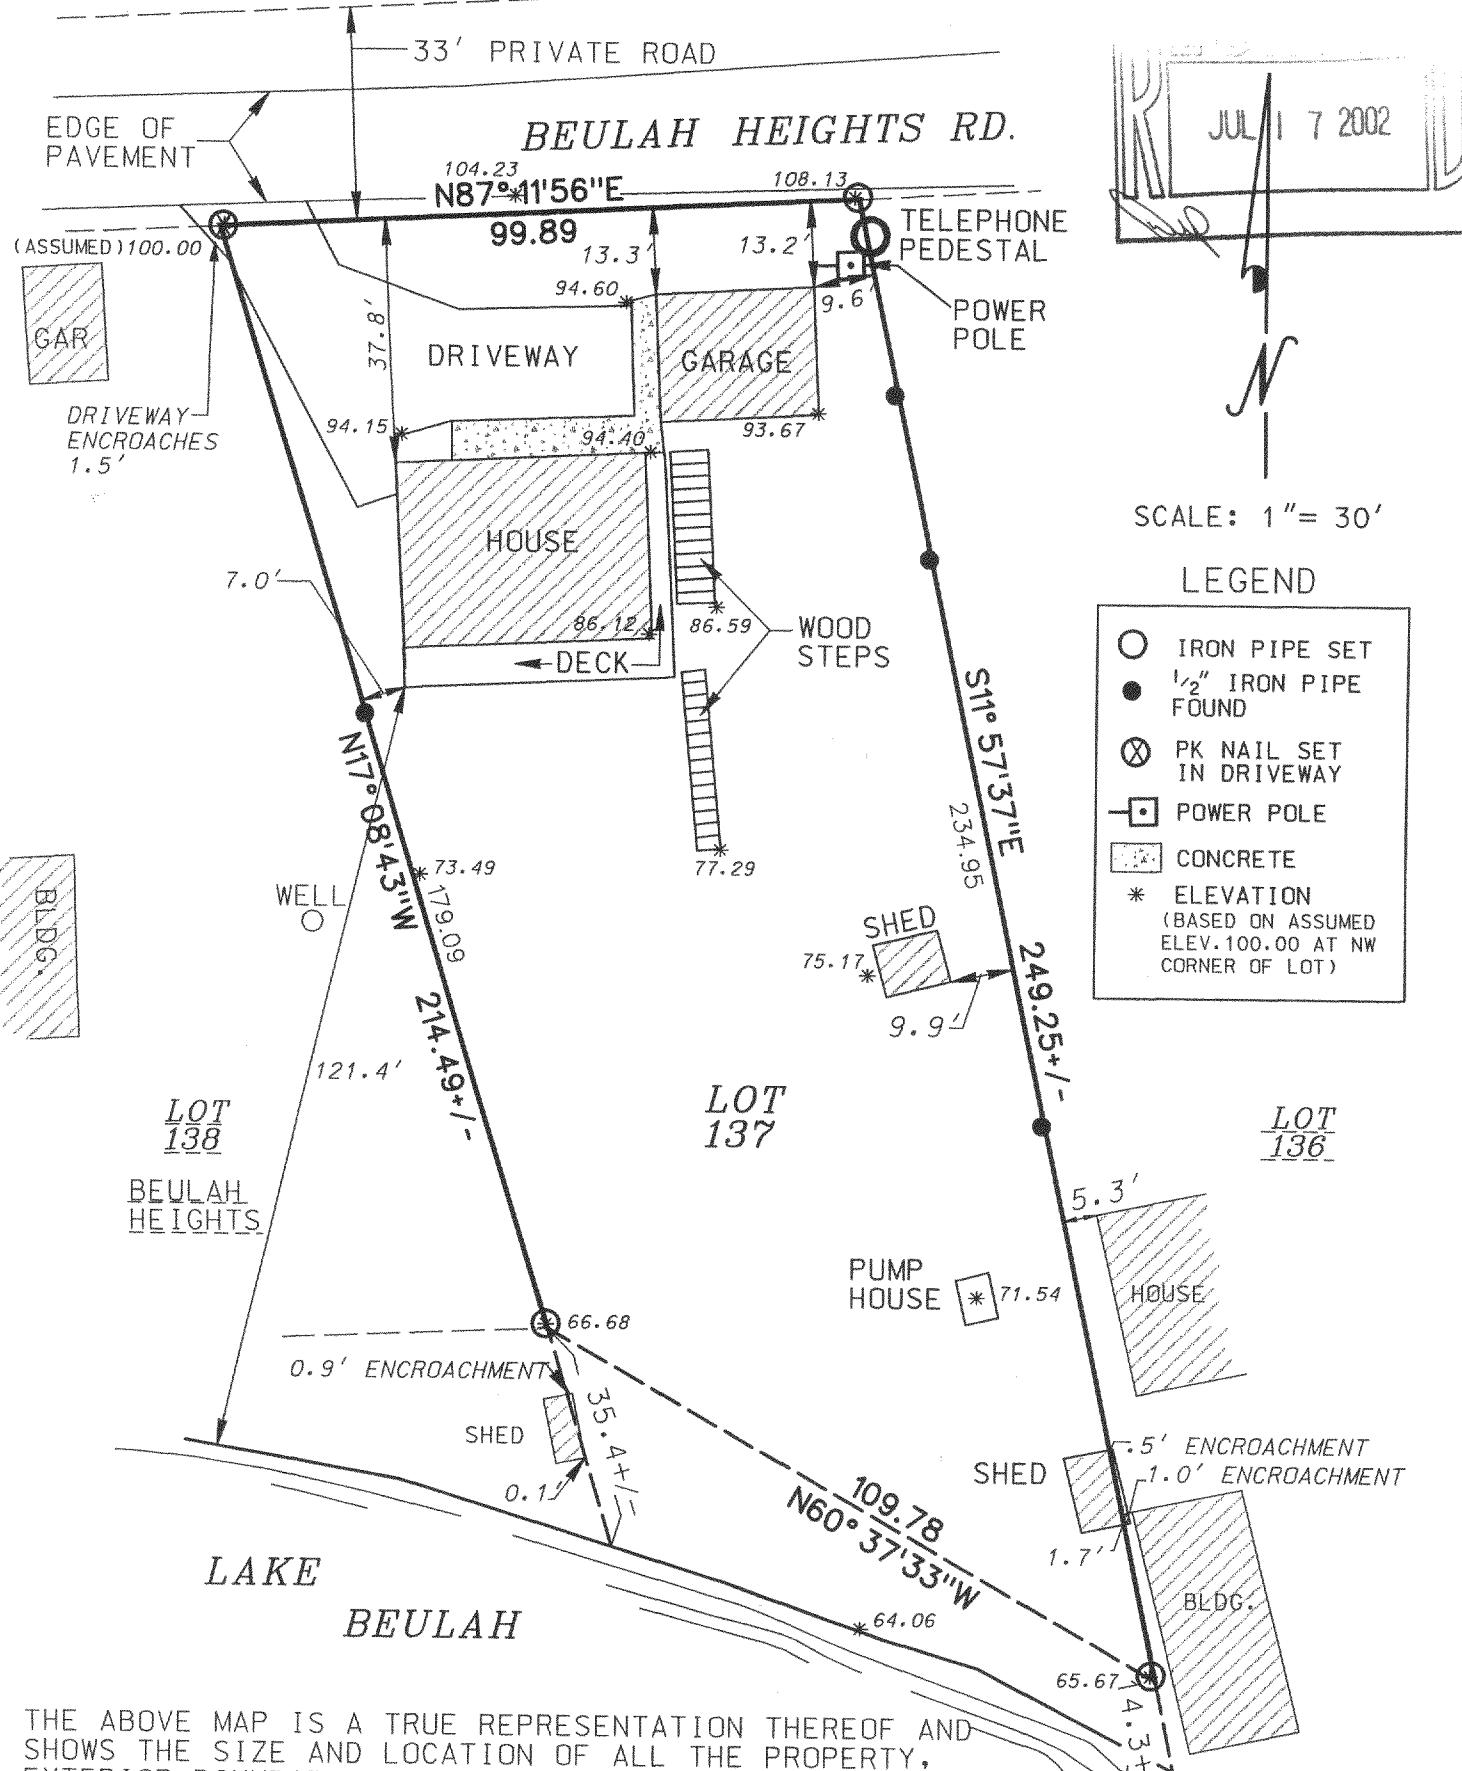

THE ABOVE MAP IS A TRUE REPRESENTATION THEREOF AND SHOWS THE SIZE AND LOCATION OF ALL THE PROPERTY, EXTERIOR BOUNDARIES, THE LOCATION OF ALL VISIBLE BOUNDARY FENCES, APPARENT EASEMENTS, ROADWAYS AND VISIBLE ENCROACHMENTS, IF ANY.

THIS SURVEY IS MADE FOR THE USE OF THE PRESENT OWNERS OF THE PROPERTY, AND ALSO THOSE WHO PURCHASE, MORTGAGE OR GUARANTEE TITLE THERETO, WITHIN ONE (1) YEAR FROM DATE HERETO. **THIS IS  
PROPERTY SURVEY**

RETO  
THIS IS ORIGINAL  
PRINT ONLY IF  
SEAL IS IMPRINTED  
IN RED



BRADFORD L SPENCER, R.L.S. 2069  
RSV#02207LOT137

418-1555