


Plat of Survey

of



Lots 1 and 2 of Certified Survey Map No. 1604,
recorded in Vol. 7 on Page 269 and located in the Northwest 1/4 and
the Southwest 1/4 of Section 4 and the Northeast 1/4 of Section 5,
Town 4 North, Range 18 East, Town of East Troy, Walworth County, Wisconsin.

Surveyed for: **Coldwell Banker, Leith & Associates**
102 North Wisconsin Street
Elkhorn, Wisconsin 53121

Tax Parcel
PET 400004A

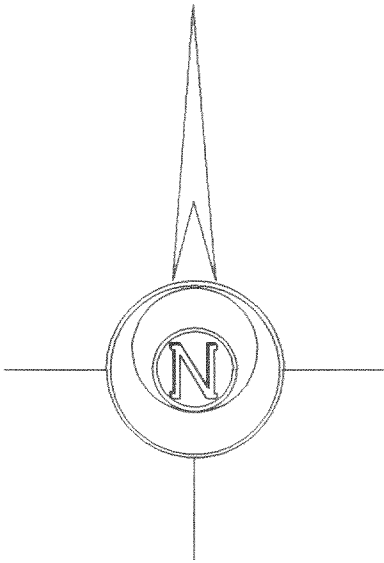

Readings reference to Certified
Survey Map No. 1604

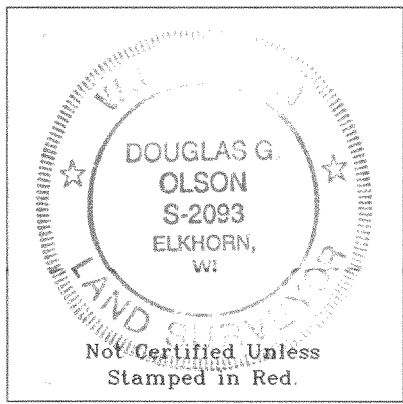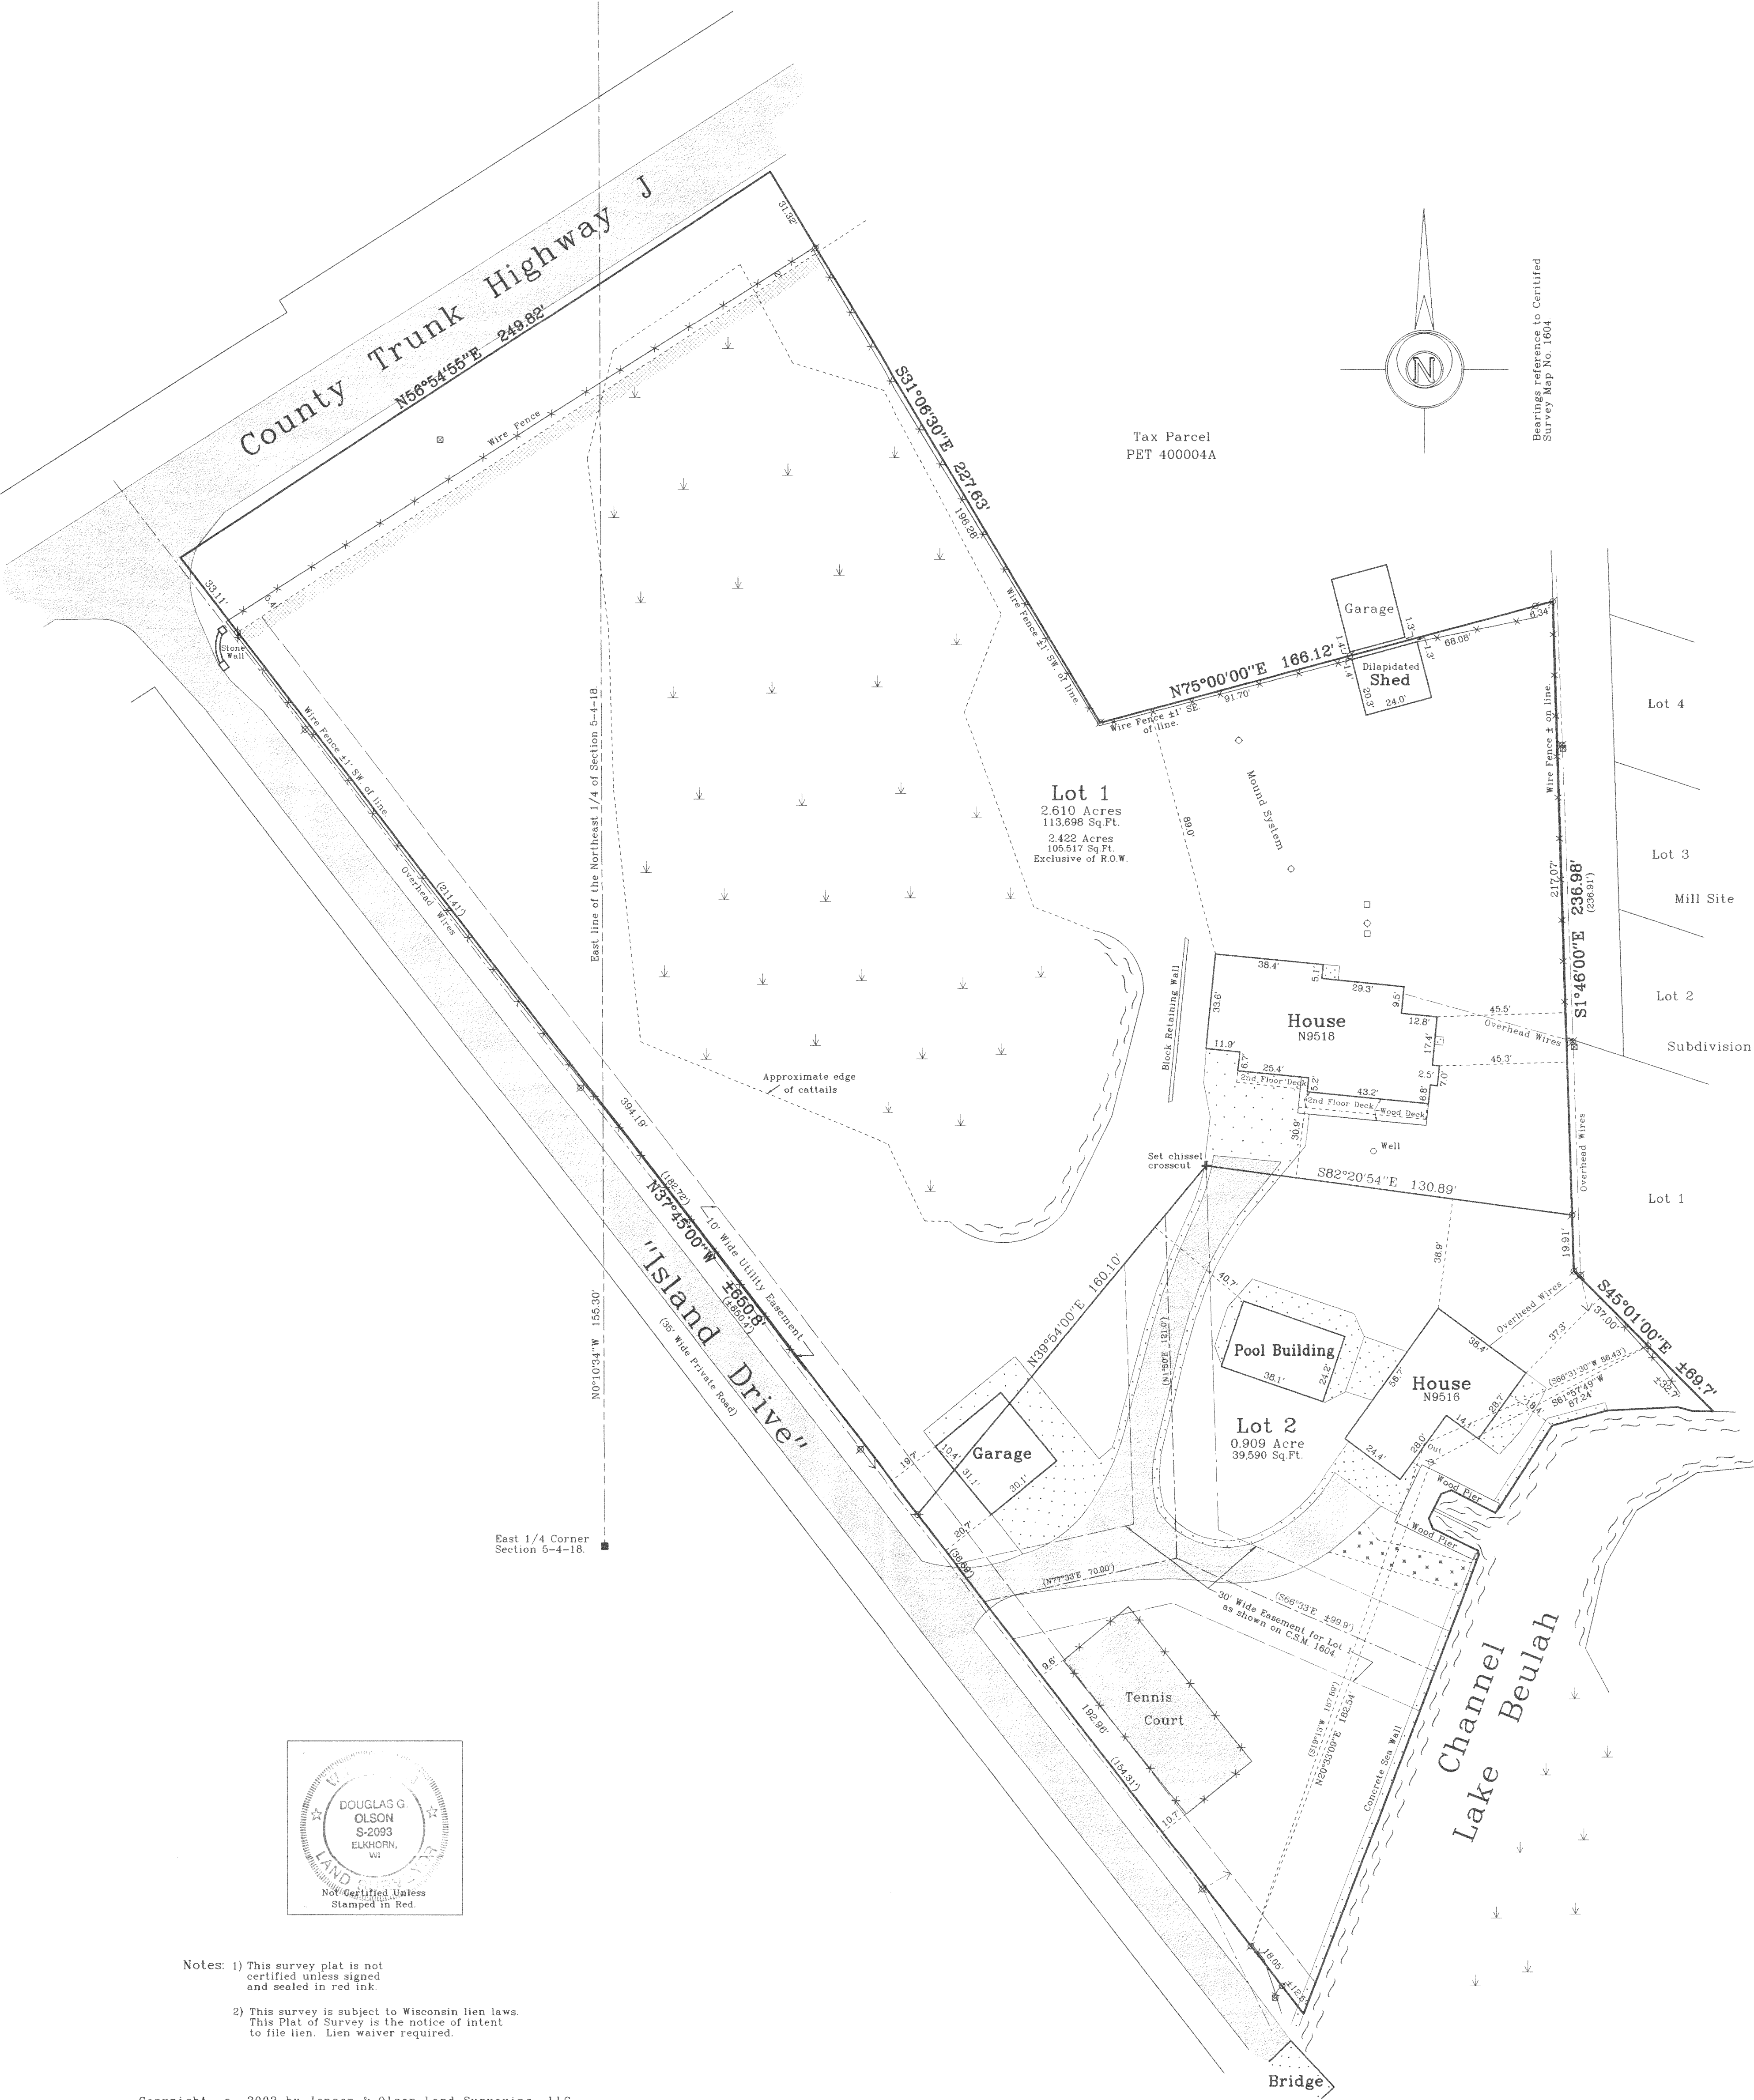

Notes: 1) This survey plat is not
certified unless signed
and sealed in red ink.


2) This survey is subject to Wisconsin lien laws.
This Plat of Survey is the notice of intent
to file lien. Lien waiver required.

Copyright © 2002 by Jensen & Olson Land Surveying, LLC.

All rights reserved. No part of this survey plat may be reproduced
or transmitted in any form by any means - graphic, electronic, or
mechanical, including photocopying, tracing, or information storage
and retrieval systems - without permission in writing from Douglas
G. Olson, Jensen & Olson Land Surveying, LLC.

I hereby certify that I have surveyed the above described
property and the map hereon is correct to the best of my professional
knowledge and belief and shows the size and location of the property,
its exterior boundaries, the location and dimensions of all visible
structures thereon, boundary fences, apparent easements and roadways
and visible encroachments, if any.
This survey is made for the exclusive use of the present owners
of property, and also those who purchase, mortgage or guarantee title
thereto, within one year from the date hereof.

Douglas G. Olson
Wisconsin Registered Land Surveyor - 2093

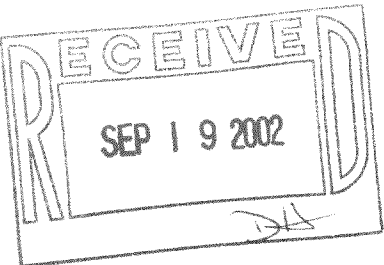

2002.001


Sheet 1 of 1 Sheets.

Job Reference Number
2002.001

- Legend**
- Found County Section Corner
 - Found Iron Pipe
 - Recorded Information
 - Utility Pole
 - Utility Pedestal
 - Concrete Cover
 - Septic Vent
 - Concrete Surface
 - Asphalt Surface
 - Gravel Surface
 - No Access per C.S.M. 1604



Jensen & Olson Land Surveying, LLC
45 South Wisconsin Street P.O. Box 322
Elkhorn, Wisconsin 53121
Telephone: (262) 723-3434
Facsimile: (262) 723-8044

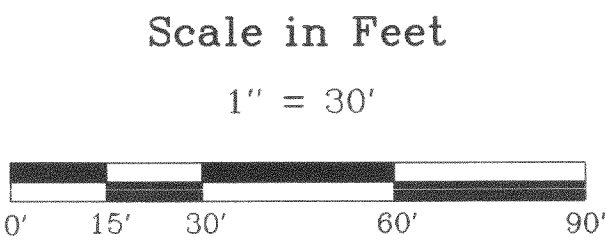

Survey date: January 30, 2002.
Revisions: