


PLAT OF SURVEY

A Parcel of Land located in the Northwest ¼ of Section 4, Township 4 North, Range 18 east, Walworth County Wisconsin and described as follows, to-wit: Commencing at the Southeast corner of Millsite Subdivision; thence South 48°24' East 67.98 feet to the Southerly side of the Highway and the place of beginning; thence South 60°29' West 28.00 feet; thence South 29°31' East 17.3 feet to the shore of Lake Beulah; thence Northeasterly along said shore 28.0 feet; thence Northwesterly 15.88 feet to the place of beginning, subject to highway rights or right of way as presently laid out or used for public purposes across said premises; said premises is also subject to recorded covenants, conditions, restrictions, easements and zoning ordinances.

Surveyed for: Sandra Smet

SOUTHEAST CORNER OF LOT 27
MILLSITE SUBDIVISION

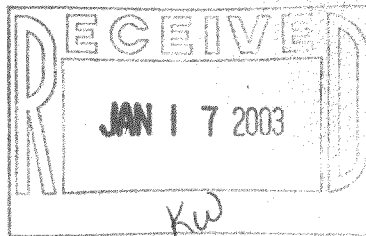

C.T.H.

"J"

EDGE OF PAVEMENT

CHAIN LINK FENCE

EXISTING BUILDING

UTILITIES

614 SQ. FT. ±

N60°29'00"E

28.00'

S29°31'00"E

13.10'

7.7'

0.3' ON PROPERTY

CHAIN LINK FENCE

ON LINE

CONCRETE

S60°29'00"W

28.00'

6' ±

11' ON PROP.

LAKE BEULAH


SCALE 1"=10'

- FOUND 1" IRON PIPE
- SET 1" IRON PIPE

"I hereby certify that I have surveyed the above described property and that the above map is a true representation thereof and shows the size and location of the property, its exterior boundaries, the location of all visible structures and dimension of all principal buildings thereon, boundary fences, apparent easements, roadways and encroachments if any."

"This survey is made for the use of the present owners of the property, and also those who purchase, mortgage or guarantee the title thereto within one year from date hereof."

KETTLE MORaine SURVEYING INC.
W356 S9050 Godfrey Lane
Eagle Wisconsin 53119
P.O. Box 357
(262) 594-3484
Terrance E. Pisarek R.L.S.

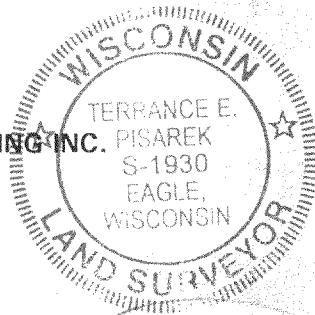

THIS IS NOT AN ORIGINAL SURVEY UNLESS THE SEAL IS RED.

12/23/02

DATE

TEP/DW

FIELD WORK BY

TEP

DRAWN BY

02225

JOB NUMBER

PMI-14B

418-1596