
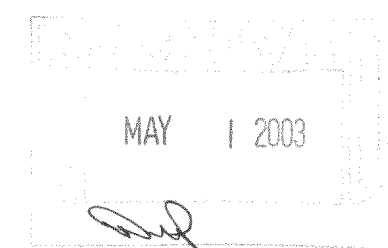


PLAT OF SURVEY

LOTS 6 AND 7 OF DUTCHLAND ACRES, LOCATED IN THE SOUTHEAST¹/₄ OF THE NORTHEAST¹/₄ OF SECTION 21,
TOWN 4 NORTH, RANGE 18 EAST, OF THE 4TH P.M., TOWNSHIP OF EAST TROY, COUNTY OF WALWORTH, STATE OF WISCONSIN.

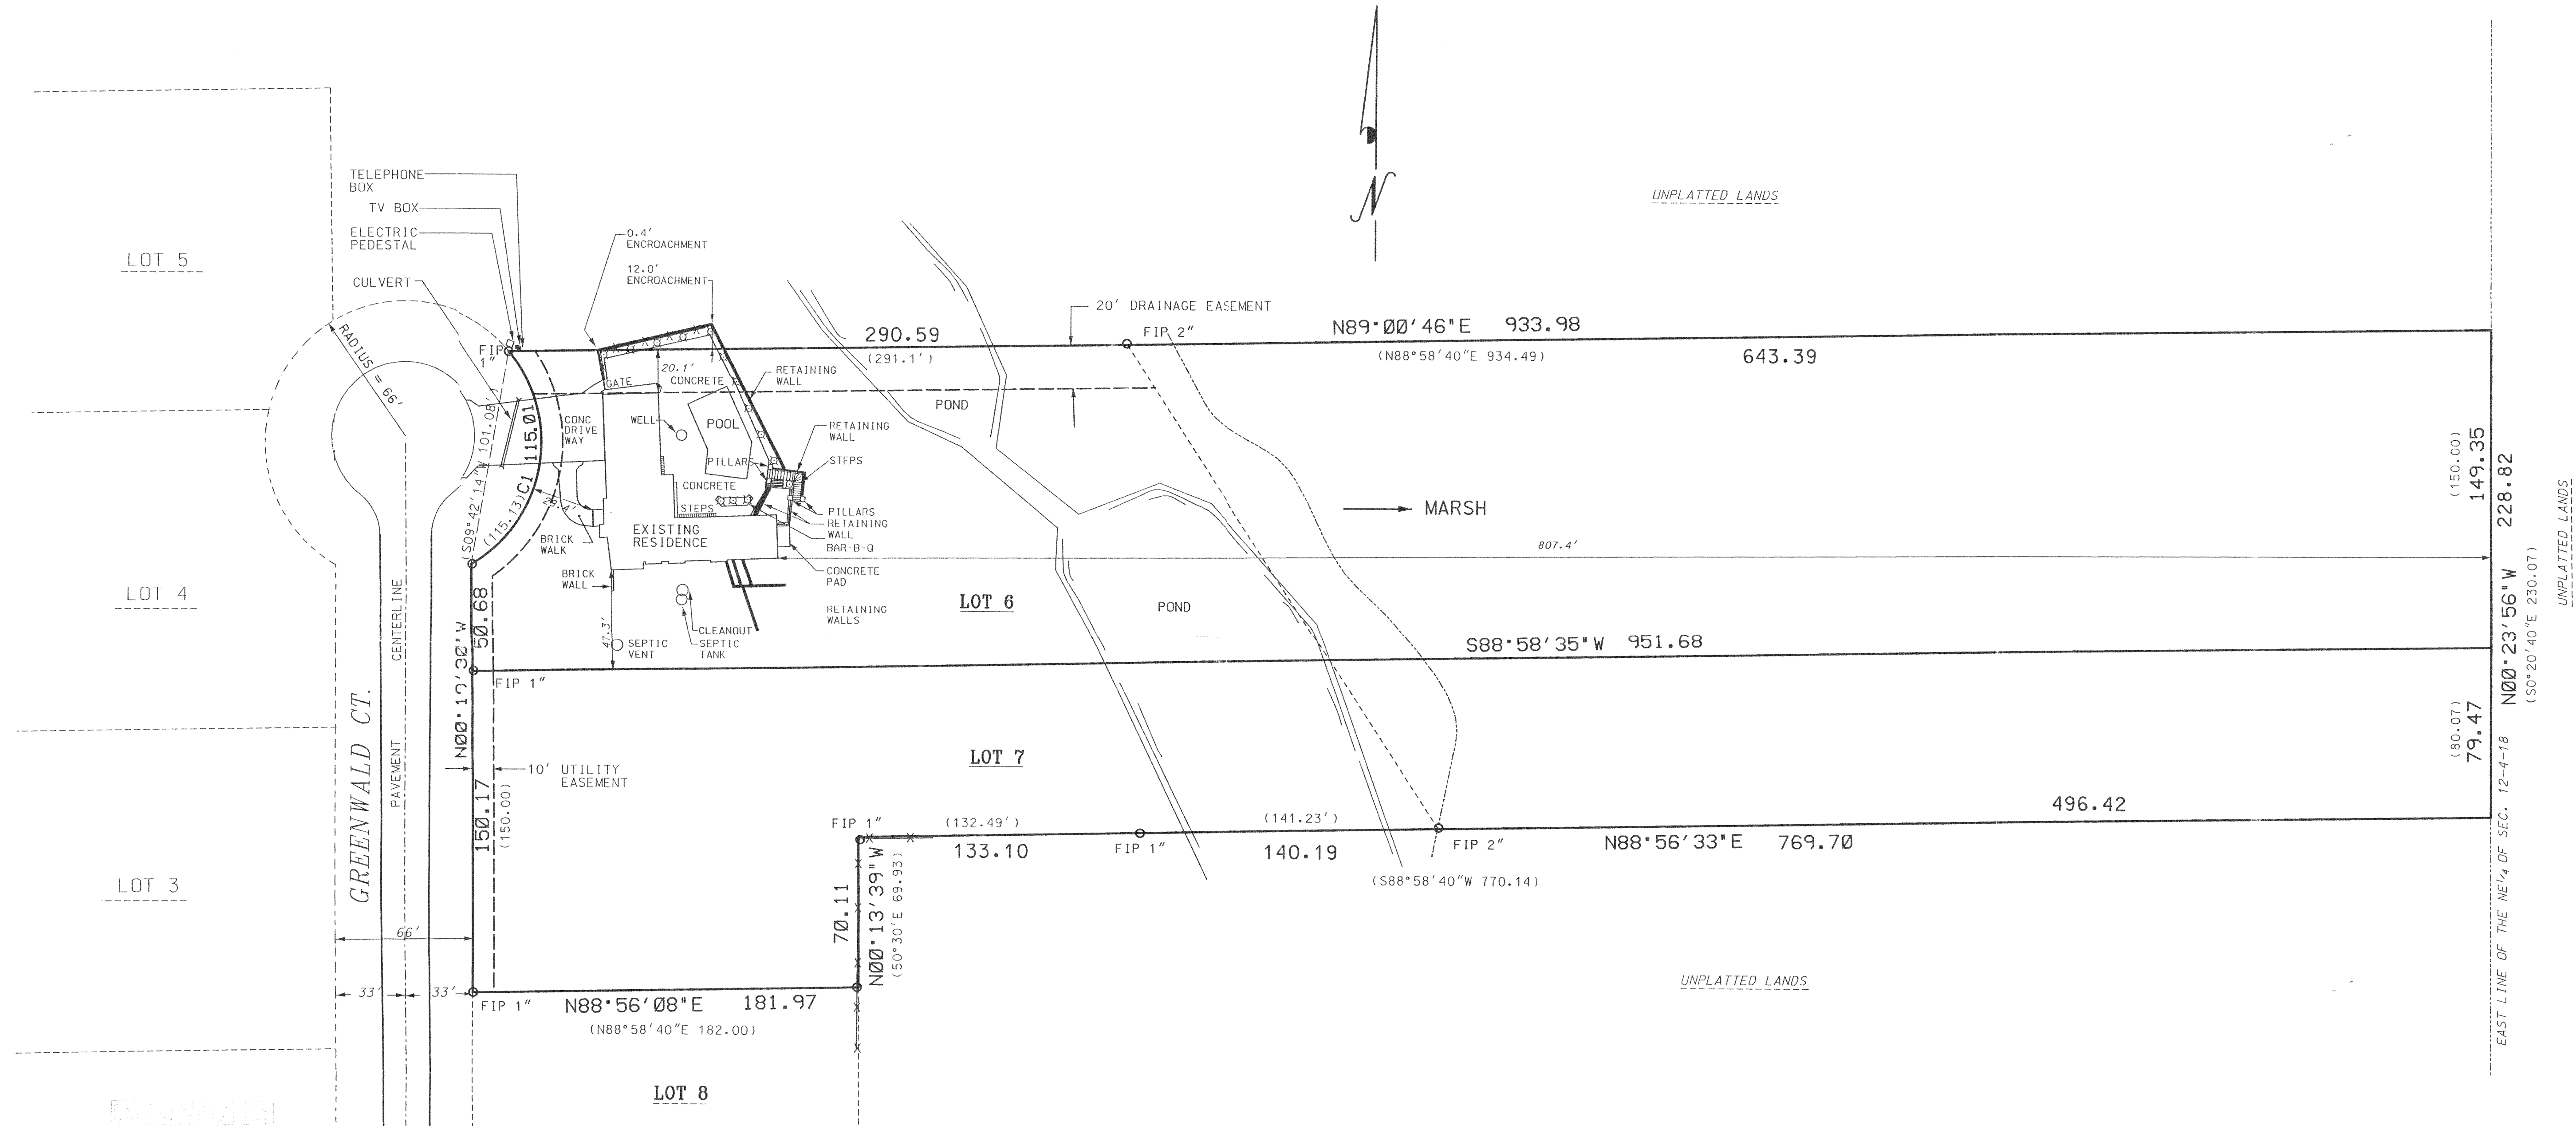


THE ABOVE MAP IS A TRUE REPRESENTATION THEREOF AND SHOWS THE SIZE AND LOCATION OF ALL THE PROPERTY, EXTERIOR BOUNDARIES, THE LOCATION OF ALL VISIBLE BOUNDARY FENCES, APPARENT EASEMENTS, ROADWAYS AND VISIBLE ENCROACHMENTS, IF ANY.

THIS SURVEY IS MADE FOR THE USE OF THE PRESENT OWNERS OF THE PROPERTY, AND ALSO THOSE WHO PURCHASE, MORTGAGE OR GUARANTEE TITLE THERETO WITHIN ONE (1) YEAR FROM DATE HERETO.

BRADFORD L. SPENCER, R.L.S. 2069
RSV#03086

THIS IS ORIGINAL
PRINT ONLY IF
SEAL IS IMPRINTED
IN RED

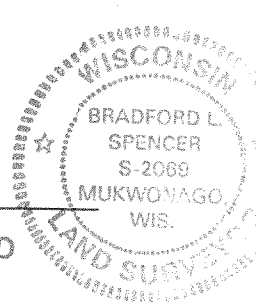

CURVE DATA (C-1)

DELTA: 99°50'47''
RADIUS: 66.00
LENGTH: 115.01
CHRD. BEAR.: N9°39'14"E
CHRD. DIST.: 101.00

LEGEND

- FIP IRON PIPE FOUND
- ⋈ LIGHT POLE
- X-X- FENCE
- () RECORDED AS

DATE: 04-15-03
FOR: JAMES R VOSS

INITIALS	DATE	1" = 40' Scale
DRAWN NDM	04/12/03	
CHECKED BLS		
PROJECT NO. 03-086		
REVISIONS		
NO.	REVISIONS	BY
DATE		
RSV ENGINEERING, INC. Engineers • Land Surveyors • Environmental Scientists 801 MAIN STREET MUKWONAGO, WISCONSIN 53149 (262)363-2004		

PD-6
PD-7

418-1657