


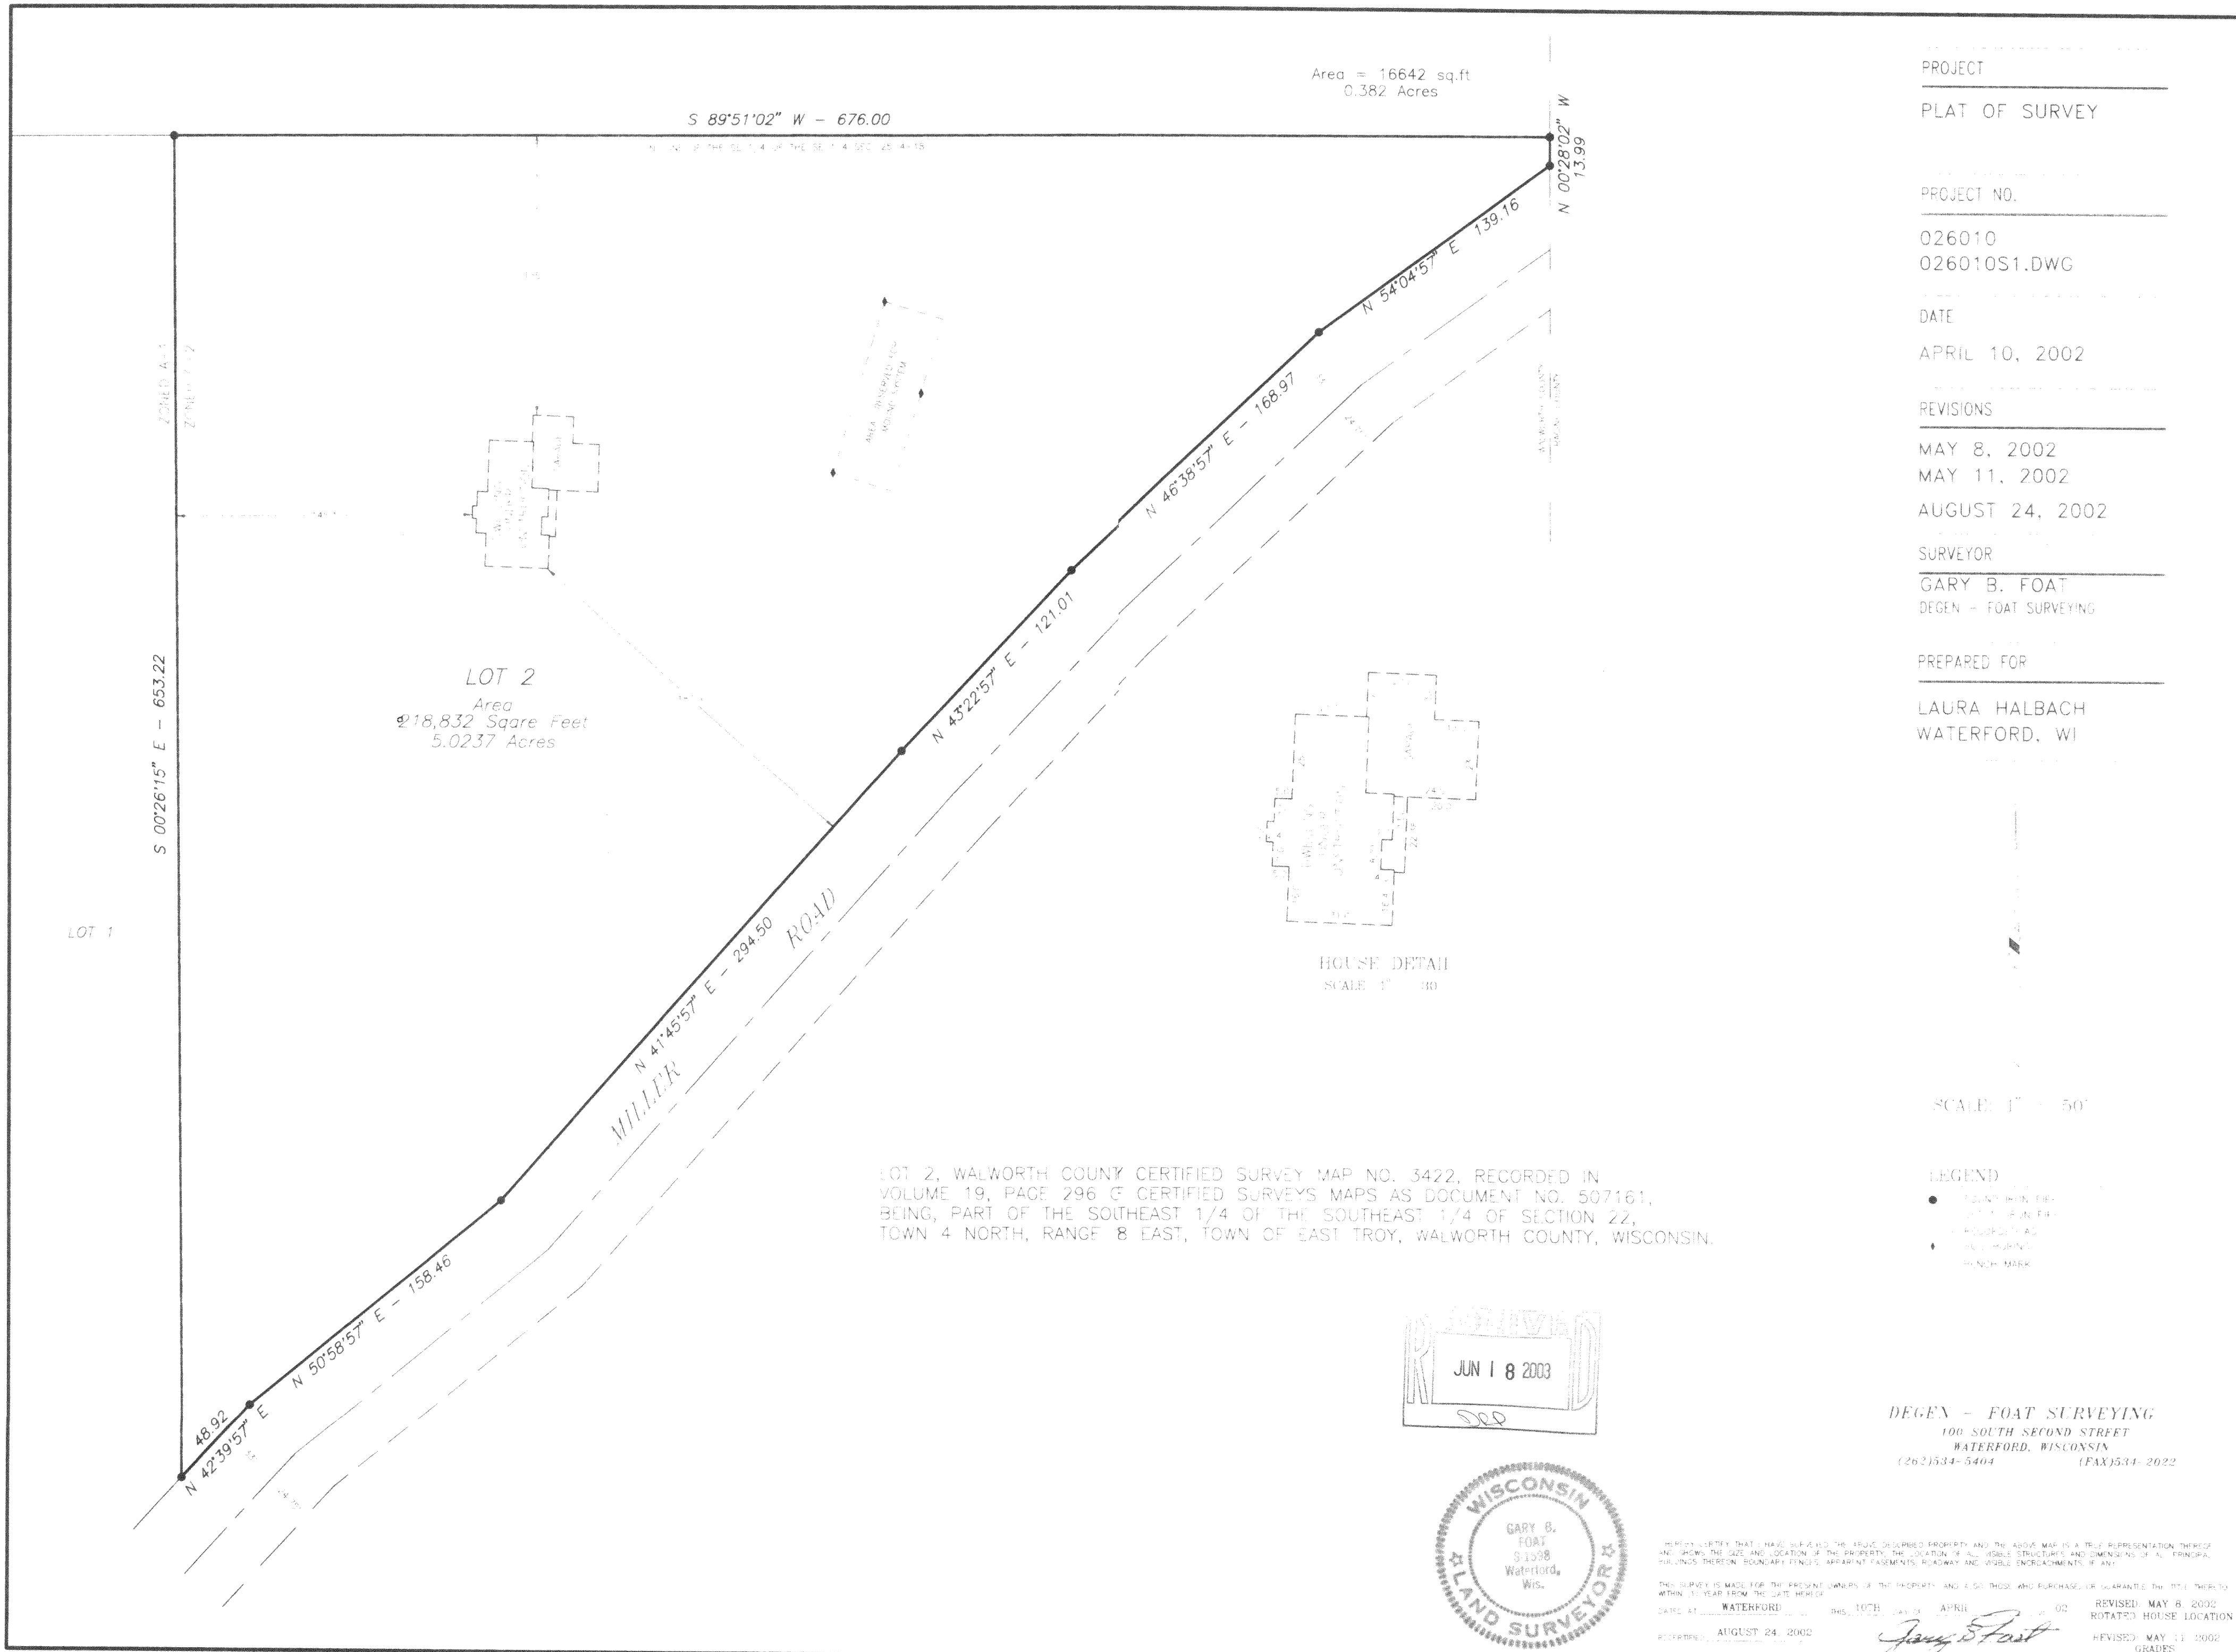

PROJECT

PLAT OF SURVEY

PROJECT NO.

026010
026010S1.DWG

DATE

APRIL 10, 2002

REVISIONS

MAY 8, 2002

MAY 11, 2002

AUGUST 24, 2002

SURVEYOR

GARY B. FOAT
DEGEN - FOAT SURVEYING

PREPARED FOR

LAURA HALBACH
WATERFORD, WI

SCALE: 1" = 50'

PA3422-2

418-1675