
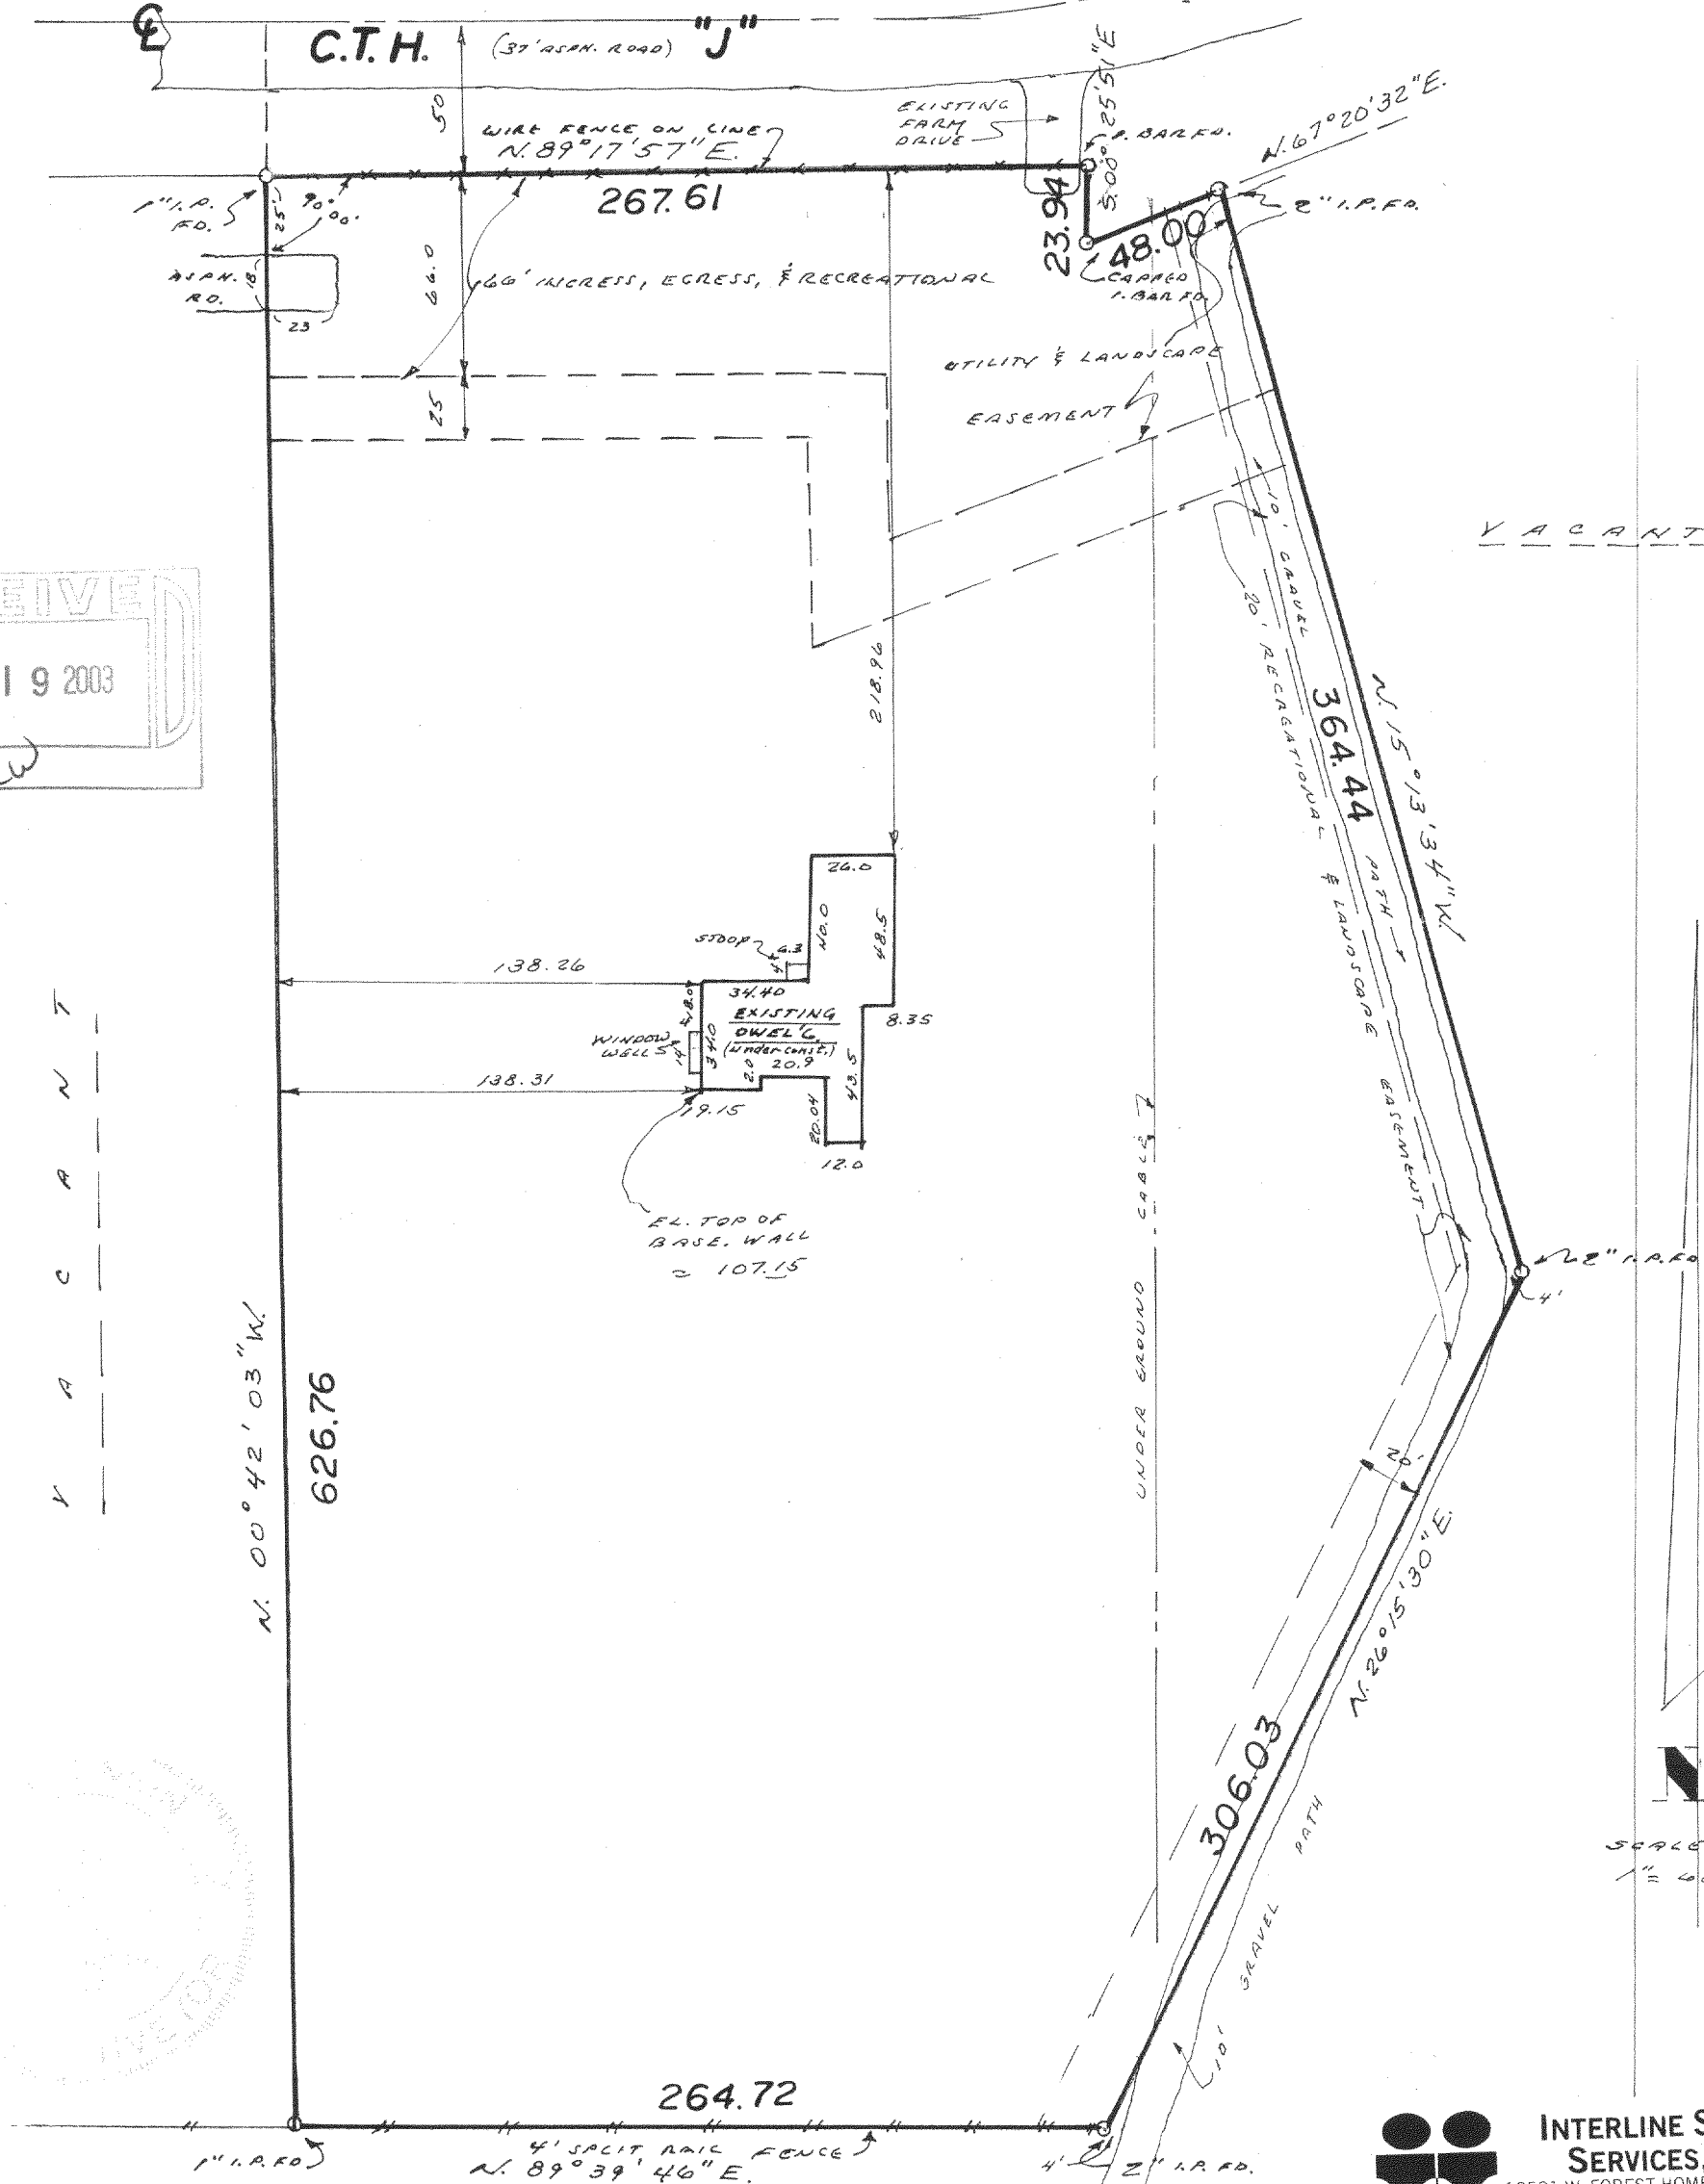


"RECERTIFICATION"
PLAT OF SURVEY

SURVEY FOR: WOLTER BROS. BUILDERS
LOCATION: C.T.H. "J"

WILM/3066

DESCRIPTION: LOT 21 BEULAH LAKE FARMS, being a subdivision located in part of N.W., N.E., S.W., and S.E. 1/4's of the N.W. 1/4, and part of the N.E., N.W., S.E. and S.W. 1/4's of the N.E. 1/4 of Section 3, Township 4 North, Range 18 East, Town of East Troy, Walworth County, Wisconsin.

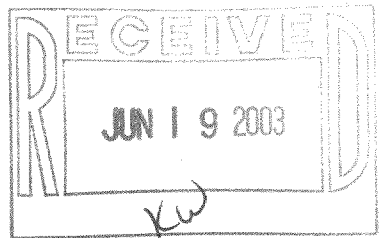

State of Wisconsin)
 Milwaukee County)ss


SURVEY CERTIFICATE

We, Interline Survey Services, Inc., certify that we have surveyed the above described property and above map is a true representation thereof, and shows the size and location of the property, its exterior boundaries, the location and dimensions of all visible structures thereon, fences, apparent easements and roadways and visible encroachments, if any.

This survey is made for the exclusive use of the present owners of the Property, and also those who purchase, mortgage or guarantee the title thereto, within one (1) year from date hereof.

Randy Smith

Wisconsin Registered Land Surveyor

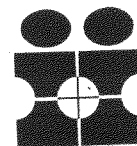

INTERLINE SURVEY SERVICES, INC.

10521 W. FOREST HOME AVE. STE. 201
 HALES CORNERS, WI 53130
 PHONE 425-2060

DATED: 6/12/03

JOB NO. 29407

PBF-21

418-1678