

PLAT OF SURVEY

-OF-



LOT NUMBERED TWENTY-NINE (29), IN SHOREWOOD, BEING A SUBDIVISION OF PART OF THE SOUTHEAST QUARTER (SE 1/4) OF SECTION TEN (10), THE SOUTHWEST QUARTER (SW 1/4) OF SECTION ELEVEN (11), THE NORTHWEST QUARTER (NW 1/4) OF SECTION FOURTEEN (14) AND THE NORTHEAST QUARTER (NE 1/4) OF SECTION FIFTEEN (15), ALL IN TOWNSHIP FOUR (4) NORTH, RANGE EIGHTEEN (18) EAST, IN THE TOWN OF EAST TROY, COUNTY OF WALWORTH, STATE OF WISCONSIN.

SURVEY FOR: HACKBARTH BUILDERS

SURVEY LOCATION: W914 SHOREWOOD DRIVE

I HEREBY CERTIFY THAT THE EXISTING FOUNDATION AS SHOWN ON THIS PLAT OF SURVEY IS LOCATED AS SHOWN THUS ( ). DATED THIS 5TH DAY OF JUNE, 2003.

*Robert J. Wetzel*  
ROBERT J. WETZEL S-1778

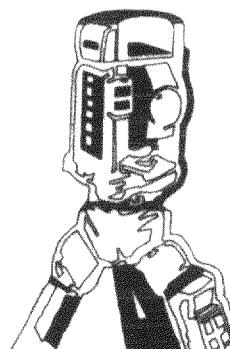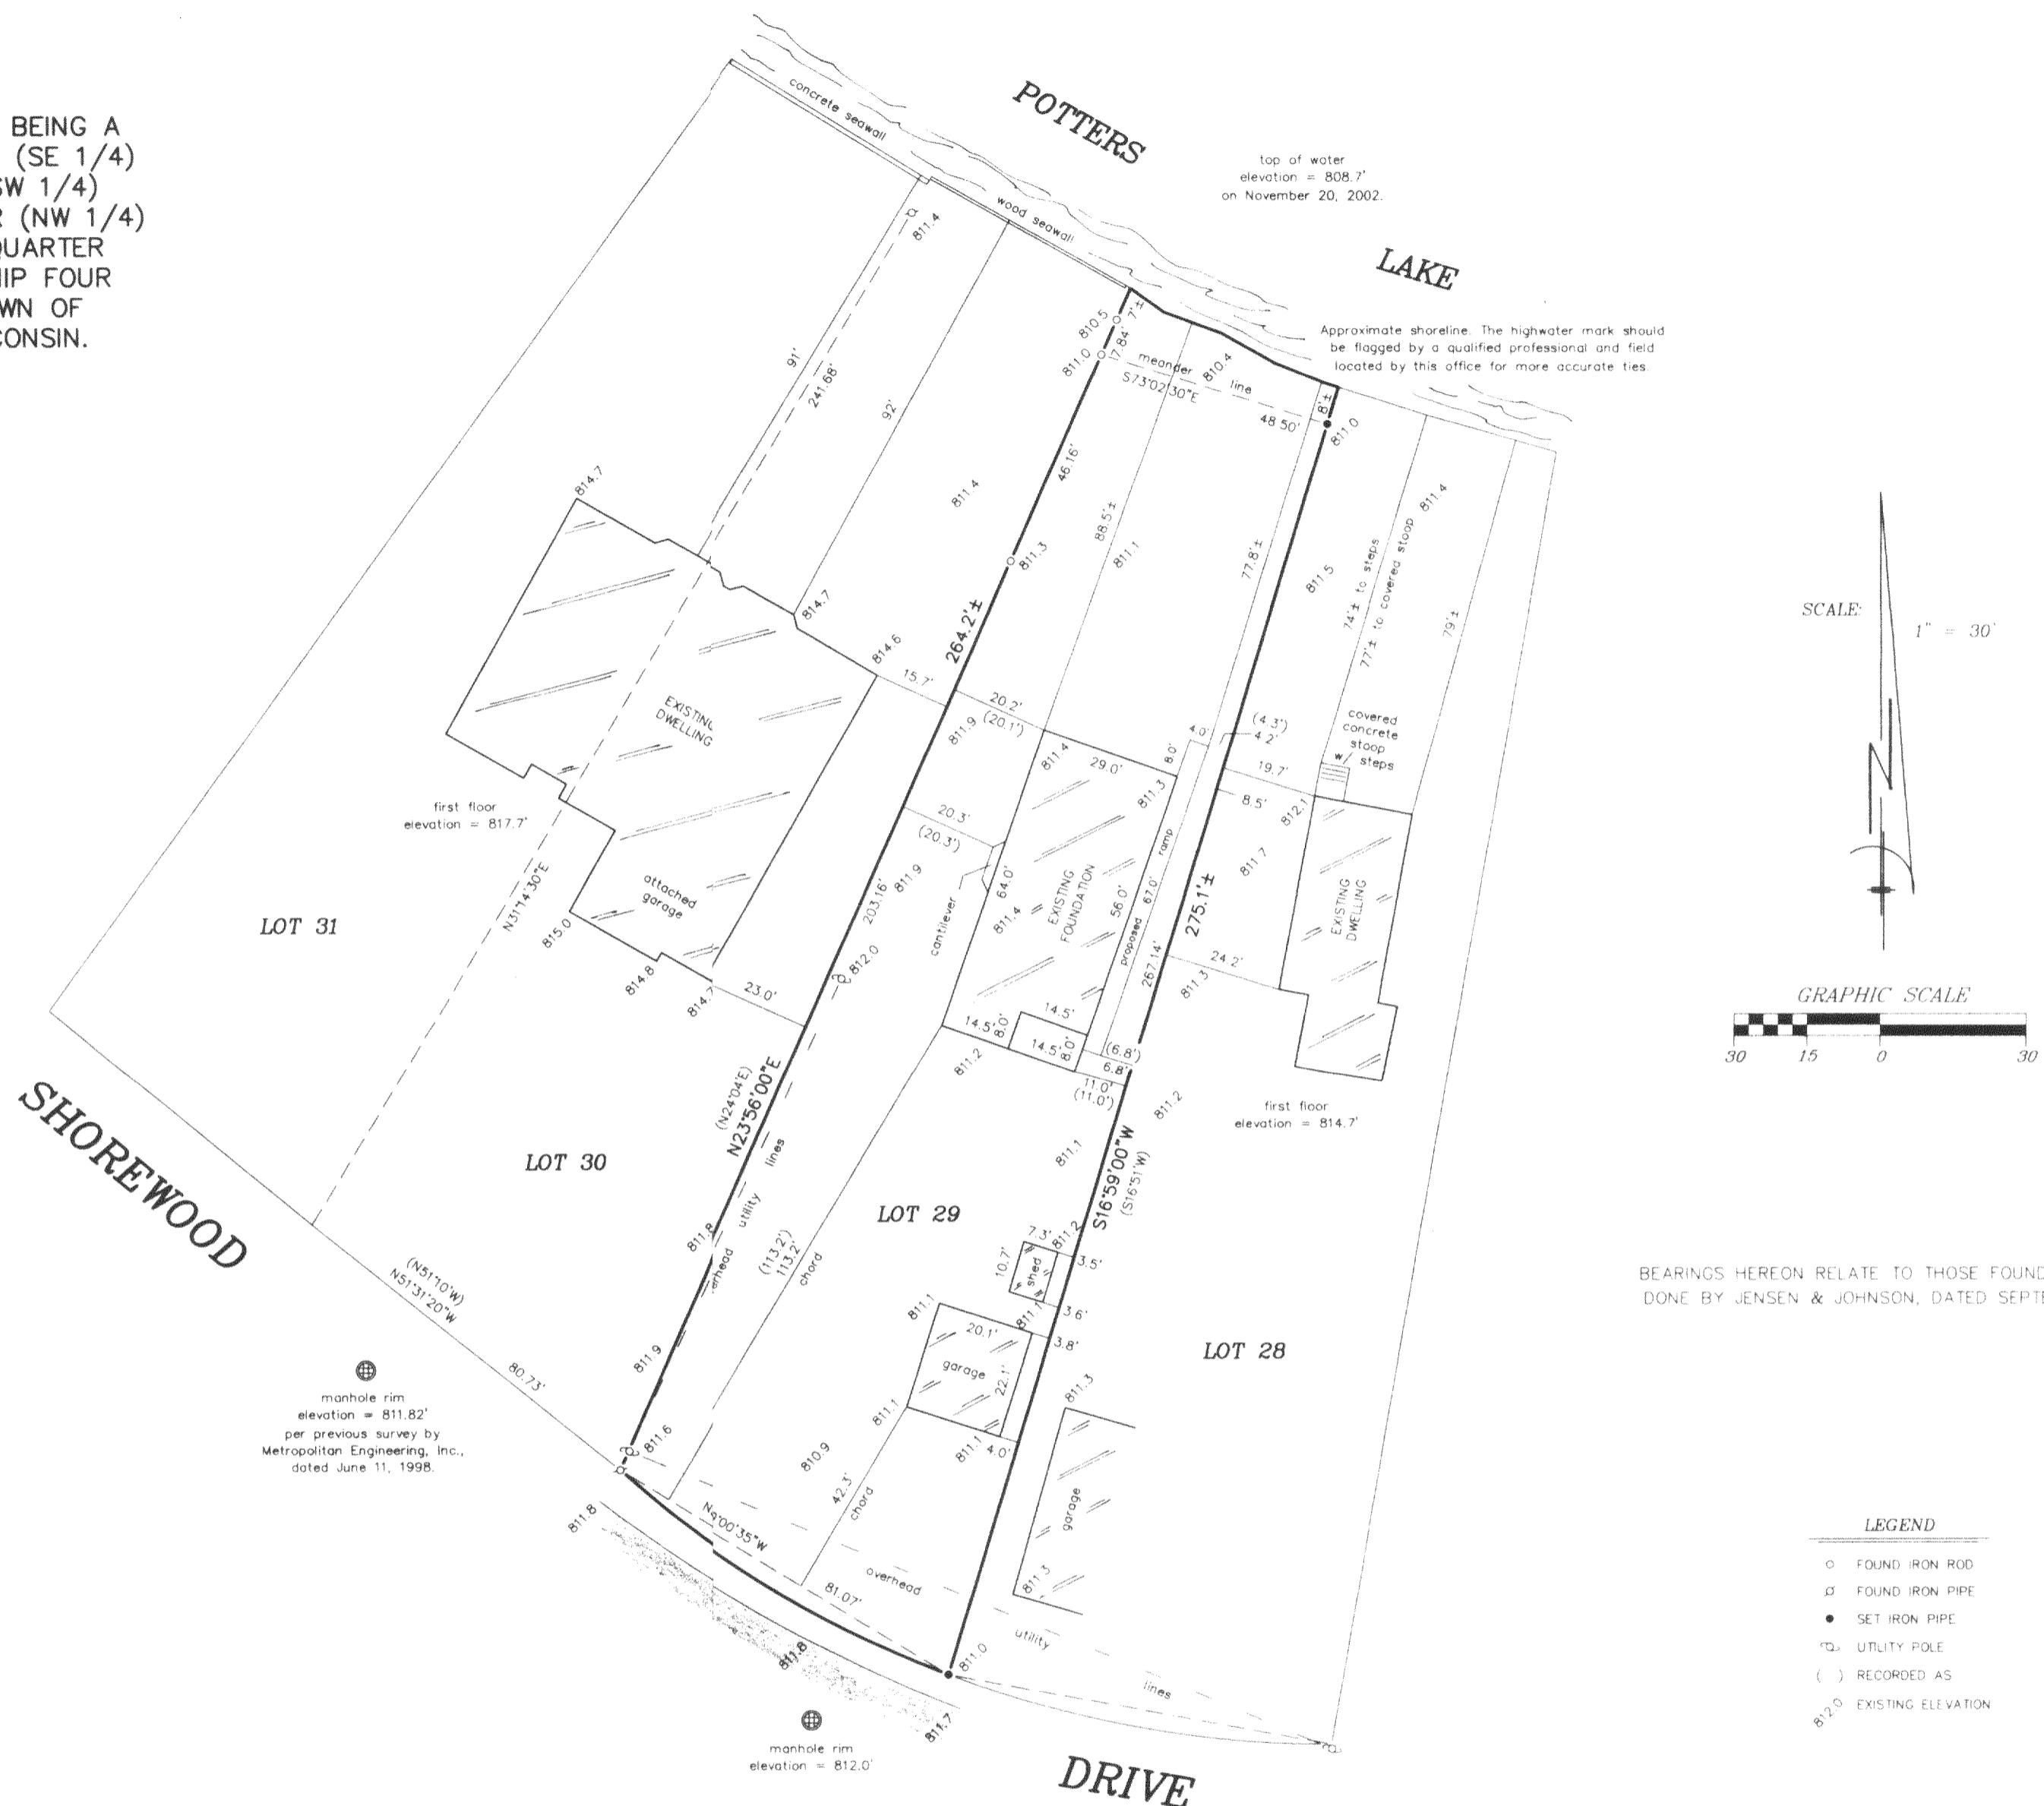


B.W. SURVEYING, INC.

412 N. PINE STREET  
BURLINGTON, WI 53105  
(262)-767-0225



THIS IS NOT AN ORIGINAL PRINT  
UNLESS THIS SEAL IS RED.  
*Robert J. Wetzel*  
ROBERT J. WETZEL S-1778

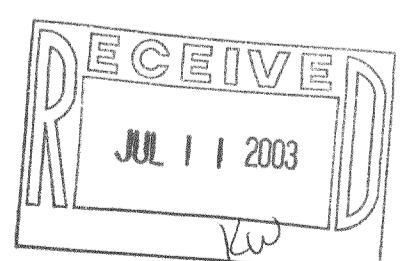

DRAWN BY:	TLS	REVISED: APRIL 10, 2002
CHECKED BY:	BJW	DATE: NOVEMBER 22, 2002
		DRAWING NO.: 5664d1
JOB NO.:	5664	SHEET 1 OF 1