


-DWELLING UNDER CONSTRUCTION
-TOP OF WALL: 862.56

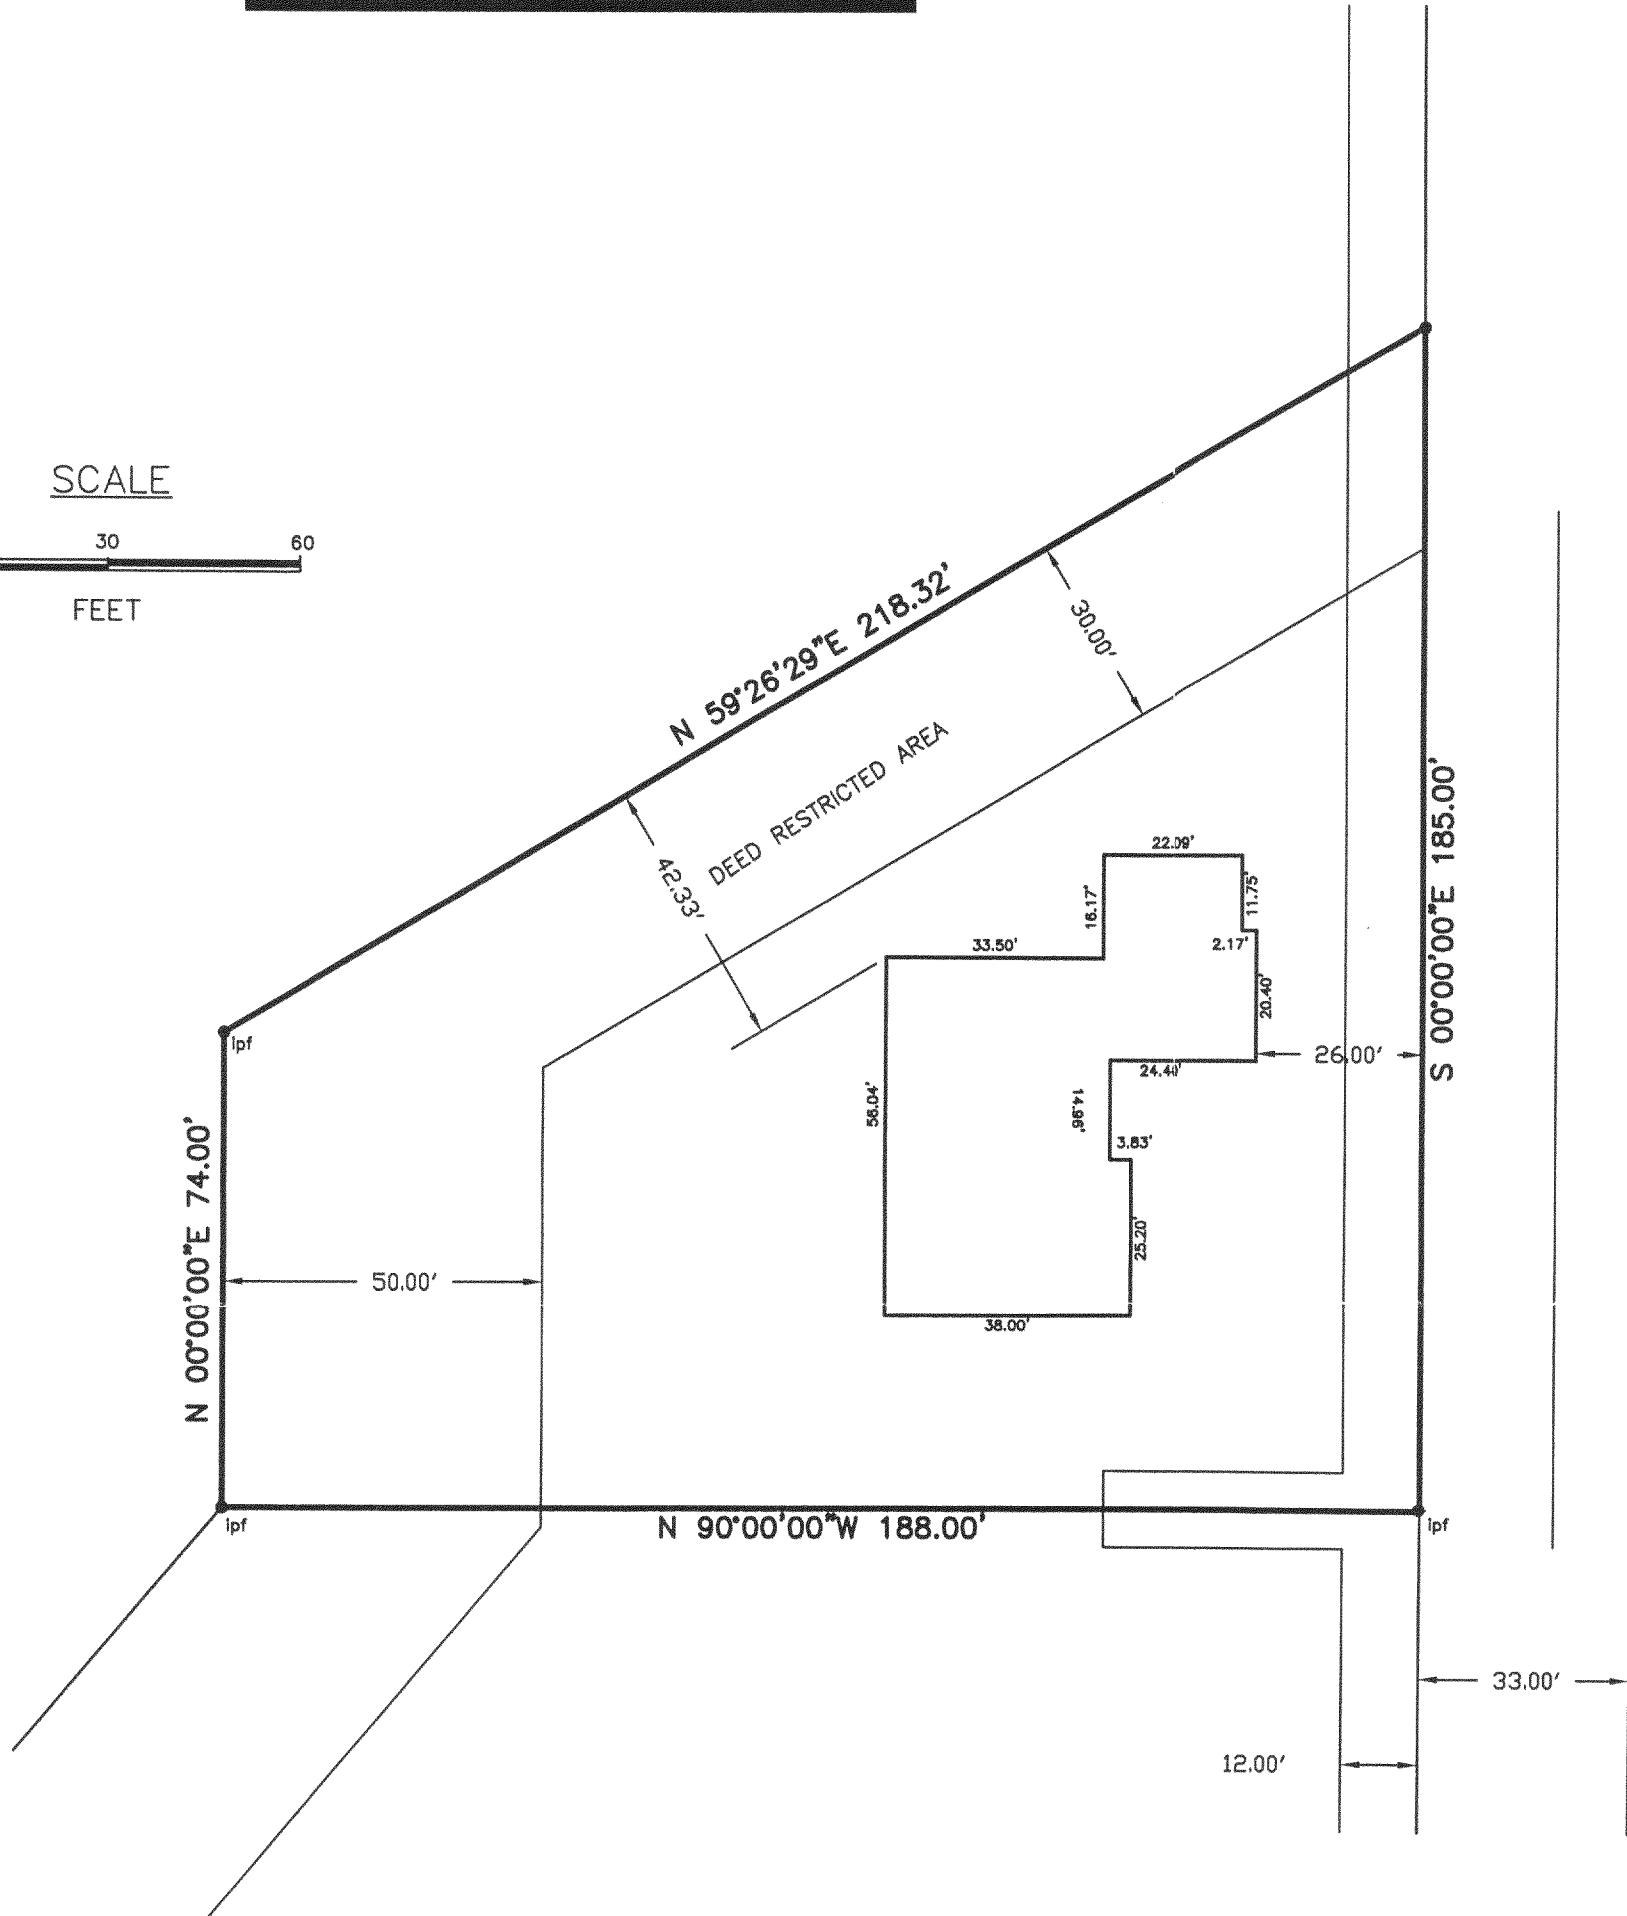

SANT MH
RIM: 861.38
INV: 851.05

EASTWOOD DRIVE

LEGAL DESCRIPTION:

LOT 8, "EASTWOOD ESTATES", A PART OF THE SOUTHEAST $\frac{1}{4}$ AND THE SOUTHWEST $\frac{1}{4}$ OF THE NORTHWEST $\frac{1}{4}$ AND PART OF THE NORTHWEST $\frac{1}{4}$ OF THE SOUTHWEST $\frac{1}{4}$ OF SECTION 11, TOWNSHIP 4 NORTH, RANGE 18 EAST, IN THE TOWN OF EAST TROY, COUNTY OF WALWORTH, STATE OF WISCONSIN.


STATE OF WISCONSIN
COUNTY OF RACINE

The above-described property has been surveyed under my direction and the above map is a correct representation thereof.

DATED AT NORTH CAPE, WISCONSIN, THIS 14TH DAY OF APRIL, 2003.

Pete L. Bailey

AMERICAN SURVEYING COMPANY, INC.
PETE L. BAILEY, RLS NO. 1398
RECERTIFIED this 4TH day of JUNE, 2003.

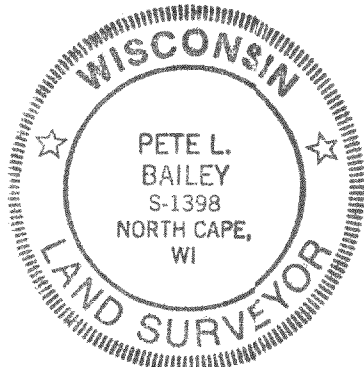

12207 C.T.H. "K" FRANKSVILLE, WISCONSIN 53126
TEL. (262) 835-4774 FAX: (262) 835-2379

DRAWN BY:	PLB	REVISIONS:	DATE
CHECKED BY:	PLB		
PLOT SCALE:	1 = 30		
DATE:	04/14/2003		
JOB NO.:	2003074		
DWG. FILE:	JN203083R	CLIENT NO.	00427


TOWN OF EAST TROY

PROJECT:

PLAT OF SURVEY/STAKE OUT SURVEY

**PREPARED FOR: PL BUILDERS, INC.
OWNERS: TODD & SUSAN METCALF**

Sheet
1
of
1

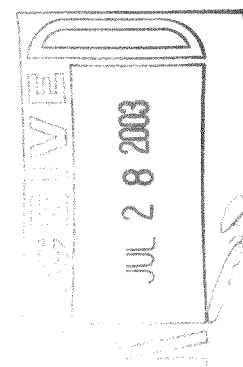

418-1688

PEE-8