
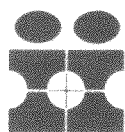
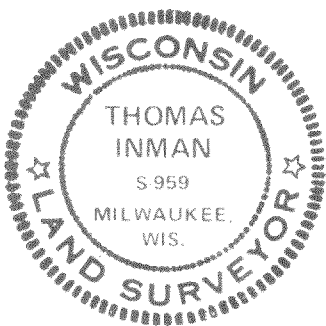


Plat of Survey

Survey For: 20th CENTURY BUILDERS
Location: Harmony Lane

665

Description: LOT 28 in MIRAMAR ADDITION NO. 2 being a subdivision of the N.E. 1/4 of Section 10, and the N.W. 1/4 of Section 11, T. 4 N., R. 18 E., in the Town of East Troy, Walworth County, Wisconsin.

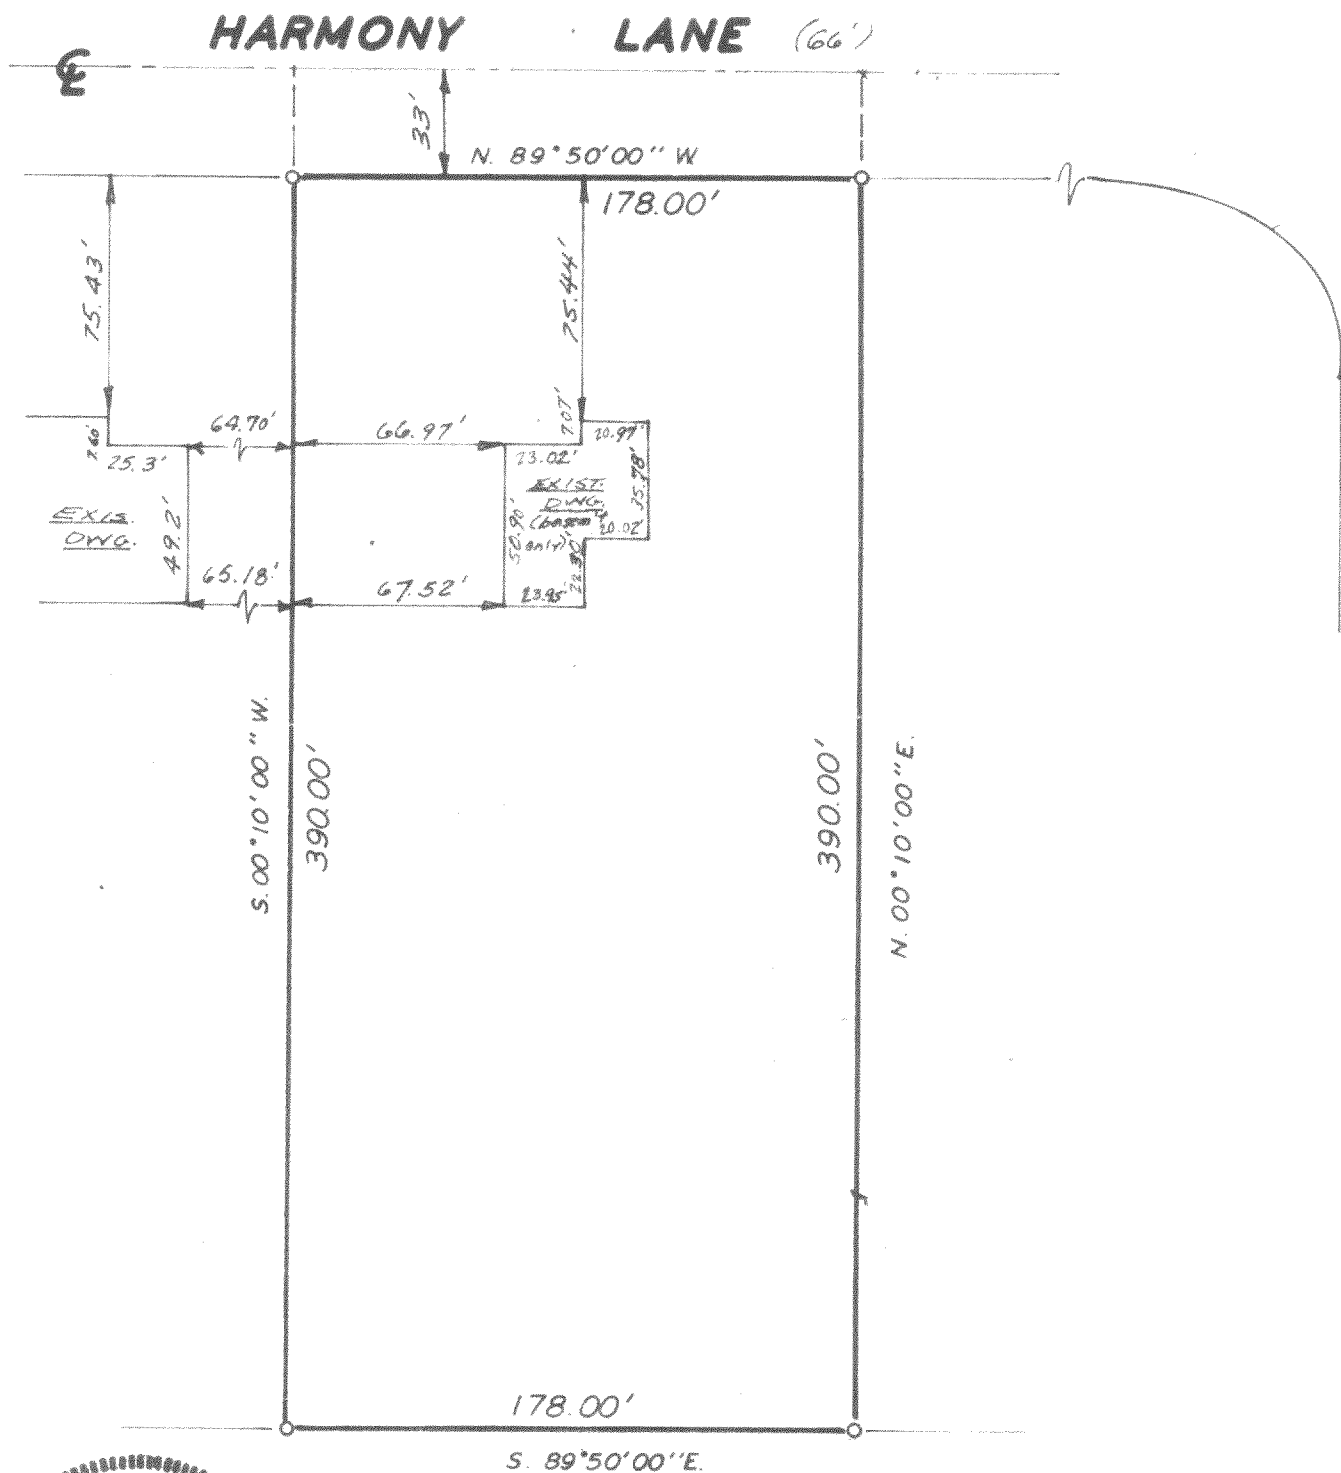

inman, inc.
ENGINEERS
SURVEYORS
LAND PLANNERS

Scale 1" = 60'



State of Wisconsin)
Milwaukee County) ss I hereby certify that I have surveyed the above described property, that the above plat is a true representation thereof and correctly shows the exterior boundary lines, location of principal buildings and other visible improvements relative to said boundary lines.

Thomas Inman

Thomas Inman, Registered Land Surveyor

Date 1/2/73

Job No. 6161418-170