


PREPARED FOR :
BRIAN CRAITE
N 82 W16060 VALLEY VIEW DR.
MENOMONEE FALLS, WI.

PLAT OF SURVEY

-OF-

LOTS 63 AND 64, IN BLOCK ONE, IN WILMER GROVE BEACH, LYING AND BEING
IN THE EAST 1/2 OF SECTION 18, IN T4N, R18E, IN THE TOWN OF EAST TROY,
WALWORTH COUNTY, WISCONSIN.

J.K. SURVEYING INC.
N3705 WILLOWBEND LANE
LAKE GENEVA, WI, 53147
262-248-3697

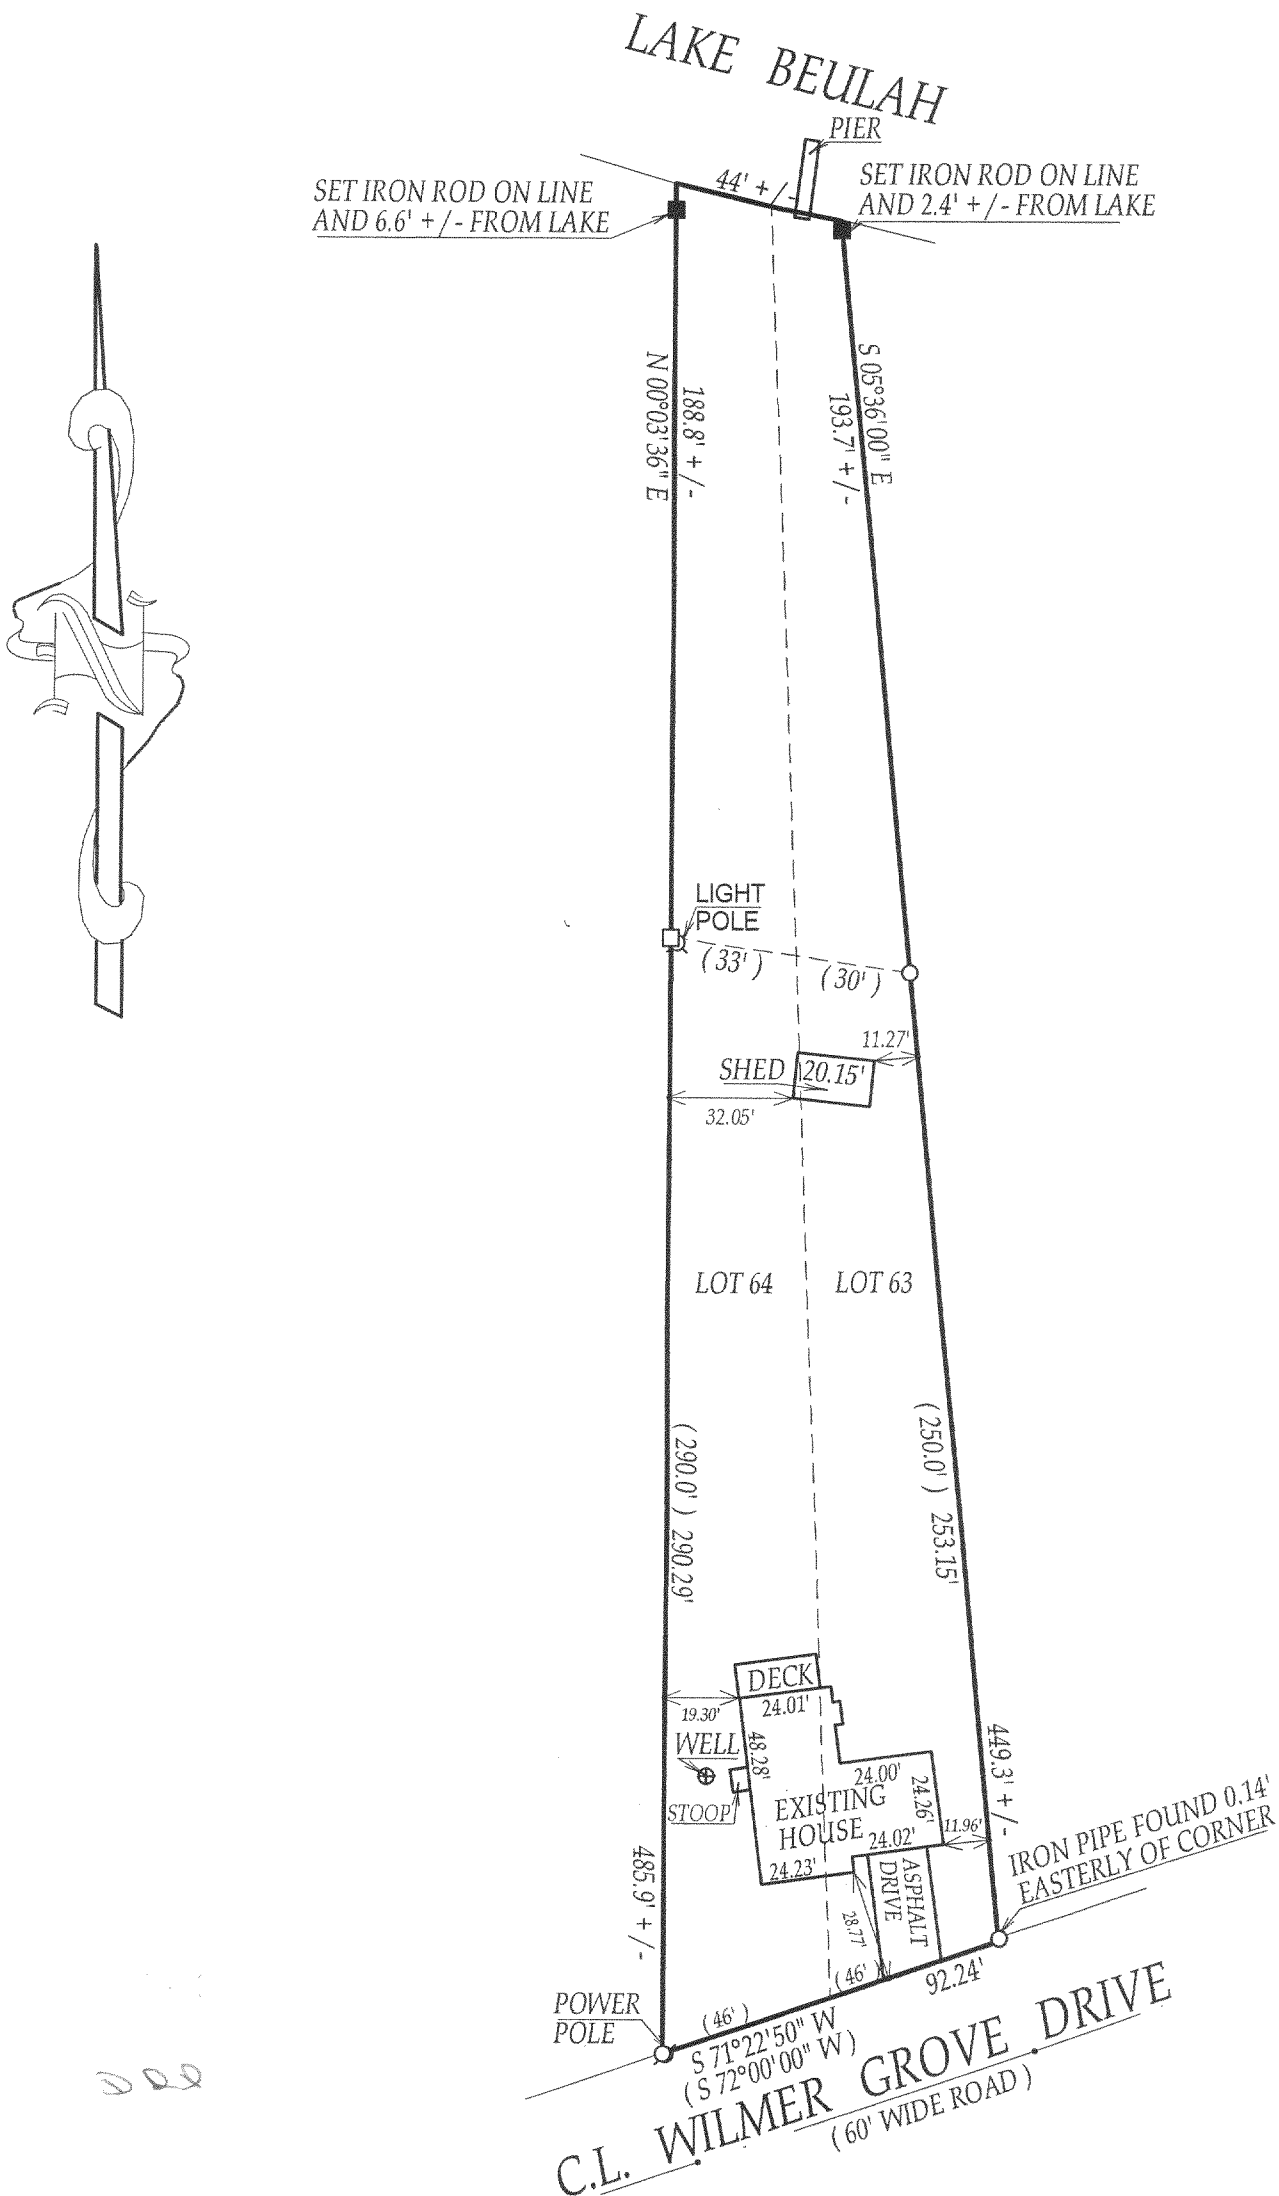

() = recorded as

□ = found iron bar

○ = found iron pipe

● = set iron pipe

■ = set iron bar

SCALE 1" = 50'

JOB # 03-380


TAX ID # PWW 00031

COMPARE LEGAL DESCRIPTION ABOVE AND DRAWING WITH DEED. FOR BUILDING RESTRICTIONS AND EASEMENTS NOT SHOWN, REFER TO DEED, ABSTRACT SOURCES AND LOCAL MUNICIPAL CODES. NOTIFY THE SURVEYOR IMMEDIATELY OF ANY DISCREPANCY.

"I hereby certify that the above described property was surveyed under my supervision and that the above map is a true representation thereof and shows the size and location of all visible structures, apparent easements and encroachments if any."

This survey is made for the present owners of the property, and those who purchase, mortgage, or guarantee the title thereto, within one year from the date hereof.

DATED THE 29 TH, DAY OF JULY 2003

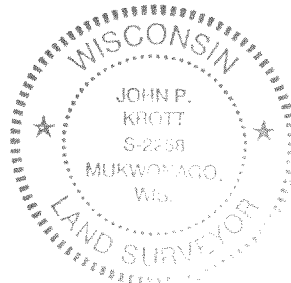

John P. Krott

JOHN KROTT S - 2258
Wisconsin Registered Land Surveyor
(original if signed in red)

418-1708