
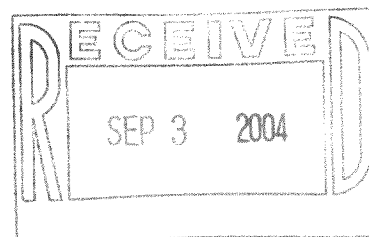



LOT 31 OF BLOCK 1 OF WILMER GROVE BEACH, located in the Northeast ¼ of Section 18, Town 4 North, Range 18 East, in the Town of East Troy, Walworth County, Wisconsin.

Survey address: N8768 Wilmer's Point Lane

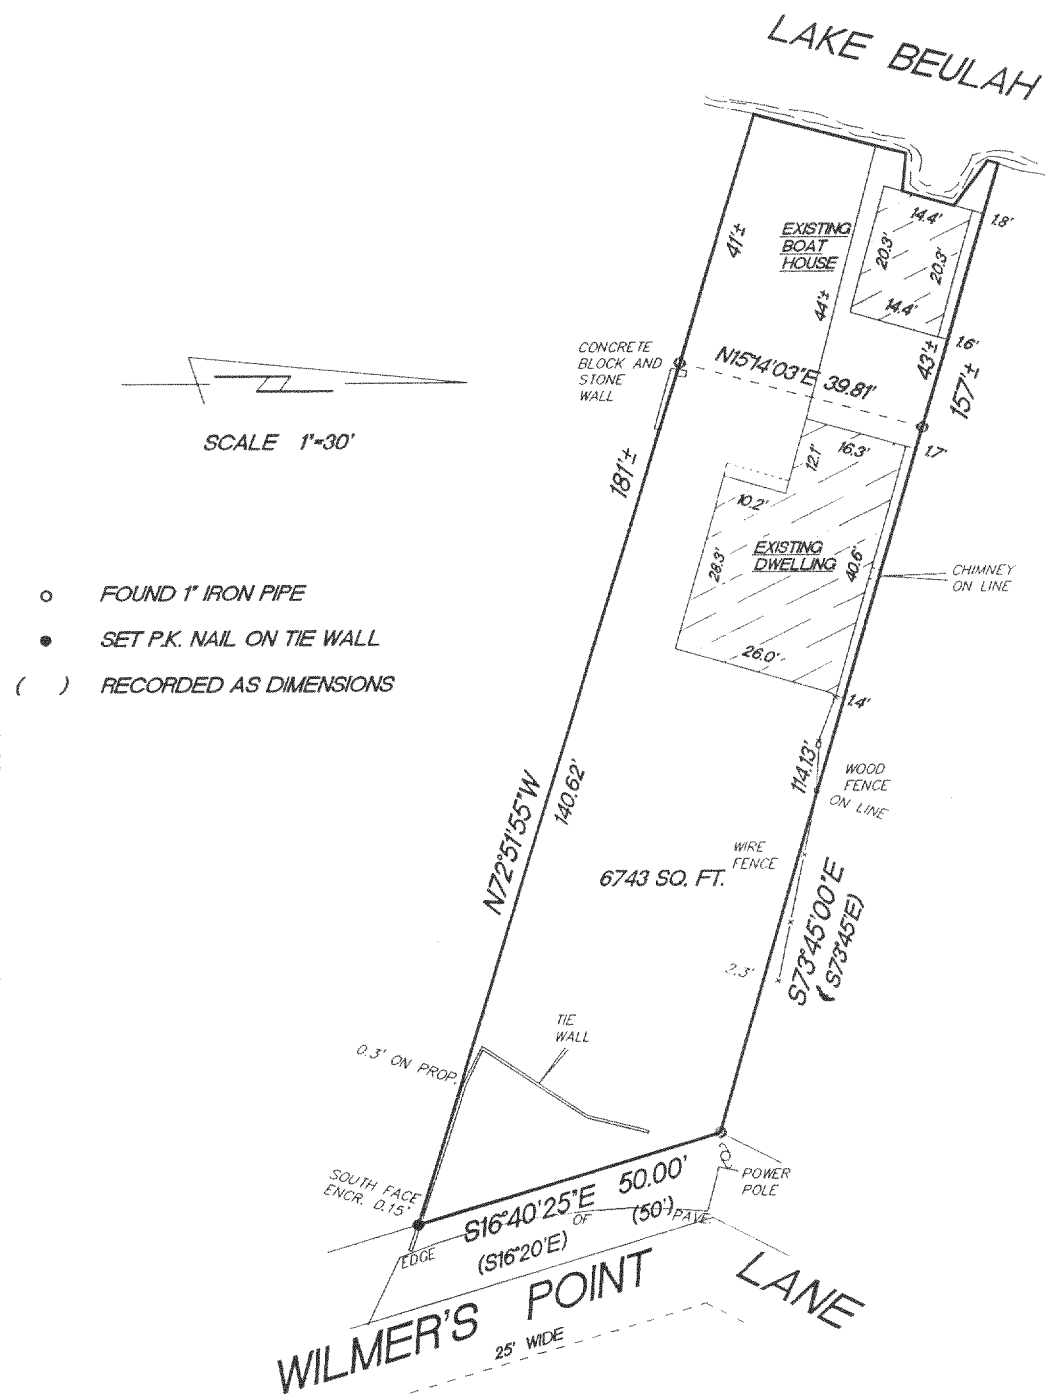

"This survey is made for the use of the present owners of the property, and also those who purchase, mortgage or guarantee the title thereto within one year from date hereof."

Terrance E. Pisarek R.L.S.

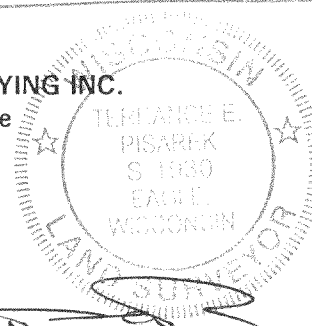

THIS IS NOT AN ORIGINAL SURVEY UNLESS THE SEAL IS RED.

JOB NUMBER

PWW 00025

418-1791