

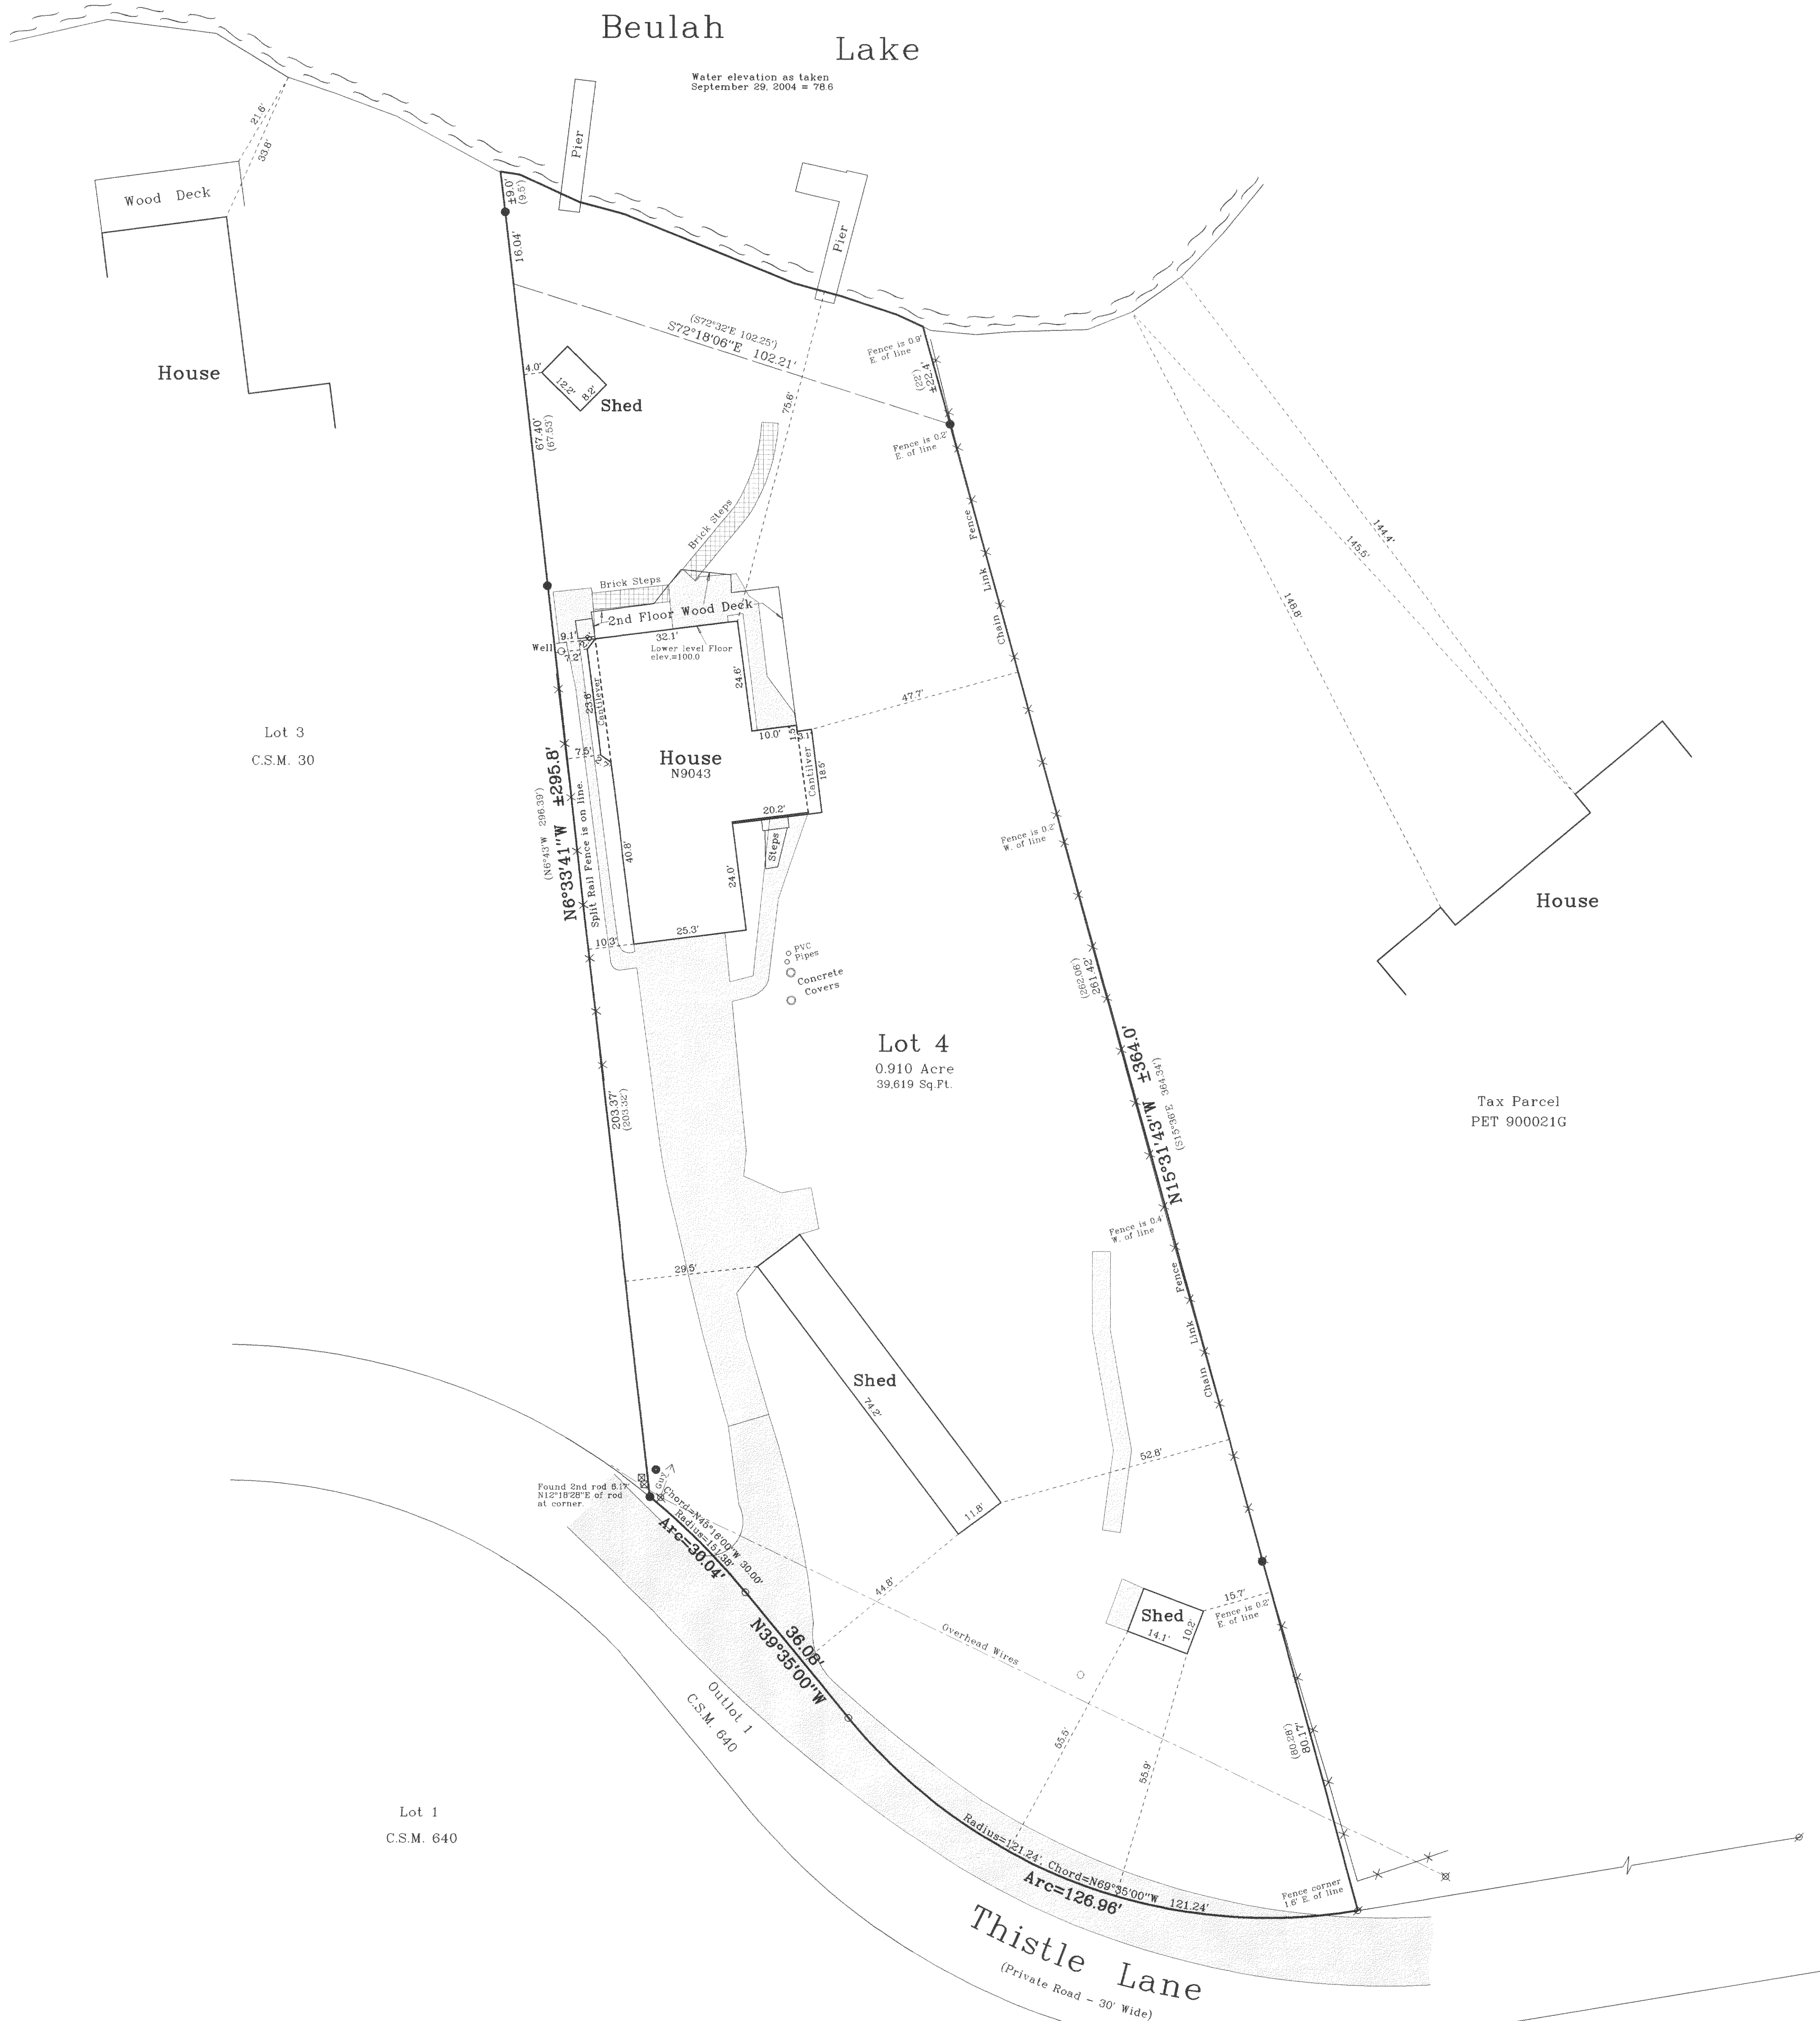


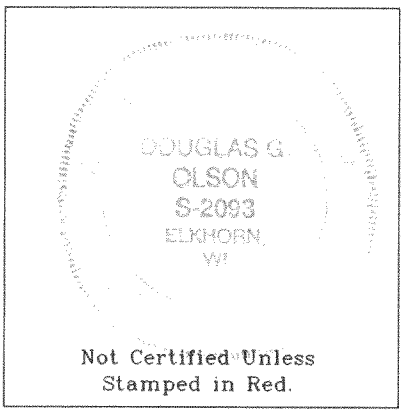


Plat of Survey

of
Lot 4 of Certified Survey Map No. 30,
recorded in Vol. 1 of Certified Survey Maps of Walworth County on
Page 30 and located in the Northeast 1/4 and the Southeast 1/4
of Section 9, Town 4 North, Range 18 East, Town of East Troy,
Walworth County, Wisconsin.

Surveyed for: **Dennis & Judy Smalley**
N9043 East Shore Road
East Troy, Wisconsin, 53120

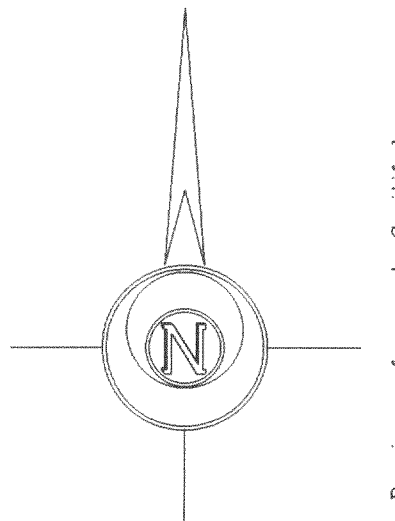

Notes: 1) This survey plat is not
certified unless signed
and sealed in red ink.
2) This survey is subject to Wisconsin lien laws.
This Plat of Survey is the notice of intent
to file lien. Lien waiver required.

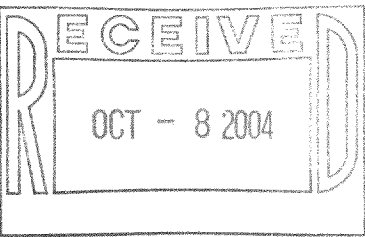


Copyright © 2004 by Jensen & Olson Land Surveying, LLC.
All rights reserved. No part of this survey plat may be reproduced
or transmitted in any form by any means - graphic, electronic, or
mechanical, including photocopying, tracing, or information storage
and retrieval systems - without permission in writing from Douglas
G. Olson, Jensen & Olson Land Surveying, LLC.

I, Douglas G. Olson, Wisconsin Registered Land Surveyor,
do hereby certify that this survey was performed by me or under my
direction in full compliance with the owner's/agent's instructions
and Chapter A-E 7 of the Wisconsin Administrative Code "Minimum
Standards for Property Surveys", and that this map is an accurate
representation thereof to the best of my knowledge and belief.

Douglas G. Olson
Wisconsin Registered Land Surveyor - 2093

Survey date: September 29, 2004
Revisions:

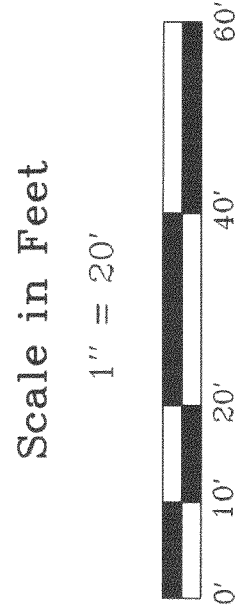

Jensen & Olson Land Surveying, LLC

45 South Wisconsin Street P.O. Box 322
Elkhorn, Wisconsin, 53121
Telephone: (262) 723-3434
Facsimile: (262) 723-8044

Legend

- Found Iron Pipe
- Set Cotton Spindle
- Recorded Information
- Utility Pole
- Septic Vent
- Asphalt Surface
- Concrete Surface

Sheet 1 of 1 Sheets:

Job Reference Number

2004.148

2004.148

PA 30.0004

418-1793