

PLAT OF SURVEY
OF

LOTS 17, 18 & 19, BLOCK 5, WILMER GROVE BEACH, LOCATED IN THE EAST 1/2 OF SECTION 18,
T. 4 N., R. 18 E. OF THE 4TH P.M., TOWNSHIP OF EAST TROY, COUNTY OF WALWORTH, WISCONSIN.

I HEREBY CERTIFY THAT I HAVE SURVEYED THE LAND DESCRIBED ABOVE AND THAT THE PLAT
DRAWN HEREON IS A CORRECT REPRESENTATION OF SAID SURVEY.



John F. Degen

5-7-73

JOHN F. DEGEN, LAND SURVEYOR #242
589 N. PINE ST., BURLINGTON, WISCONSIN.

SCALE 1" EQUALS 30'

○ DENOTES IRON PIPE STAKE

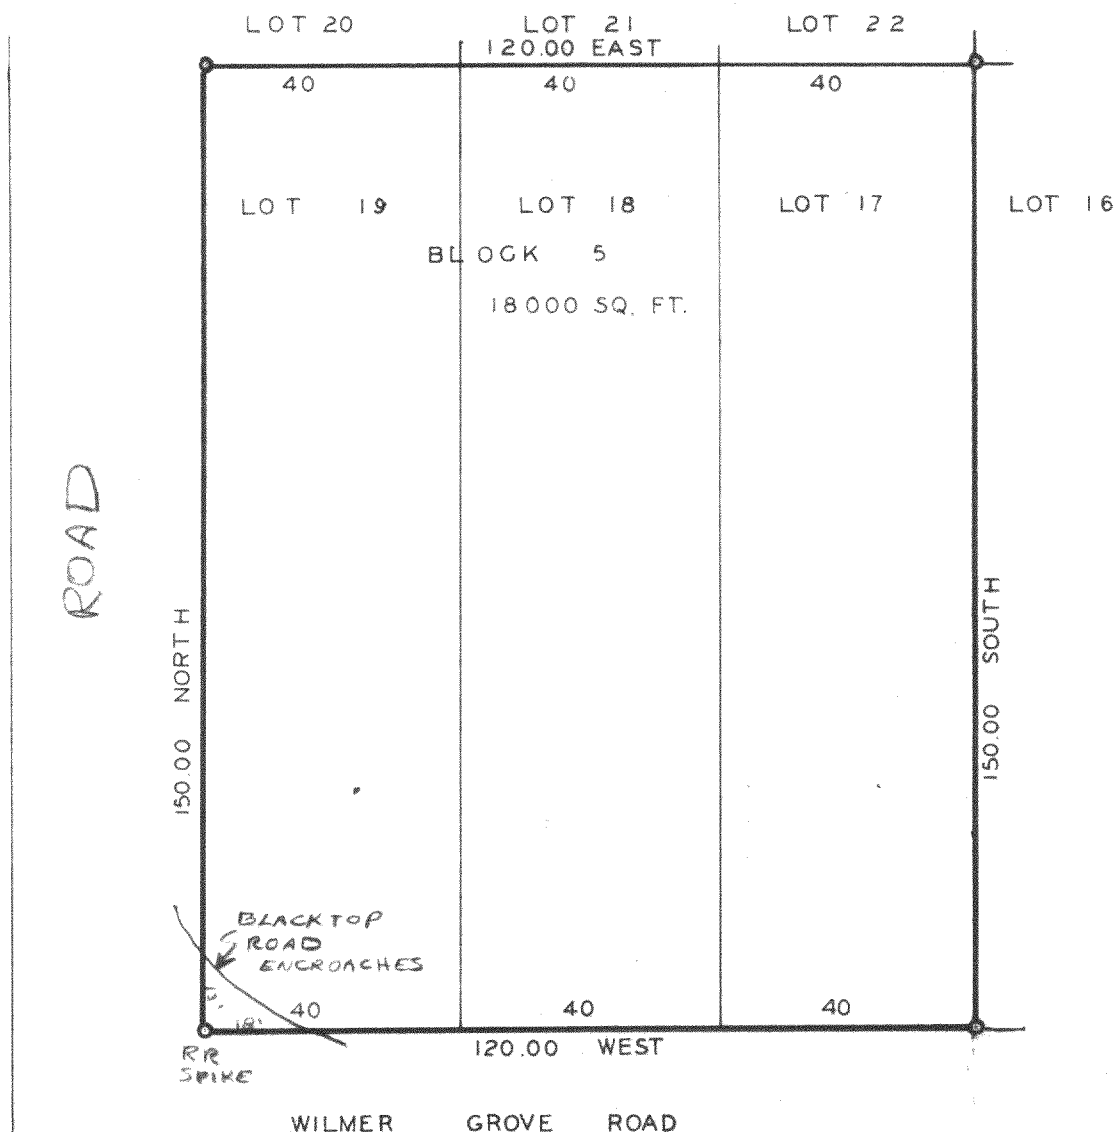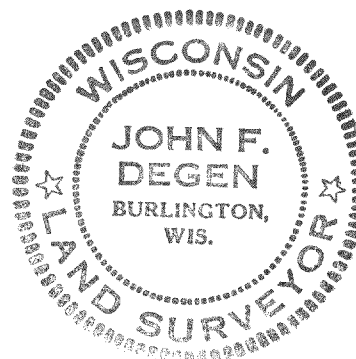

418-180

5-7-73 DRAWER 1-C-4 22