


PREPARED FOR:
SHERYL & BRIAN DUFEK

PLAT OF SURVEY

LOCATION:
W 933 MIRAMAR DRIVE


LEGAL DESCRIPTION: LOT 7, BLOCK 1, MIRAMAR SUBDIVISION, BEING A PART OF SECTIONS 10 & 11,
TOWNSHIP 4 NORTH, RANGE 18 EAST, TOWN OF EAST TROY, COUNTY OF WALWORTH, STATE OF WISCONSIN.

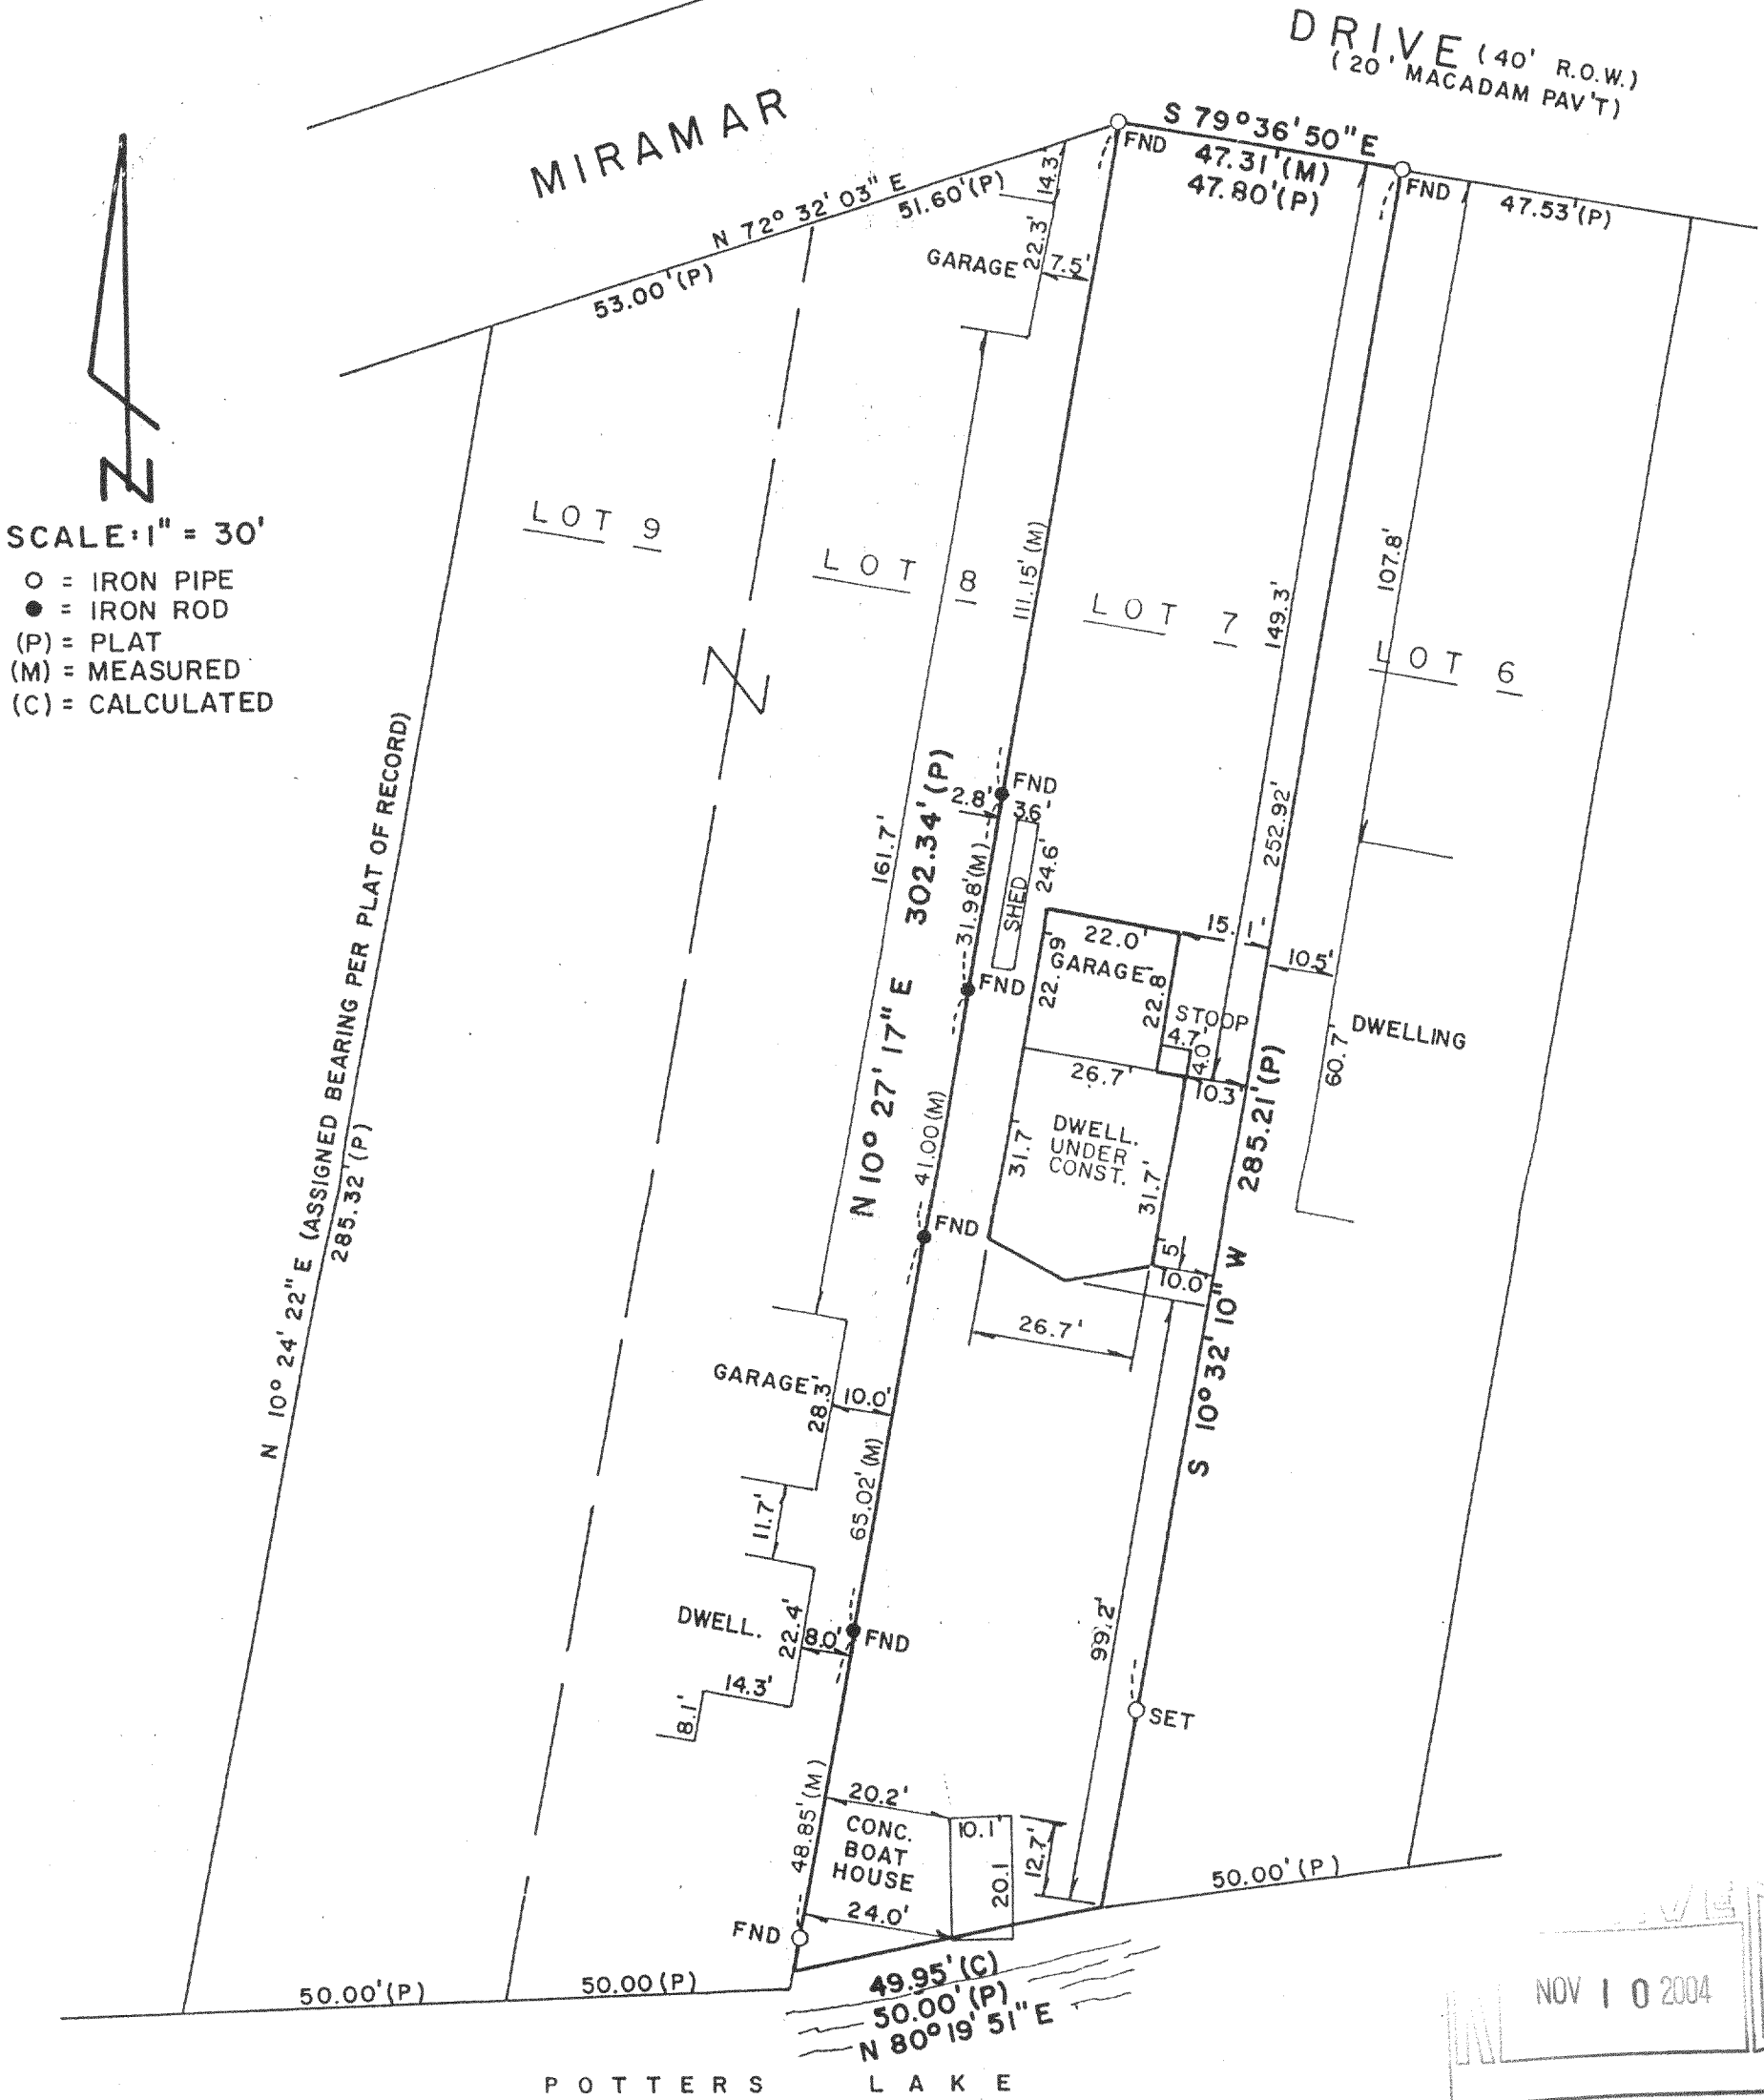

I HEREBY CERTIFY THAT I HAVE SURVEYED THE ABOVE DESCRIBED PROPERTY AND THAT THE ABOVE MAP IS A TRUE REPRESENTATION THEREOF AND SHOWS THE SIZE AND LOCATION OF THE PROPERTY, ITS EXTERIOR BOUNDARIES, THE LOCATION OF ALL VISIBLE STRUCTURES AND DIMENSIONS OF ALL PRINCIPAL BUILDINGS THEREON, BOUNDARY FENCES, APPARENT EASEMENTS AND ROADWAYS AND VISIBLE ENCROACHMENTS, IF ANY.

THIS SURVEY IS MADE FOR THE EXCLUSIVE USE OF THE PRESENT OWNERS OF THE PROPERTY AND THOSE WHO PURCHASE, MORTGAGE OR GUARANTEE THE TITLE THERETO WITHIN ONE (1) YEAR FROM DATE HEREOF.

LYNN B. DAILEY
REGISTERED LAND SURVEYOR S-1562

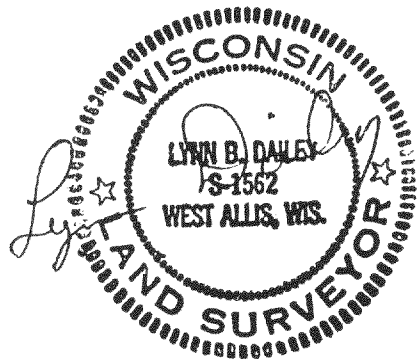

PMR 00006

418-1810