

Miramar Drive (40' Wide)

Plat of Survey

of
Lot 6 of Block 1 of Miramar Subdivision,
located in the Northeast 1/4 and the Southeast 1/4 of Section
10, Town 4 North, Range 18 East, Town of East Troy, Walworth
County, Wisconsin.

Survey for: **Thomas Prindable**
120 North LaSalle Street • Suite 3100
Chicago, Illinois 60602

Lot 8 Lot 7 **Lot 6** Lot 5 Lot 4

Lot 6
0.309 Acre
13,458 Sq.Ft.

House
W929

Garage


Shed

Wood Deck



Brick Steps

Brick Patio

Aluminum Pier

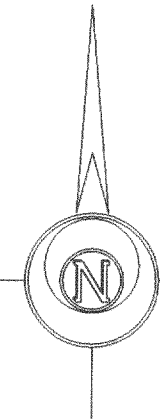

Bearings reference to previous
surveys of record.

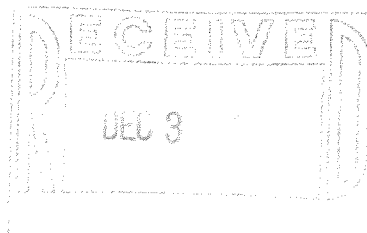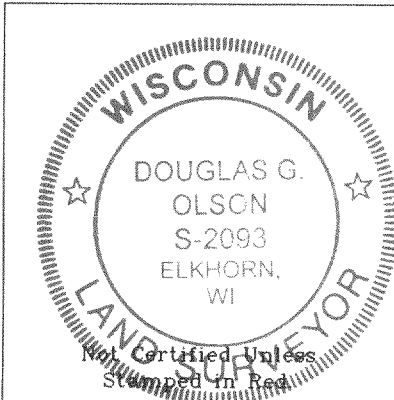

- Notes: 1) This survey plat is not certified unless signed and sealed in red ink.
2) This survey is subject to Wisconsin lien laws. This Plat of Survey is the notice of intent to file lien. Lien waiver required.

Copyright © 2004 by Jensen & Olson Land Surveying, LLC.

All rights reserved. No part of this survey plat may be reproduced or transmitted in any form by any means - graphic, electronic, or mechanical, including photocopying, tracing, or information storage and retrieval systems - without permission in writing from Douglas G. Olson, Jensen & Olson Land Surveying, LLC.

I hereby certify that I have surveyed the above described property and the map hereon is correct to the best of my professional knowledge and belief and shows the size and location of the property, its exterior boundaries, the location and dimensions of all visible structures thereon, boundary fences, apparent easements and roadways and visible encroachments, if any.
This survey is made for the exclusive use of the present owners of property, and also those who purchase, mortgage or guarantee title thereto, within one year from the date hereof.

Douglas G. Olson
Wisconsin Registered Land Surveyor - 2093

Potters
Lake

2004.110
Sheet 1 of 1 Sheets

Job Reference Number

2004.110

Legend

- Found Iron Pipe
- Found Iron Rod
- Recorded Info. per plat
- Utility Pole (Per prior survey)
- Utility Pedestal
- Asphalt Surface
- Concrete Surface
- Brick

Jensen & Olson Land Surveying, LLC

45 South Wisconsin Street P.O. Box 322
Elkhorn, Wisconsin 53121
Telephone (262) 723-3434
Facsimile (262) 723-8044

Scale in Feet

1" = 20'



Survey Date: November 5, 2004.

Revisions:

PMR-5

418-1818