


HAROLD H. KOLB

REGISTERED PROFESSIONAL LAND SURVEYOR

LAKE GENEVA, WISCONSIN

3

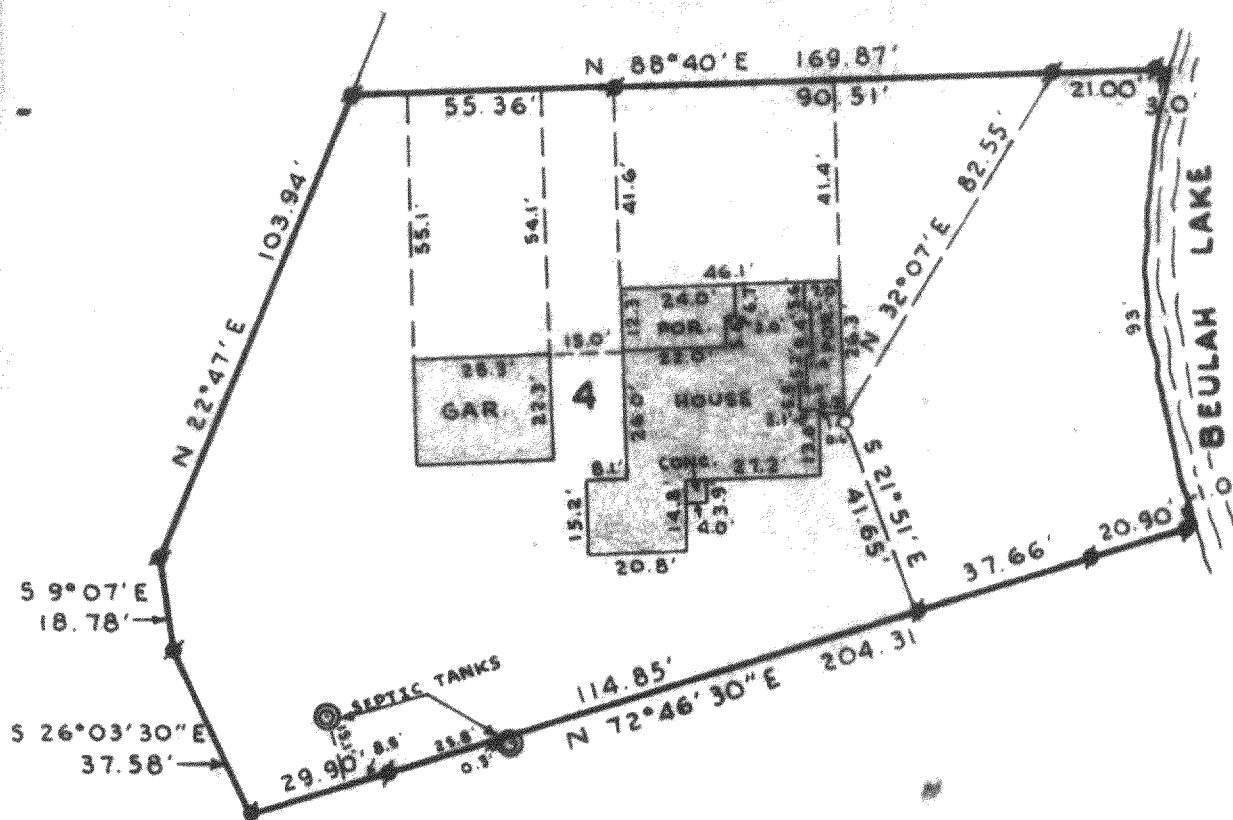

PLAT OF SURVEY OF

Lot No. 4 of Certified Survey No. 27,
as recorded in Volume 1 of Certified
Survey Maps, Page 27, Walworth County
Wisconsin.


N



SCALE: 1"=40'

LEGEND

- φ — IRON PIPE FOUND
- O — IRON PIPE PLACED
- ⦿ — Found Iron Rod
- X — SPIKE

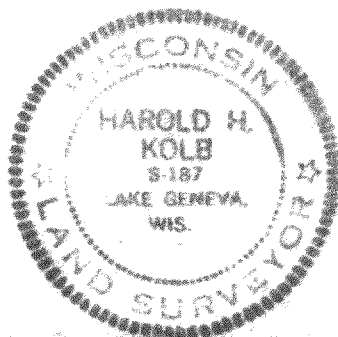

I, HAROLD H. KOLB, DO HEREBY CERTIFY THAT I HAVE
SURVEYED THE PROPERTY HEREON DESCRIBED ACCORDING
TO THE OFFICIAL RECORDS, AND THAT THE PLAT HEREON
IS A CORRECT REPRESENTATION OF THE LOT LINES.

Harold H. Kolb
HAROLD H. KOLB
WISCONSIN REGISTERED LAND SURVEYOR, S-187
DATE April 27, 1973

418-185