



SEE DETAIL FOR
LANDSCAPE PLAN

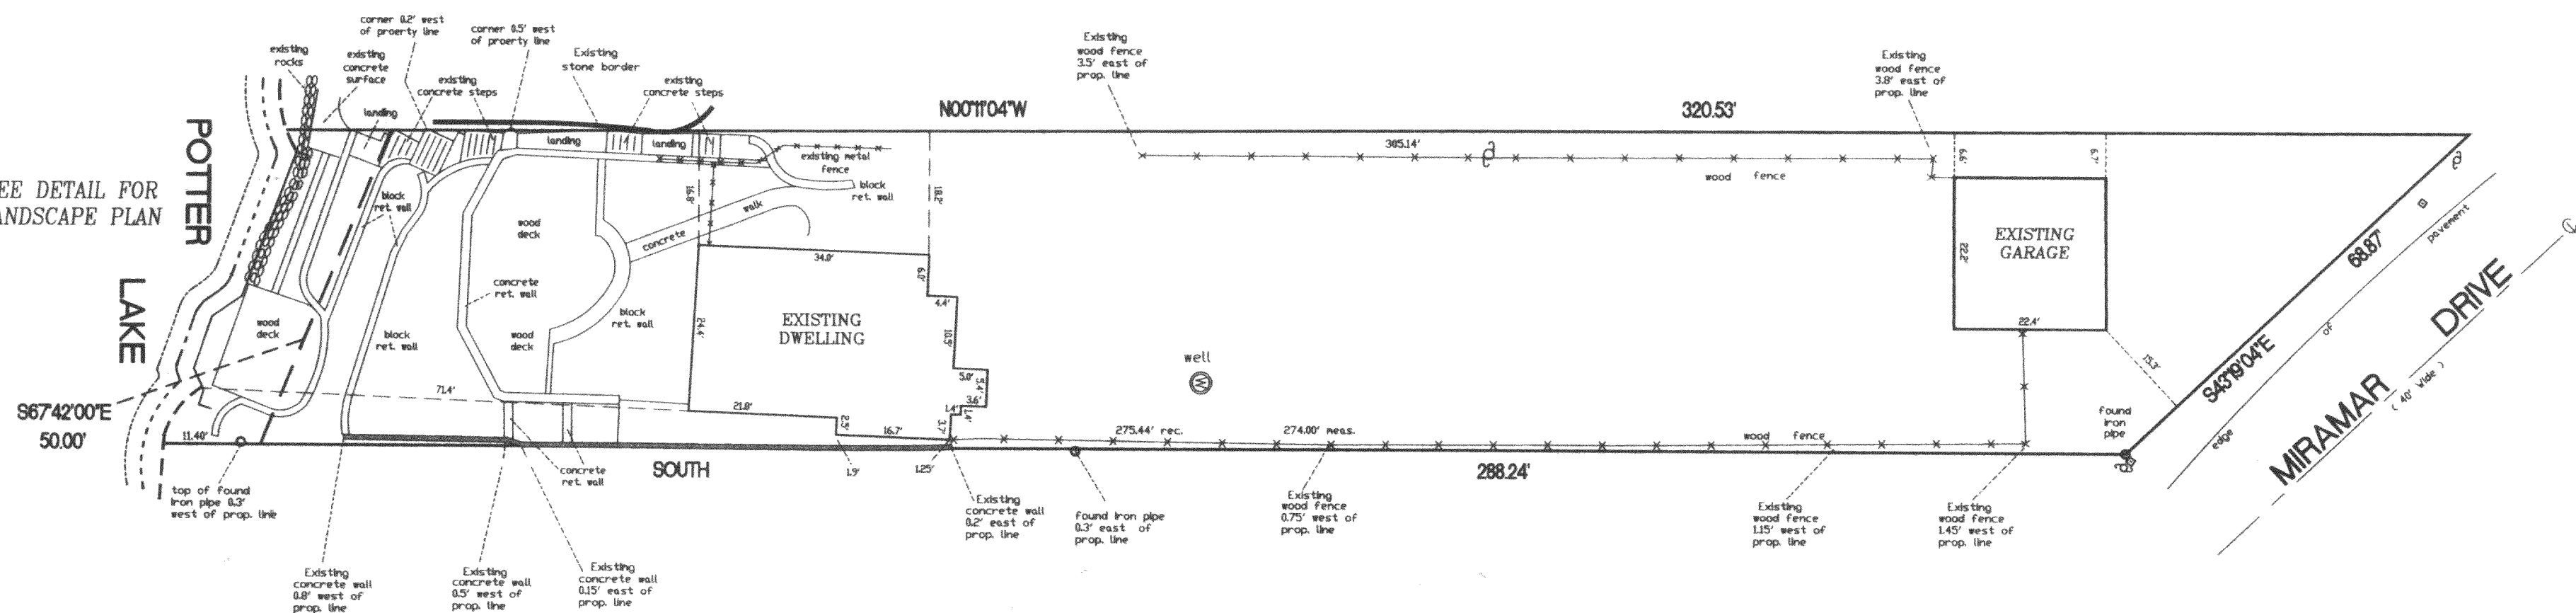


PLAT OF SURVEY

LOT 20, BLOCK 1, MIRAMAR SUBDIVISION,
being a part of the East 1/2 of Section 10 and the
West 1/2 of Section 11, Town 4 North, Range 18
East, in the Town of East Troy, Walworth County,
Wisconsin.

Address: W985 Miramar Road

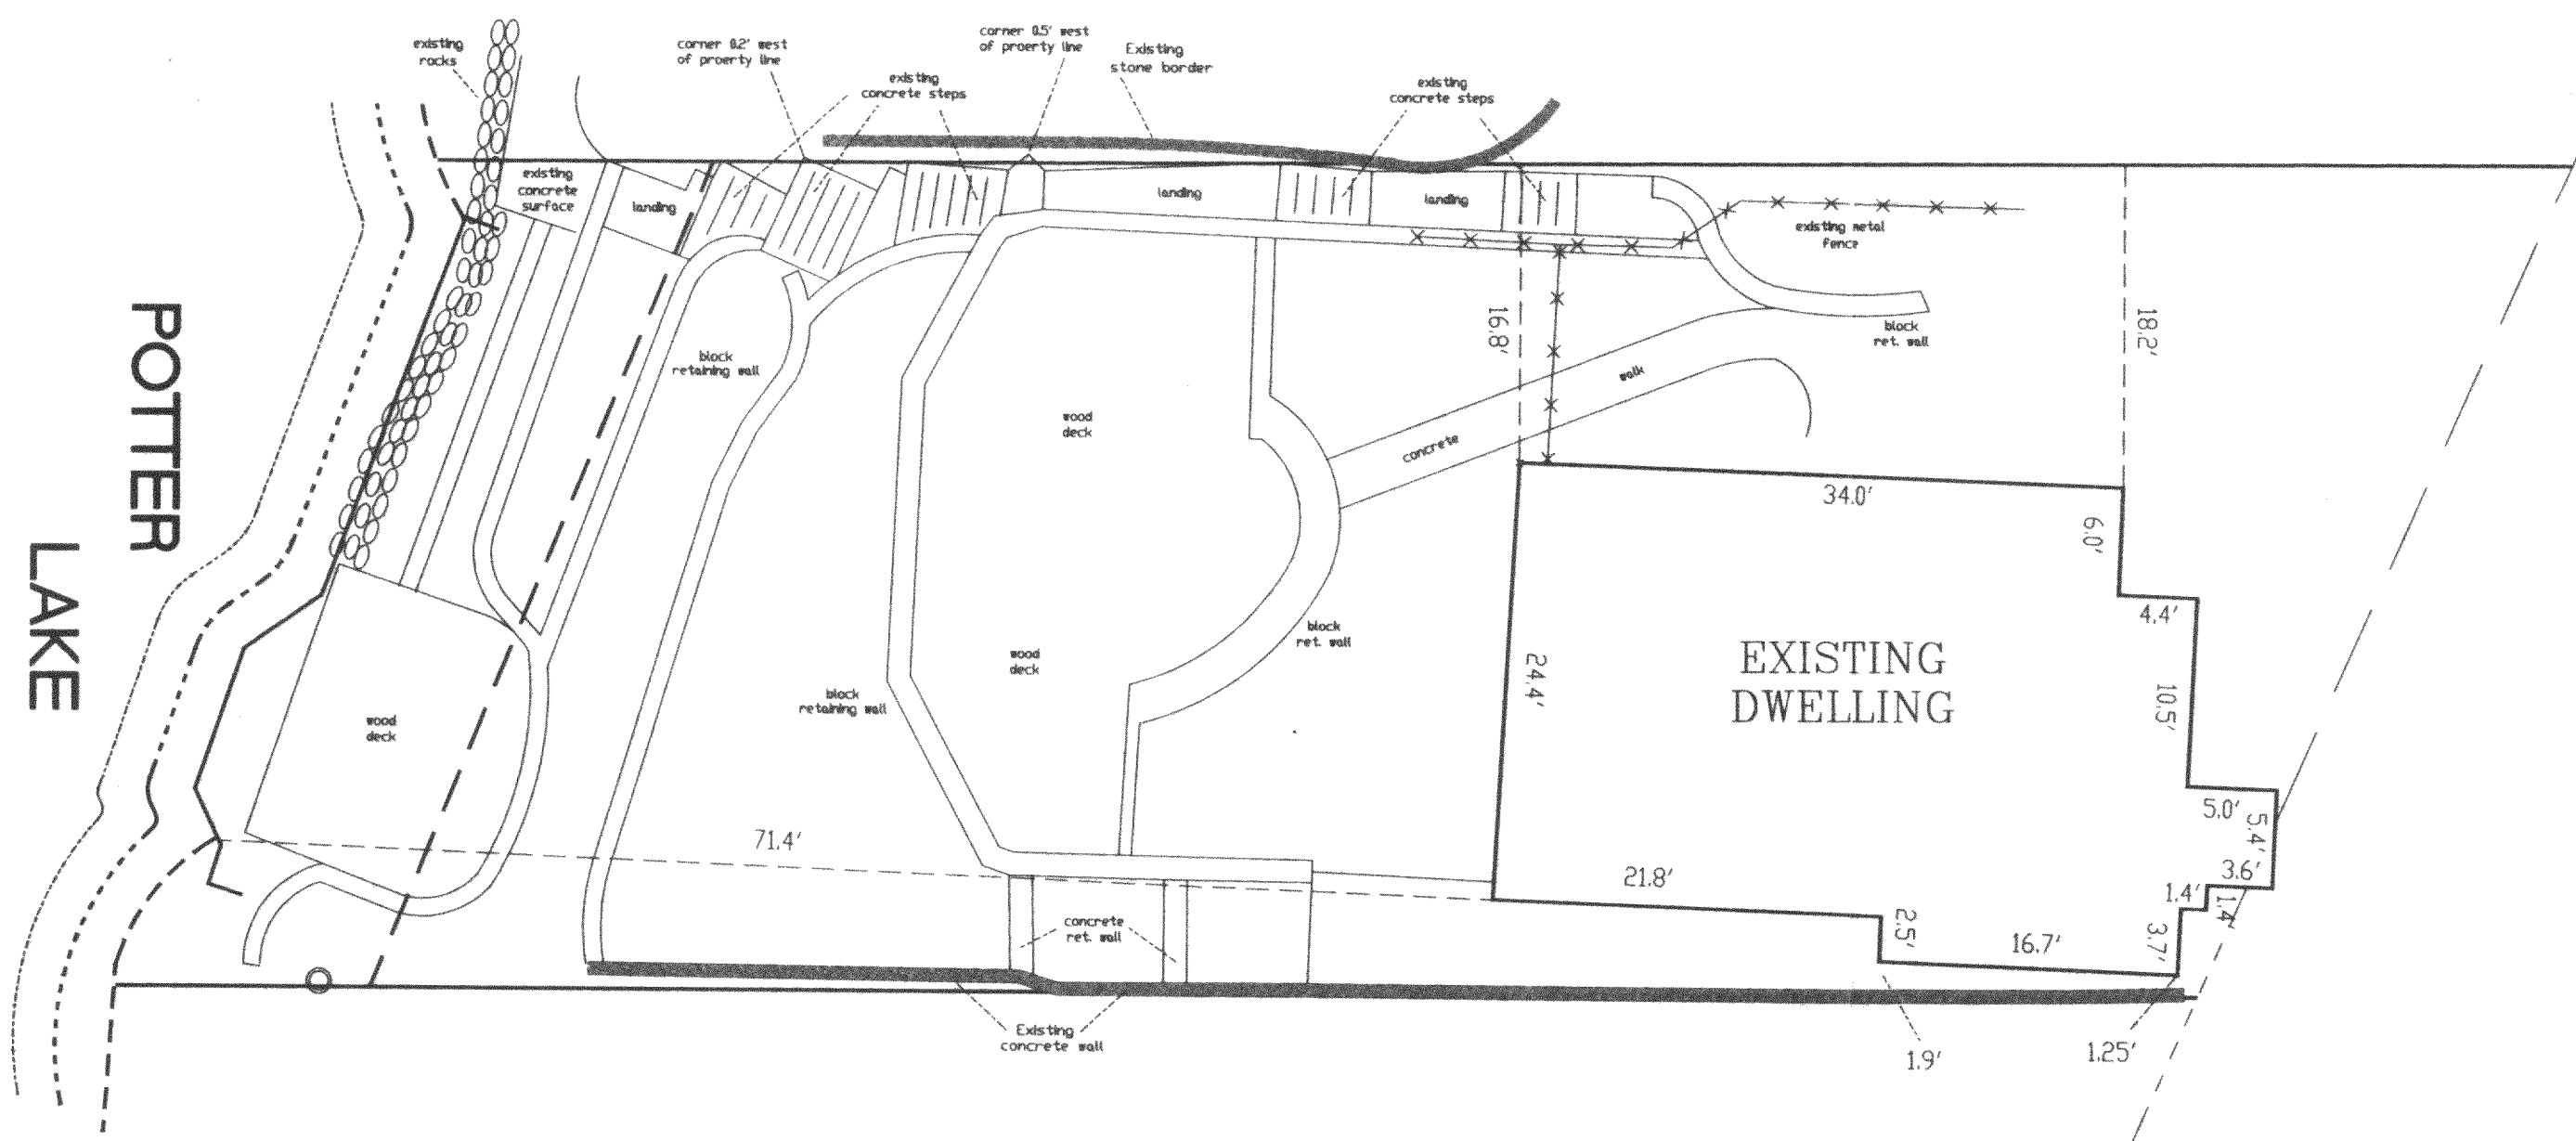

LANDSCAPE DETAIL
DETAIL : 1" = 10'

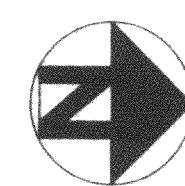


Area of Property = 14,207 Sq. Ft.


■ - Denotes Existing Utility Box

⊙ - Denotes Existing Power Pole

GRAPHIC SCALE

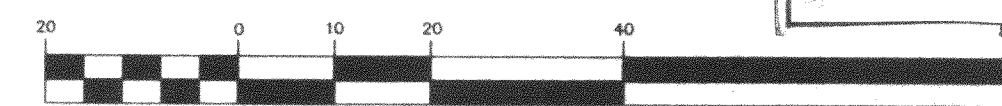

(IN FEET)
1 inch = 20 ft.

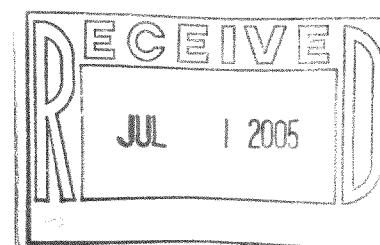

SURVEYING ASSOCIATES, INC. MEMBER NATIONAL SOCIETY OF LAND SURVEYORS AND AMERICAN SOCIETY OF SURVEYING AND MAPPING 2504 North 100th Street, Wauwatosa, WI Tel: (414) 257-2222 Fax: (414) 257-2443		Scale: 1" = 20'	Date: 12-10-04	Revised:
		Project Number: 30824 Bak 452	Field Work: JTY GB	Drafted By: BJK
Project Completed For: RANDY POHL				

418-814

PMR 00000A