

PLAT OF SURVEY



Engineers • Land Surveyors • Environmental Scientists
801 MAIN STREET MUKWONAGO, WISCONSIN 53149 (262)363-2004

FOR: JEFFREY W. CARSTENS



DATE: 8-17-05

DESCRIPTION:


BEING ALL OF LOTS 3, 4 AND 5 OF BLOCK 11 OF MIRIMAR SUBDIVISION,
A SUBDIVISION IN SECTION 10 AND 11, TOWN 4 NORTH, RANGE 18 EAST,
TOWN OF EAST TROY, WALWORTH COUNTY, WISCONSIN.

LEGEND

- 1/2" IRON ROD
- 1" FOUND IRON PIPE
- 1" SET PIPE
- FENCE

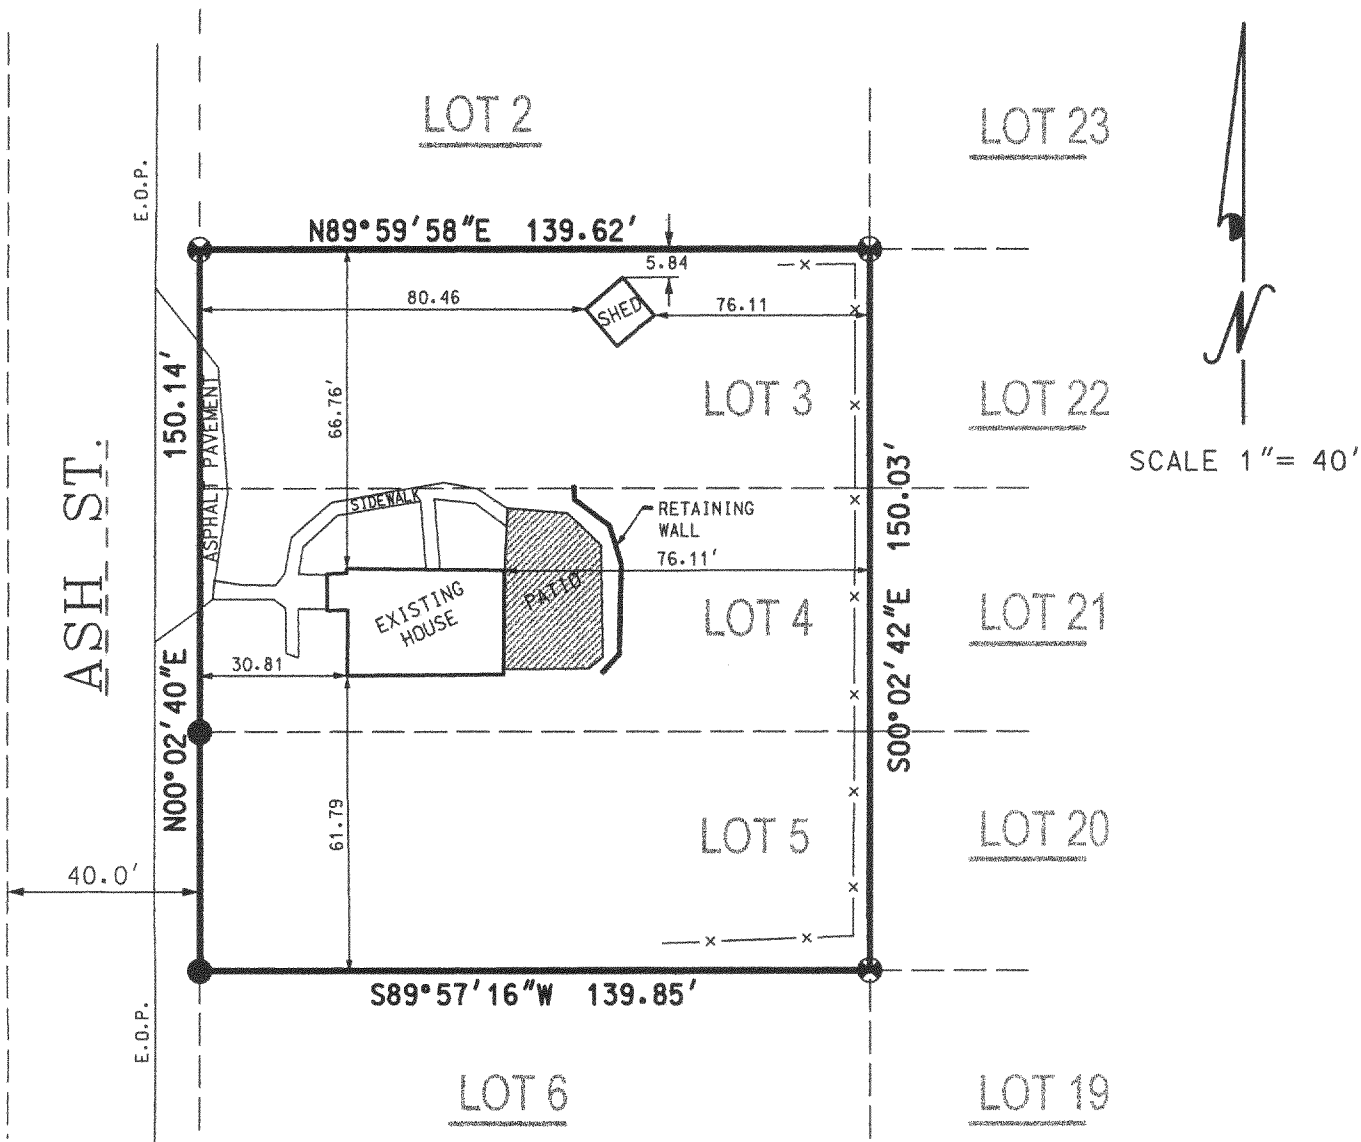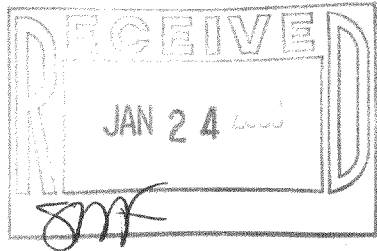

I PAUL H. VAN HENKELUM R.L.S. # 1931 HEREBY
CERTIFY THAT THIS SURVEY WAS MADE IN
ACCORDANCE WITH THE MINIMUM STANDARDS FOR
PROPERTY SURVEYS (CHAPTER A-E7) STATE OF
WISCONSIN AND HAS BEEN PREPARED UNDER MY
DIRECTION AND CONTROL AND IS CORRECT TO THE
BEST OF MY KNOWLEDGE AND BELIEF.

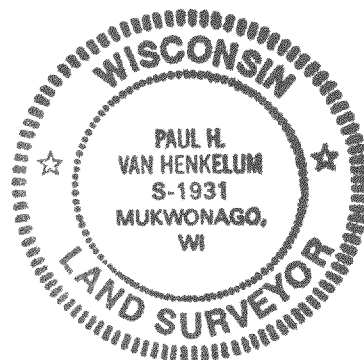

PAUL H. VAN HENKELUM, R.L.S. #1931
1-PROJECTS/2005/05-192/05192SURVEY 8-18-05

PMR-113A

418-1887