



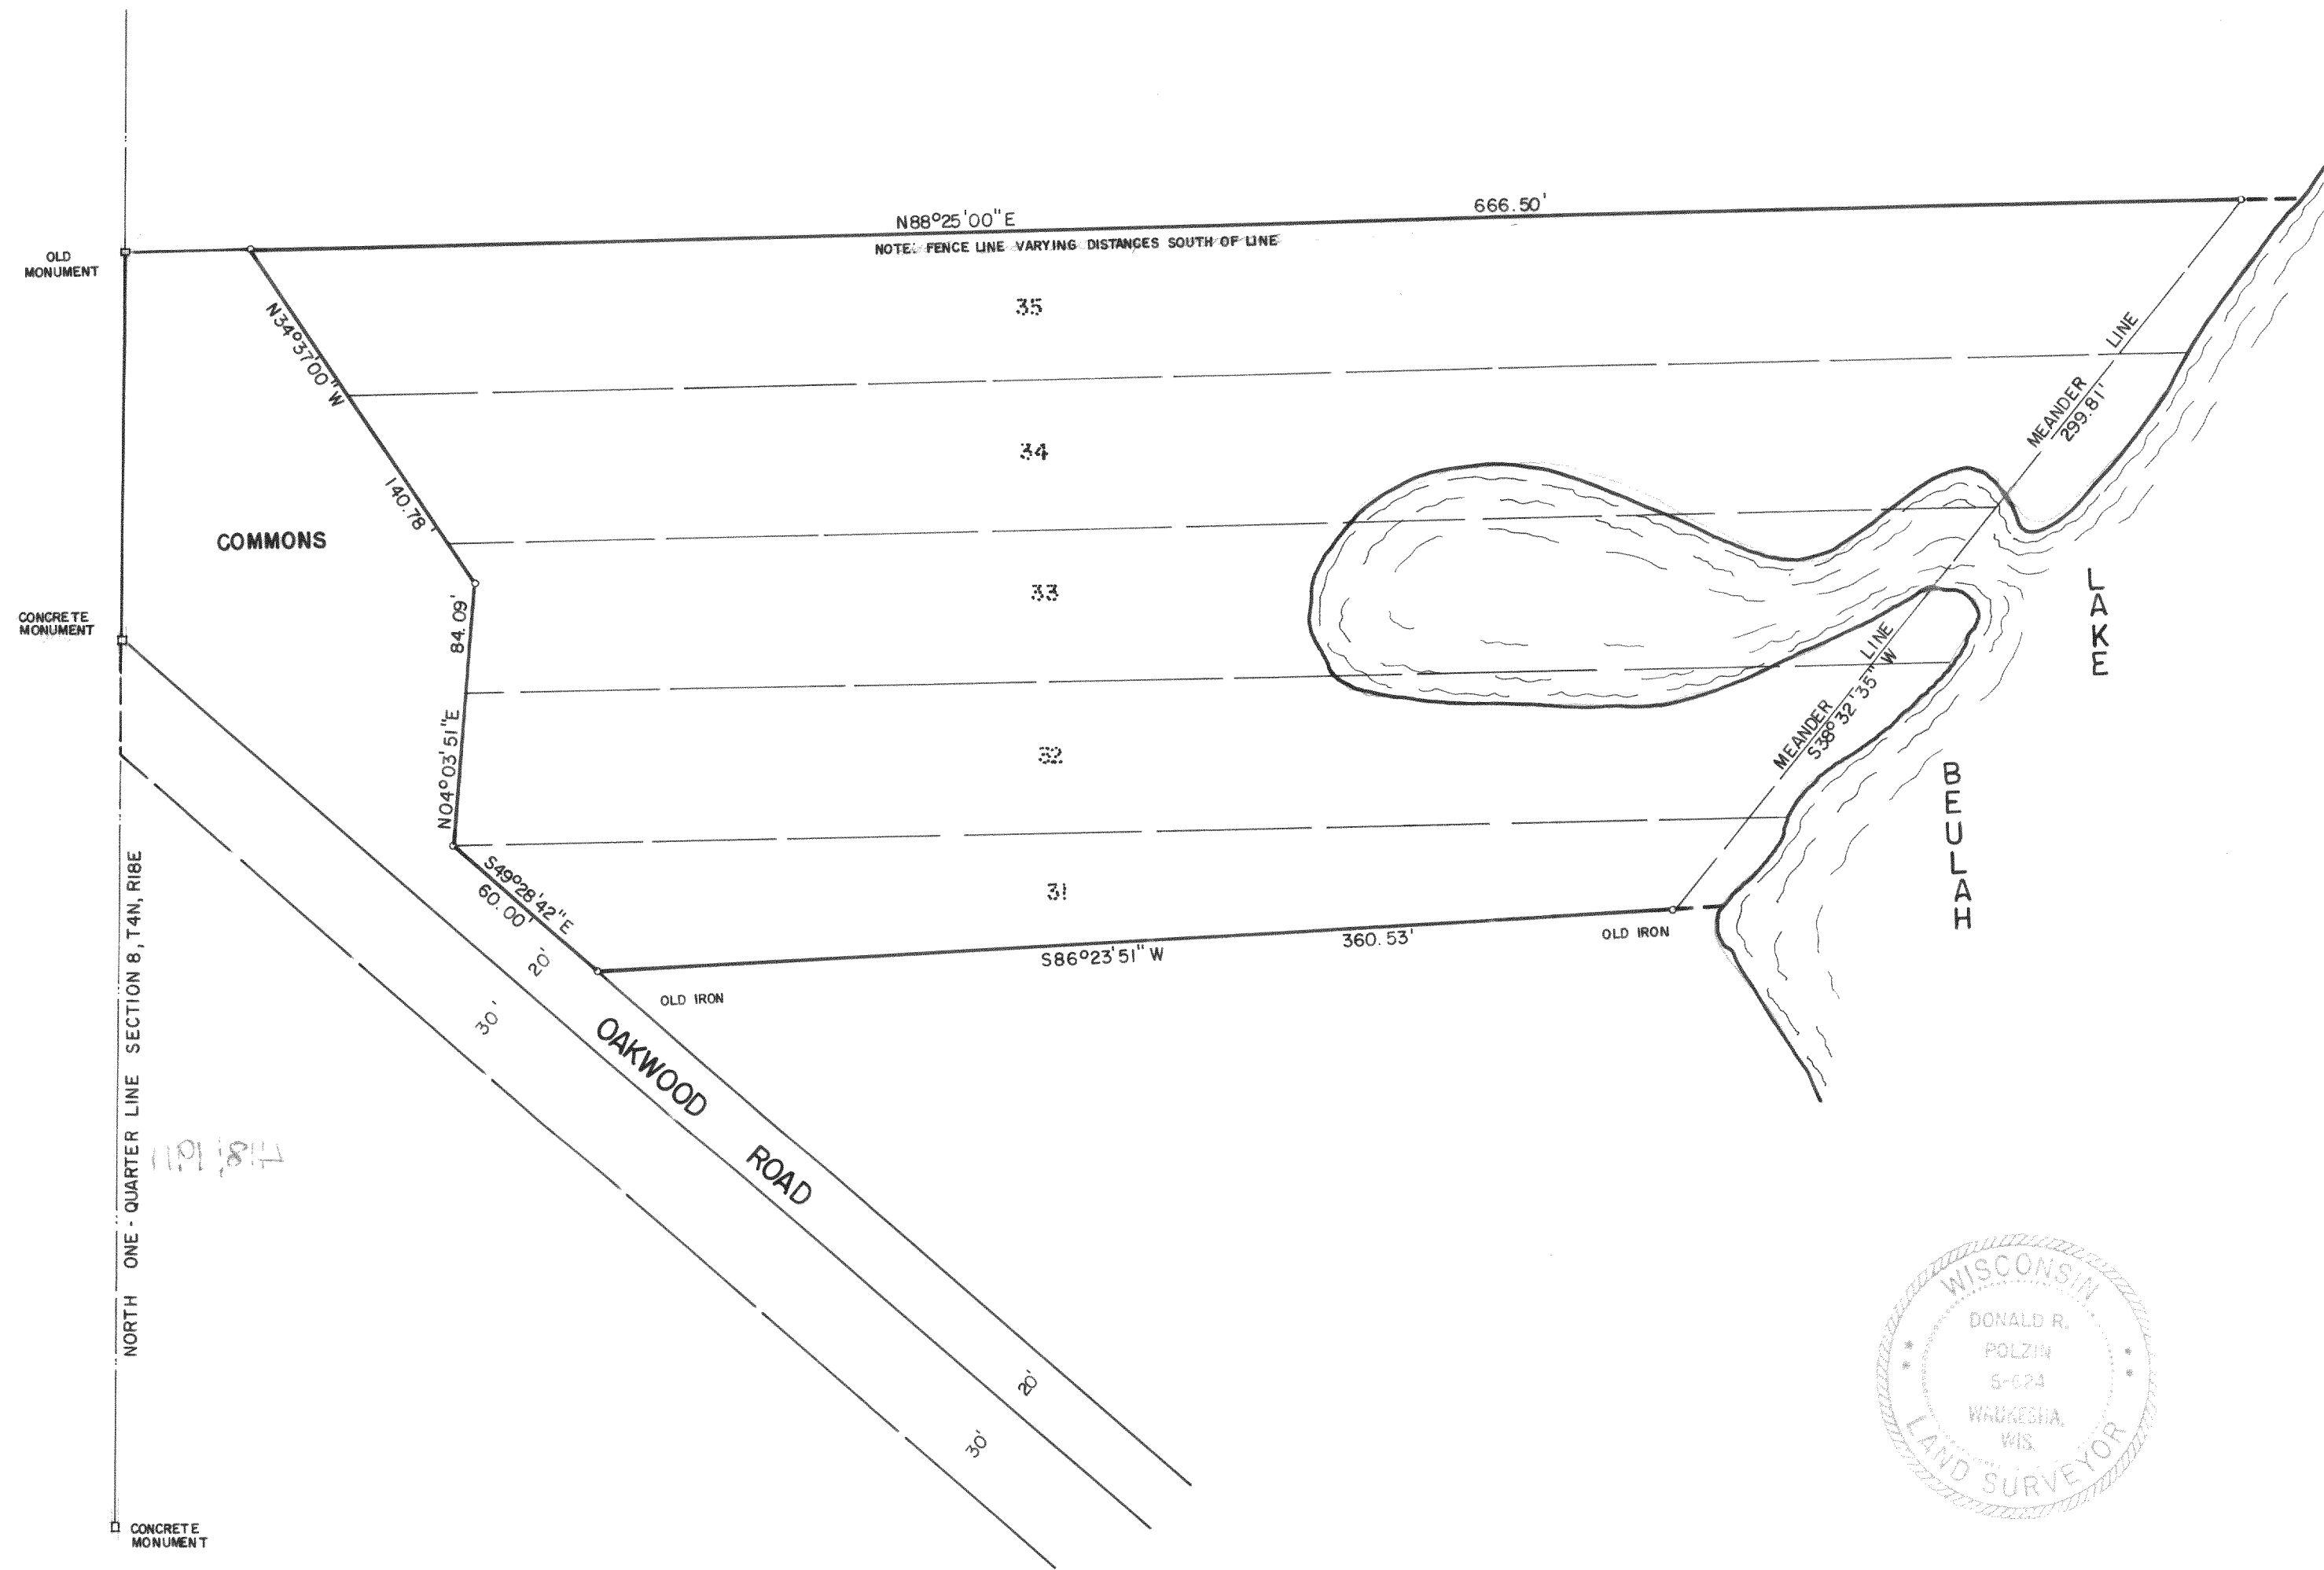


SCALE 1" = 50'
 ○ INDICATES IRON PIPE

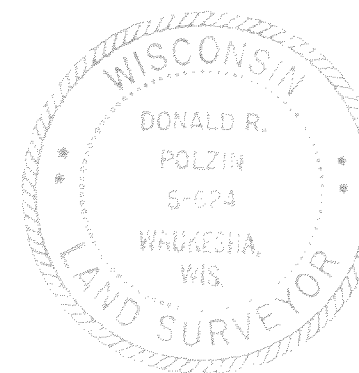

We, Hoffmann, Polzin and Associates, do hereby certify that we have surveyed the lots indicated hereon as shown and that the plat herewith drawn is a correct representation of said survey.

Donald R. Polzin
 Hoffmann, Polzin and Associates, Inc.
 Donald R. Polzin, Vice-Pres. S-624

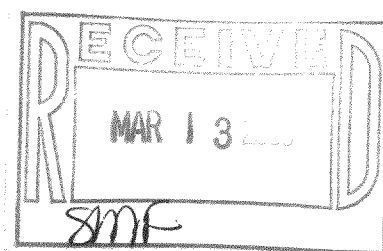

PLAT OF SURVEY

FOR
 JOHN A. KIRCHGEORG

PART - NE 1/4 SECTION 8, T.4 N, R.18 E.
 TOWN OF TROY, WALWORTH CO, WIS.
 LOTS 31 THRU 35, OAKWOOD PARK SUBD.

BY - HOFFMANN, POLZIN & ASSOCIATES, Inc.
 WAUKESHA COUNTY SURVEYORS OFFICE
 LIBERTY 7-7242 WAUKESHA, WIS.

MEMBER - AM. CONGRESS OF SURVEYING & MAPPING SURVEYS GUARANTEED BY LLOYDS OF LONDON
 DRAWN BY - CHECKED BY - DATE - NUMBER -

POP - 19

418-1011

418-1911