


SURVEY FOR: SPRING VALLEY HOMES
LOCATION: STONE SCHOOL ROAD

HANSEN

"RECERTIFICATION"
PLAT OF SURVEY

DESCRIPTION: LOT 7 GREYSTONE ESTATES, BEING A PART OF THE SOUTHEAST 1/4 AND SOUTH-WEST 1/4 OF THE NORTHWEST 1/4 AND PART OF THE NORTHEAST AND NORTHWEST 1/4 OF THE SOUTHWEST 1/4 OF SECTION 14, TOWN 4 NORTH, RANGE 18 EAST, IN THE TOWN OF TROY, WALWORTH COUNTY, WISCONSIN.

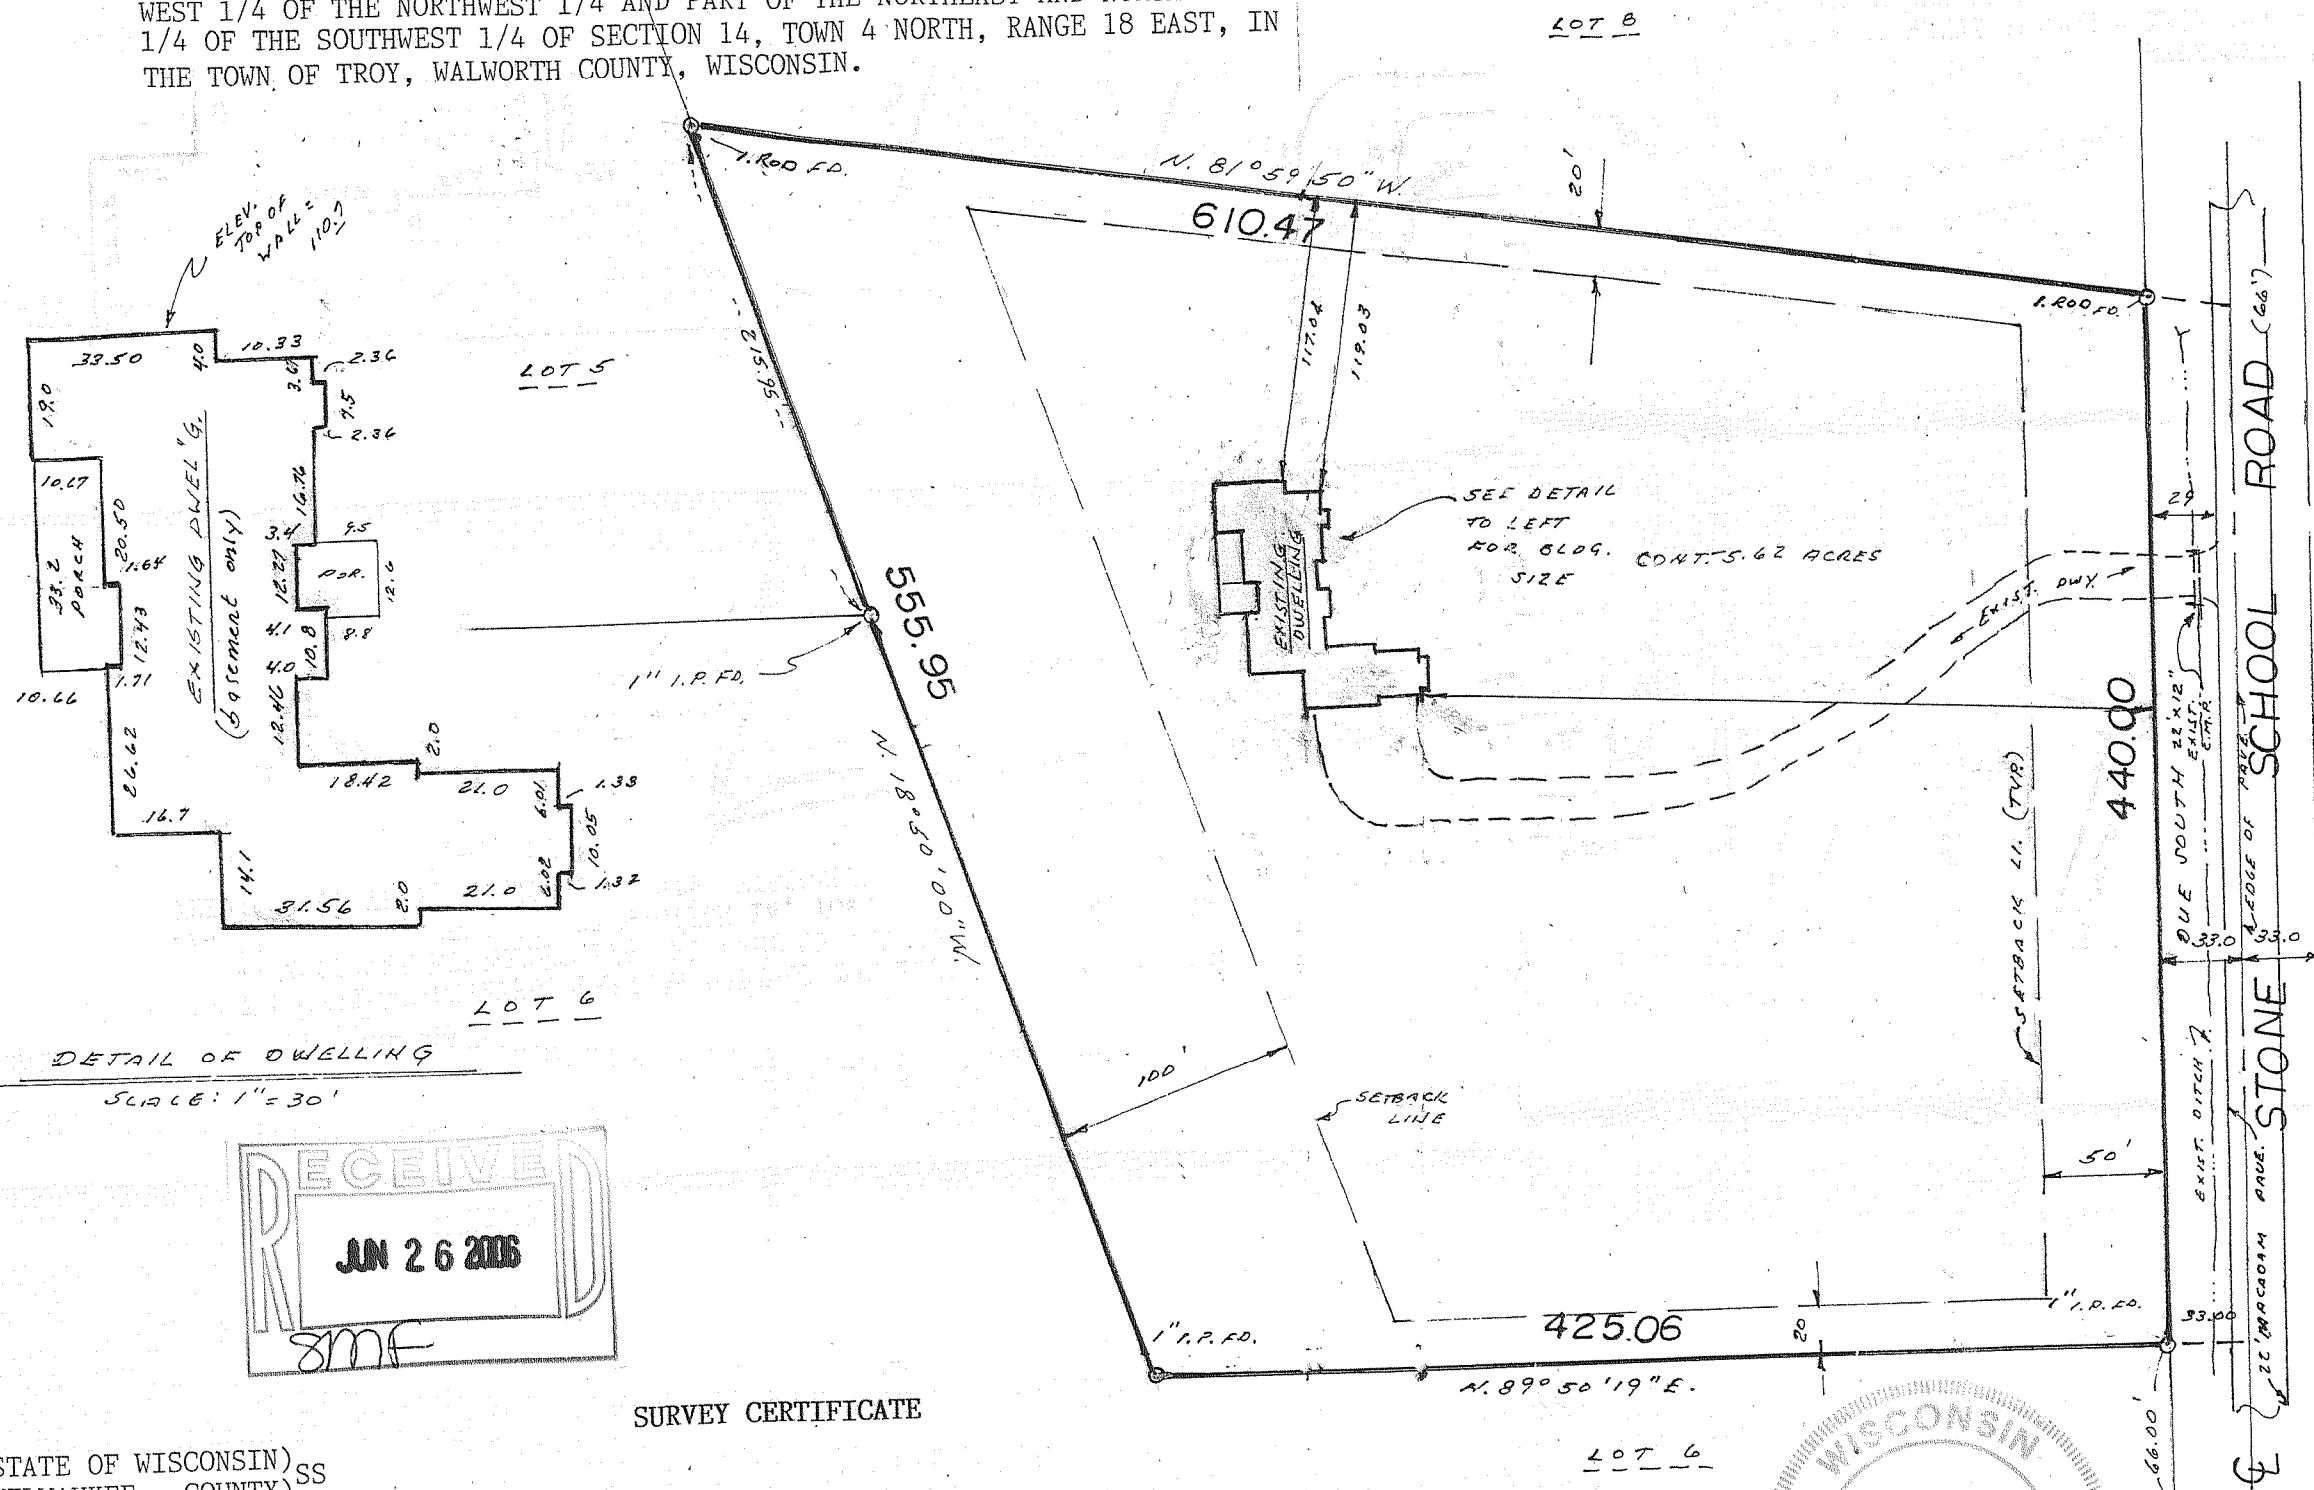

SURVEY CERTIFICATE

STATE OF WISCONSIN)
MILWAUKEE COUNTY)

SS
WE, INTERLINE SURVEY SERVICES, INC., CERTIFY THAT WE HAVE SURVEYED THE ABOVE DESCRIBED PROPERTY AND THE ABOVE MAP IS A TRUE REPRESENTATION THEREOF, AND SHOWS THE SIZE AND LOCATION OF THE PROPERTY, ITS EXTERIOR BOUNDARIES, THE LOCATION AND DIMENSIONS OF ALL VISIBLE STRUCTURES THEREON, FENCES, APPARENT EASEMENTS AND ROADWAYS AND VISIBLE ENCROACHMENTS, IF ANY.

THIS SURVEY IS MADE FOR THE EXCLUSIVE USE OF THE PRESENT OWNERS OF THE PROPERTY, AND ALSO THOSE WHO PURCHASE, MORTGAGE, OR GUARANTEE THE TITLE THERETO, WITHIN ONE (1) YEAR FROM DATE HEREOF.

GARY J. SMITH
WISCONSIN REGISTERED LAND SURVEYOR

PGRE-7