


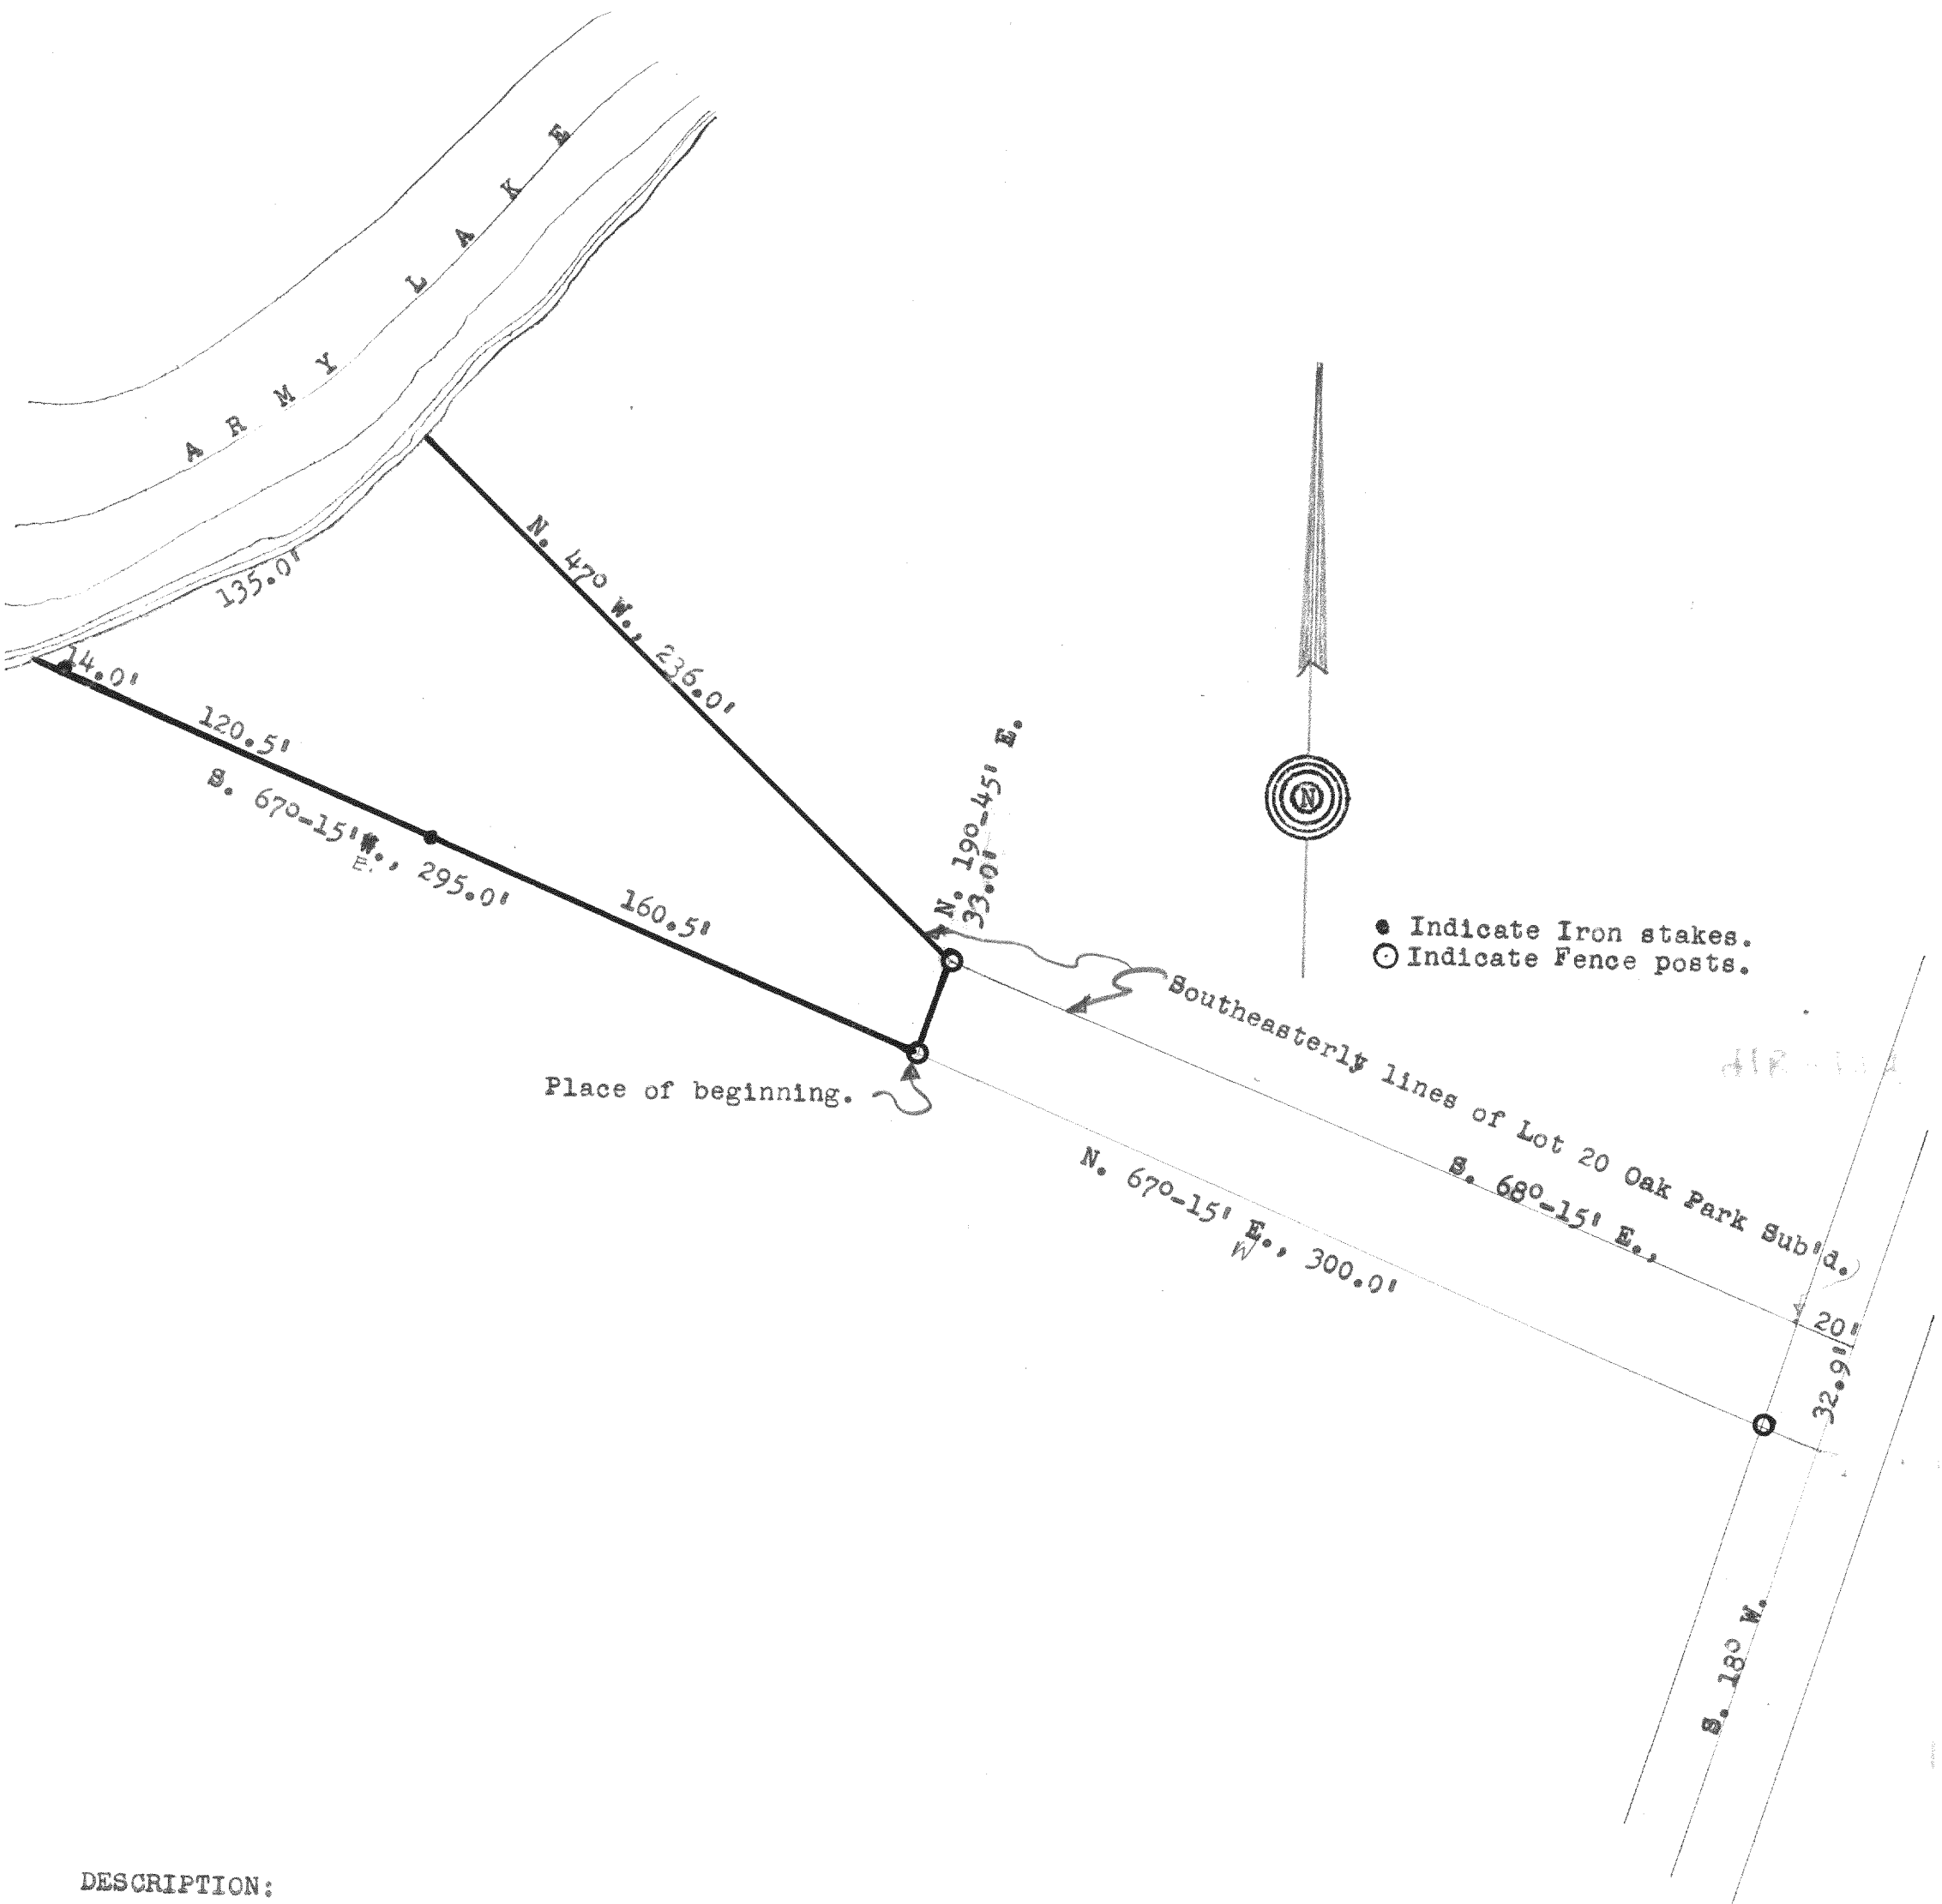

DESCRIPTION:

Commencing at the southeast corner of Lot 20 Oak Park Subdivision of a portion of Section 16, Town 4 north, Range 18 east of the 4th P.M., thence S. 68°-15' E., 20.0 feet to a point thence S. 18° W., 32.9 feet to a point, thence N. 67°-15' W., 300.0 feet to the place of beginning of this description: thence N. 190-45' E., 33.0 feet to a point, thence N. 47° W., 226.0 feet to a point in the shore of Army Lake, thence southwesterly along the shore of Army Lake 135.0 feet to a point that is 295.0 feet N. 67°-15' W., of the place of beginning, thence S. 67°-15' E., 295.0 feet to the place of beginning.

CERTIFICATE:

I, hereby certify that I, have on this the 16th day of September, 1946, surveyed the above described property according to the official records on file in the office of the Recorder of Deeds in and for Walworth County, Wisconsin, and that the above plat is a true and correct representation of the survey as completed on this day.

SIGNED AND SEALED THIS 18TH DAY OF SEPTEMBER 1946.

Joseph M. Biagi
 Joseph M. Biagi.
 Professional Engineer
 Elkhorn Wisconsin.