

PLAT OF SURVEY

ERSV


ENGINEERING, INC.

Engineers • Land Surveyors • Environmental Scientists
W232 S7530 BIG BEND DR. BIG BEND, WI 53103 (262) 662-4292

FOR: JOHN SCHULLER

DATE: 09/05/2006

DESCRIPTION: LOT 27 AND PART OF LOT 26
WILMER GROVE BEACH SUBDIVISION, LOCATED
THE EAST $\frac{1}{2}$ OF SECTION 18, TOWN 4 NORTH,
RANGE 18 EAST, TOWN OF EAST TROY,
WALWORTH COUNTY, WISCONSIN. DESCRIBED
AS FOLLOWS: BEGINNING AT THE SW CORNER
OF LOT 26; THENCE S73° 45' 30" W, 16.91';
THENCE N12° 07' 49" W, 200.60'; TO A POINT
ON A MEADNER LINE; THENCE N87° 55' 23" E
ALONG SAID MEANDER LINE, 60.13'; THENCE
LEAVING SAID MEANDER LINE S00° 30' 19" W,
41.60'; THENCE N79° 25' 16" E, 7.00';
THENCE S09° 03' 01" W, 46.23'; THENCE
S04° 59' 50" W, 52.92'; THENCE S03° 48' 56" E,
55.00' TO THE POINT OF BEGINNING. SAID
PARCEL CONTAINS 0.17 ACRES MORE OR LESS.
ALSO, CONTAINING LANDS BETWEEN THE MEANDER
LINE AND THE ORDINARY HIGH WATER MARK
OF LAKE BEULAH.

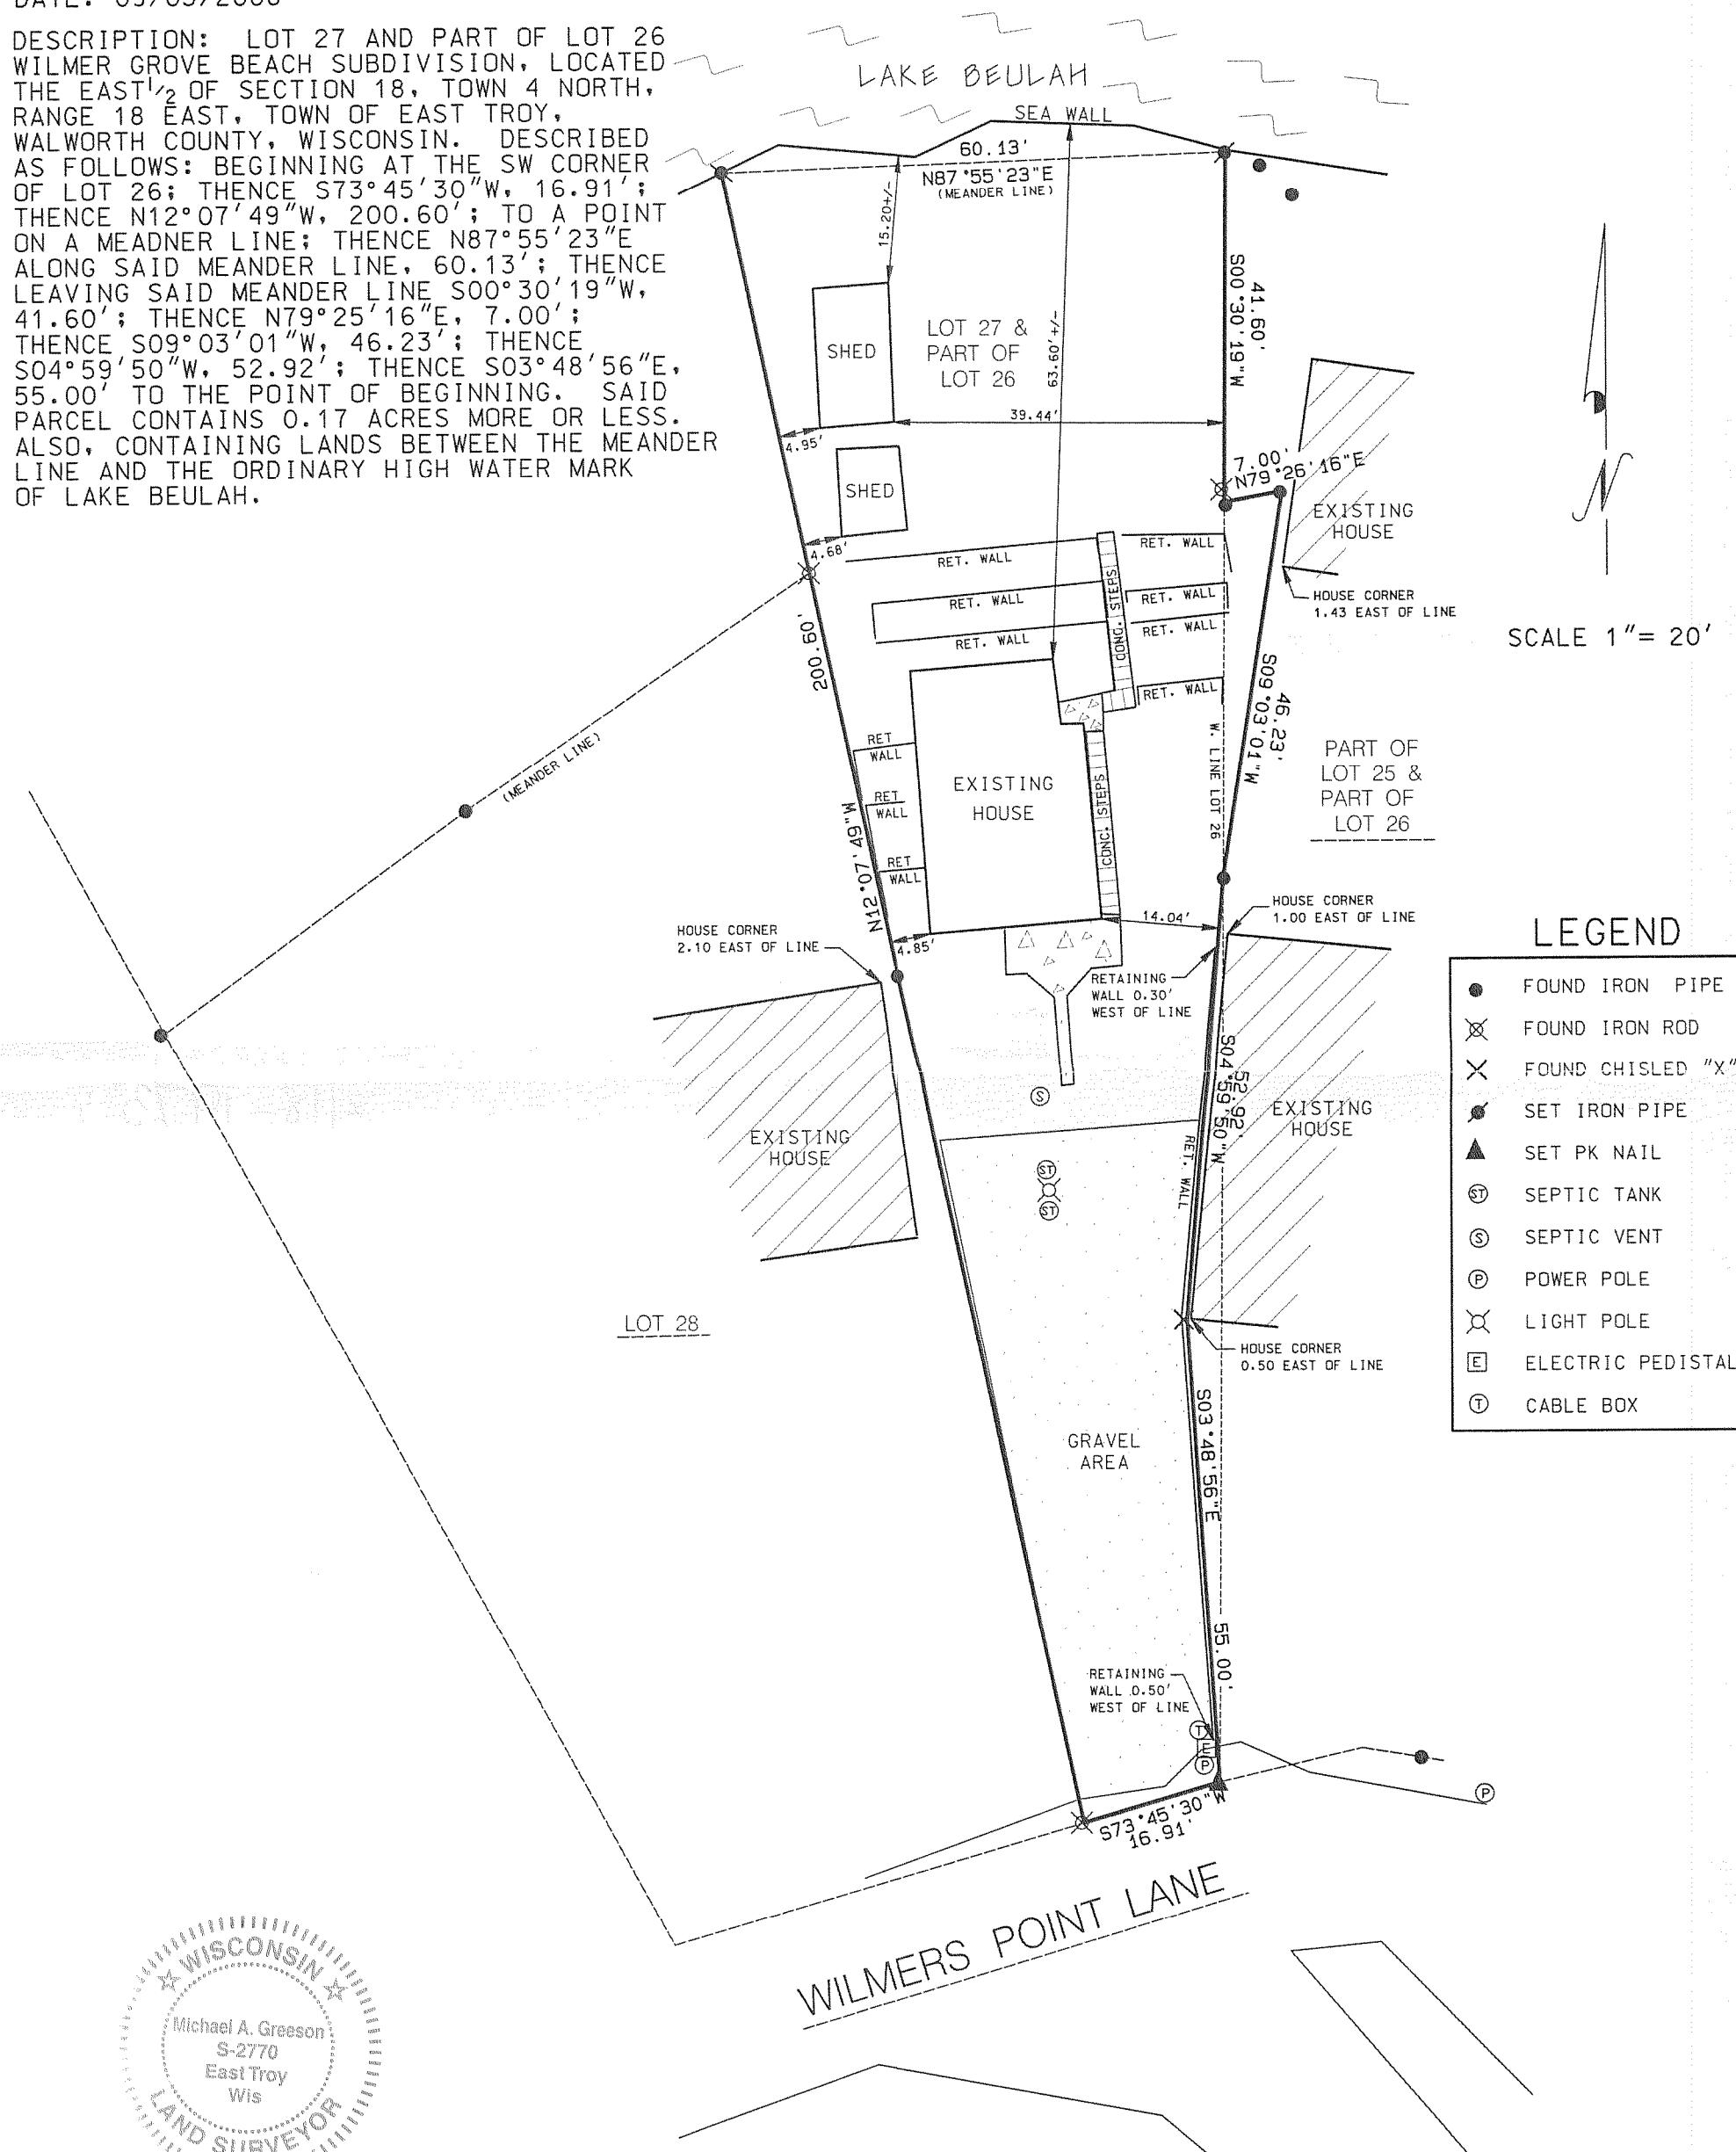

I MICHAEL A. GREESON R.L.S. # 2770 HEREBY CERTIFY THAT THIS SURVEY WAS MADE IN ACCORDANCE WITH THE MINIMUM STANDARDS FOR PROPERTY SURVEYS (CHAPTER A-E7) STATE OF WISCONSIN AND HAS BEEN PREPARED UNDER MY DIRECTION AND CONTROL AND IS CORRECT TO THE BEST OF MY KNOWLEDGE AND BELIEF.

Michael A. Greeson
MICHAEL A. GREESON, R.L.S. # 2770
RSV# 06131 SURVEY.DGN

A rectangular stamp with a decorative border. The word "RECEIVE" is printed in large, bold, capital letters across the top. Below it, the date "DEC 27 2006" is printed in a smaller, standard font. The stamp is set against a light background.

RSV# 06151SURVEY

418-1975 *adult*