

PLAT OF SURVEY

RSV

ENGINEERING, INC.

Engineers, Land Surveyors, Environmental Scientists
801 MAIN STREET MUKWONAGO, WISCONSIN 53149 (262)363-2004

DATE: 11/17/2005
DATE: 11/18/2005 -
CORRECTED SPELLING
OF MIRAMAR.
DATE: 1/4/2006
RECERT.


FOR: JIM STARK

DESCRIPTION: BEING ALL THAT PART OF LOT 23 & 24 BLOCK 13 MIRAMAR
SUBDIVISION LOCATED IN PART OF SECTION 10 & 11 TOWN 4 NORTH,
RANGE 18 EAST, TOWN OF EAST TROY, WALWORTH COUNTY, WISCONSIN.

NOTE: TOP FOOTING EL. = 96.47
TOP WALL EL. = 104.46

LEGEND

- FOUND IRON PIPE
- EXISTING TREE
SIZE AS NOTED

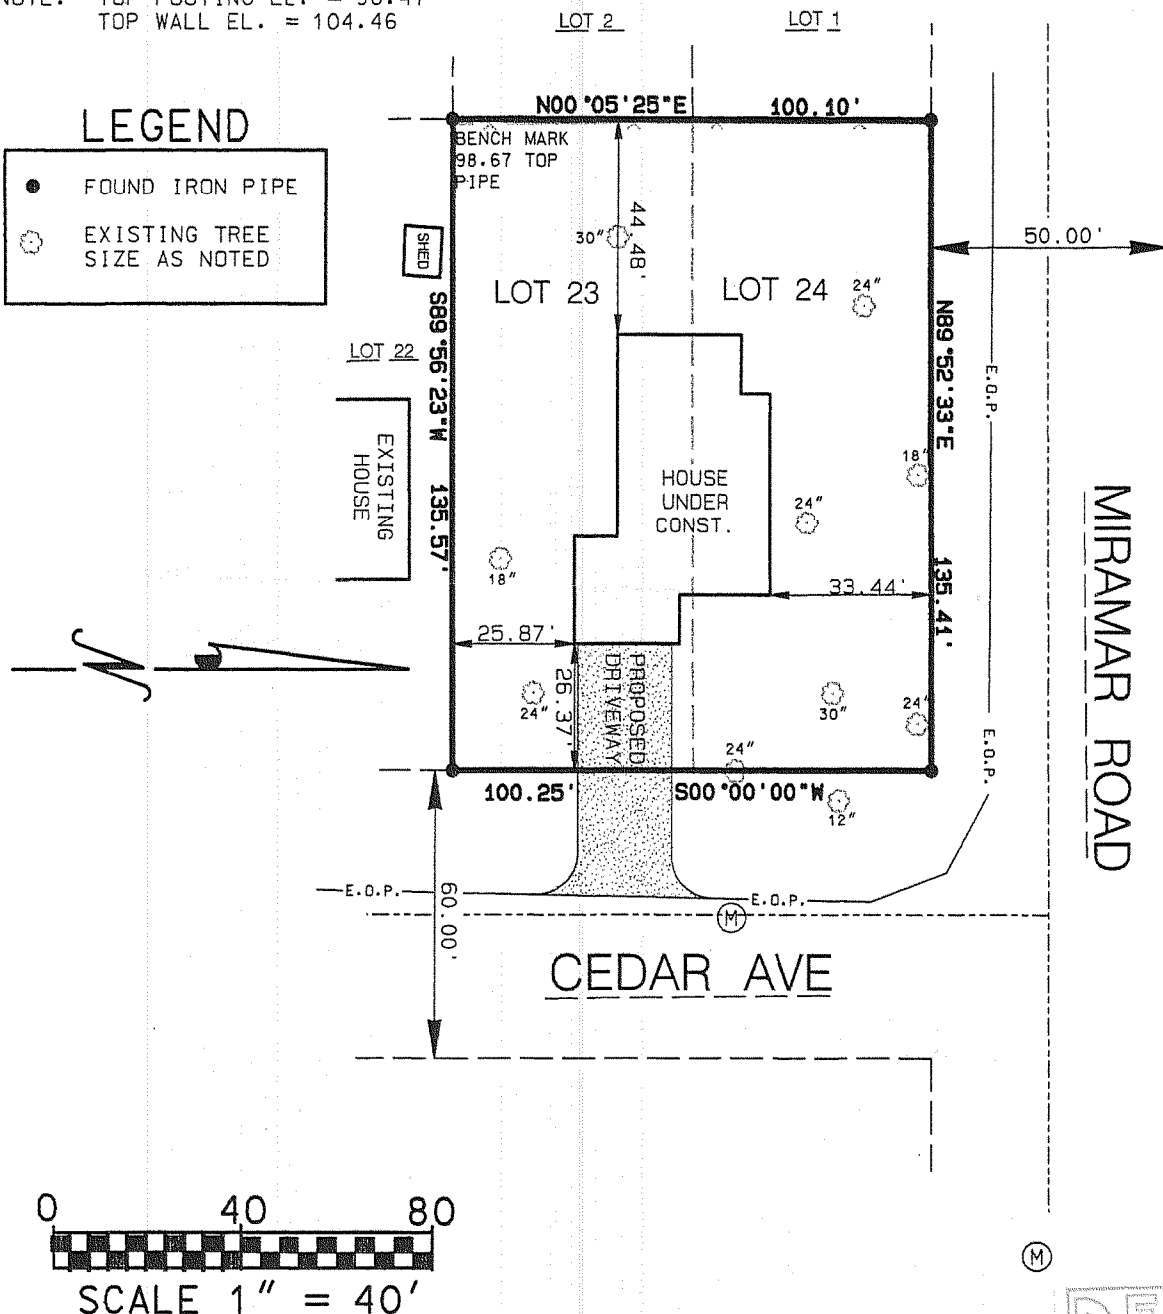

0 40 80
SCALE 1" = 40'

I PAUL H. VAN HENKELUM R.L.S. # 1931 HEREBY
CERTIFY THAT THIS SURVEY WAS MADE IN
ACCORDANCE WITH THE MINIMUM STANDARDS FOR
PROPERTY SURVEYS (CHAPTER A-E7) STATE OF
WISCONSIN AND HAS BEEN PREPARED UNDER MY
DIRECTION AND CONTROL AND IS CORRECT TO THE
BEST OF MY KNOWLEDGE AND BELIEF.

PAUL H. VAN HENKELUM, R.L.S. # 1931
RSV#05255RECERT.DGN

