

PLAT OF SURVEY



ENGINEERING, INC.


Engineers-Land Surveyors-Environmental Scientists
W232 S7530 BIG BEND DR. BIG BEND, WI 53130 (262) 662-4292

DATE: 07-14-2006-
UPDATE SURVEY

FOR: DAVID & SUE EDWARDS

DATE: 12-10-97

DESCRIPTION: LOTS 6, 7, 8 AND PART OF 9 OF OAKWOOD PARK, A SUBDIVISION LOCATED IN PART OF GOVERNMENT LOT 2 IN THE NE 1/4 OF SECTION 8, TOWN 4 NORTH, RANGE 18 EAST, TOWN OF EAST TROY, WALWORTH COUNTY, WISCONSIN, MORE PARTICULARLY DESCRIBED AS FOLLOWS: BEGINNING AT THE NORTHEAST CORNER OF SAID LOT 6, THENCE S49°34'52"E, A DISTANCE OF 169.13'; THENCE S00°00'32"W, A DISTANCE OF 231.32' TO A POINT MEANDERING THE SHORE OF LAKE BEULAH; THENCE WITH THE FOLLOWING BEARINGS AND DISTANCES ALONG A MEANDER LINE: S67°18'31"W, 52.74'; THENCE N51°04'34"W, 25.26'; THENCE N50°52'25"W, 77.88' TO A MEANDER POINT ON THE WEST LINE OF SAID LOT 6; THENCE N00°00'00"E, 296.31' TO THE POINT OF BEGINNING. ALSO INCLUDING LANDS BETWEEN THE MEANDER LINE AND THE HIGH WATER LINE OF LAKE BEULAH. SAID PARCEL CONTAINING 0.835 ACRES, MORE OR LESS.

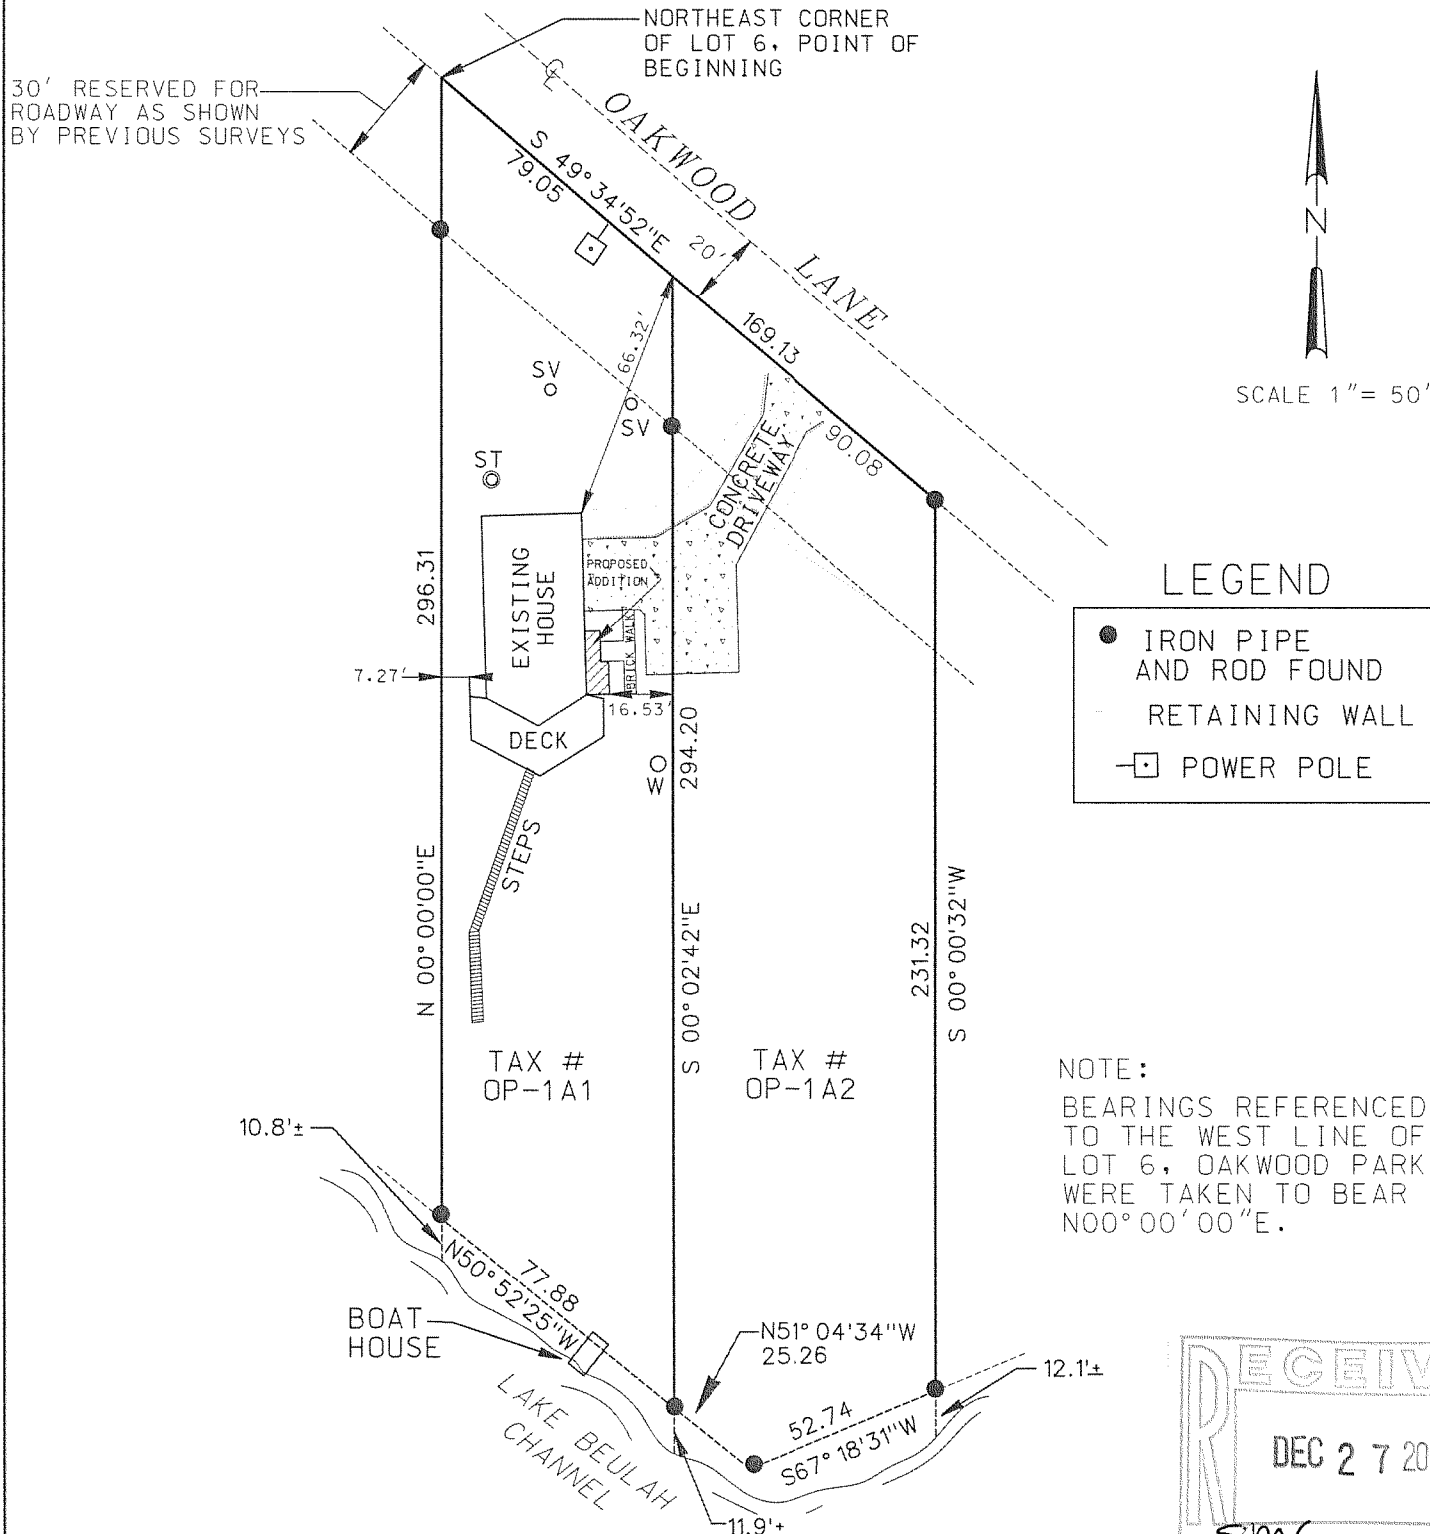

I MICHAEL A. GREESON R.L.S. # 2770 HEREBY CERTIFY THAT I HAVE SURVEYED THE ABOVE DESCRIBED PARCEL AND THAT TO THE BEST OF MY KNOWLEDGE AND BELIEF, THE ABOVE PLAT IS AN ACCURATE SURVEY AND A TRUE REPRESENTATION THEREOF AND CORRECTLY SHOWS THE EXTERIOR BOUNDARY LINES AND LOCATIONS OF BUILDINGS AND OTHER IMPROVEMENTS ON SAID PROPERTY AND THE CORRECT MEASUREMENTS THEREOF.

Michael A. Greeson

MICHAEL A. GREESON, R.L.S. # 2770
RSV# 06115.DGN (REF. #97382)

