


PLAT OF SURVEY

LOT 1, BLOCK 17, MIRAMAR ADDITION NO. 1, being a Subdivision of part of the Northwest ¼ and part of the Southwest ¼ of the Northeast ¼ of Section 10, Town 4 North, Range 18 East, Town of East Troy, Walworth County, Wisconsin.

Surveyed for: Terry Schroeder

Survey address: N9146 Elm Street

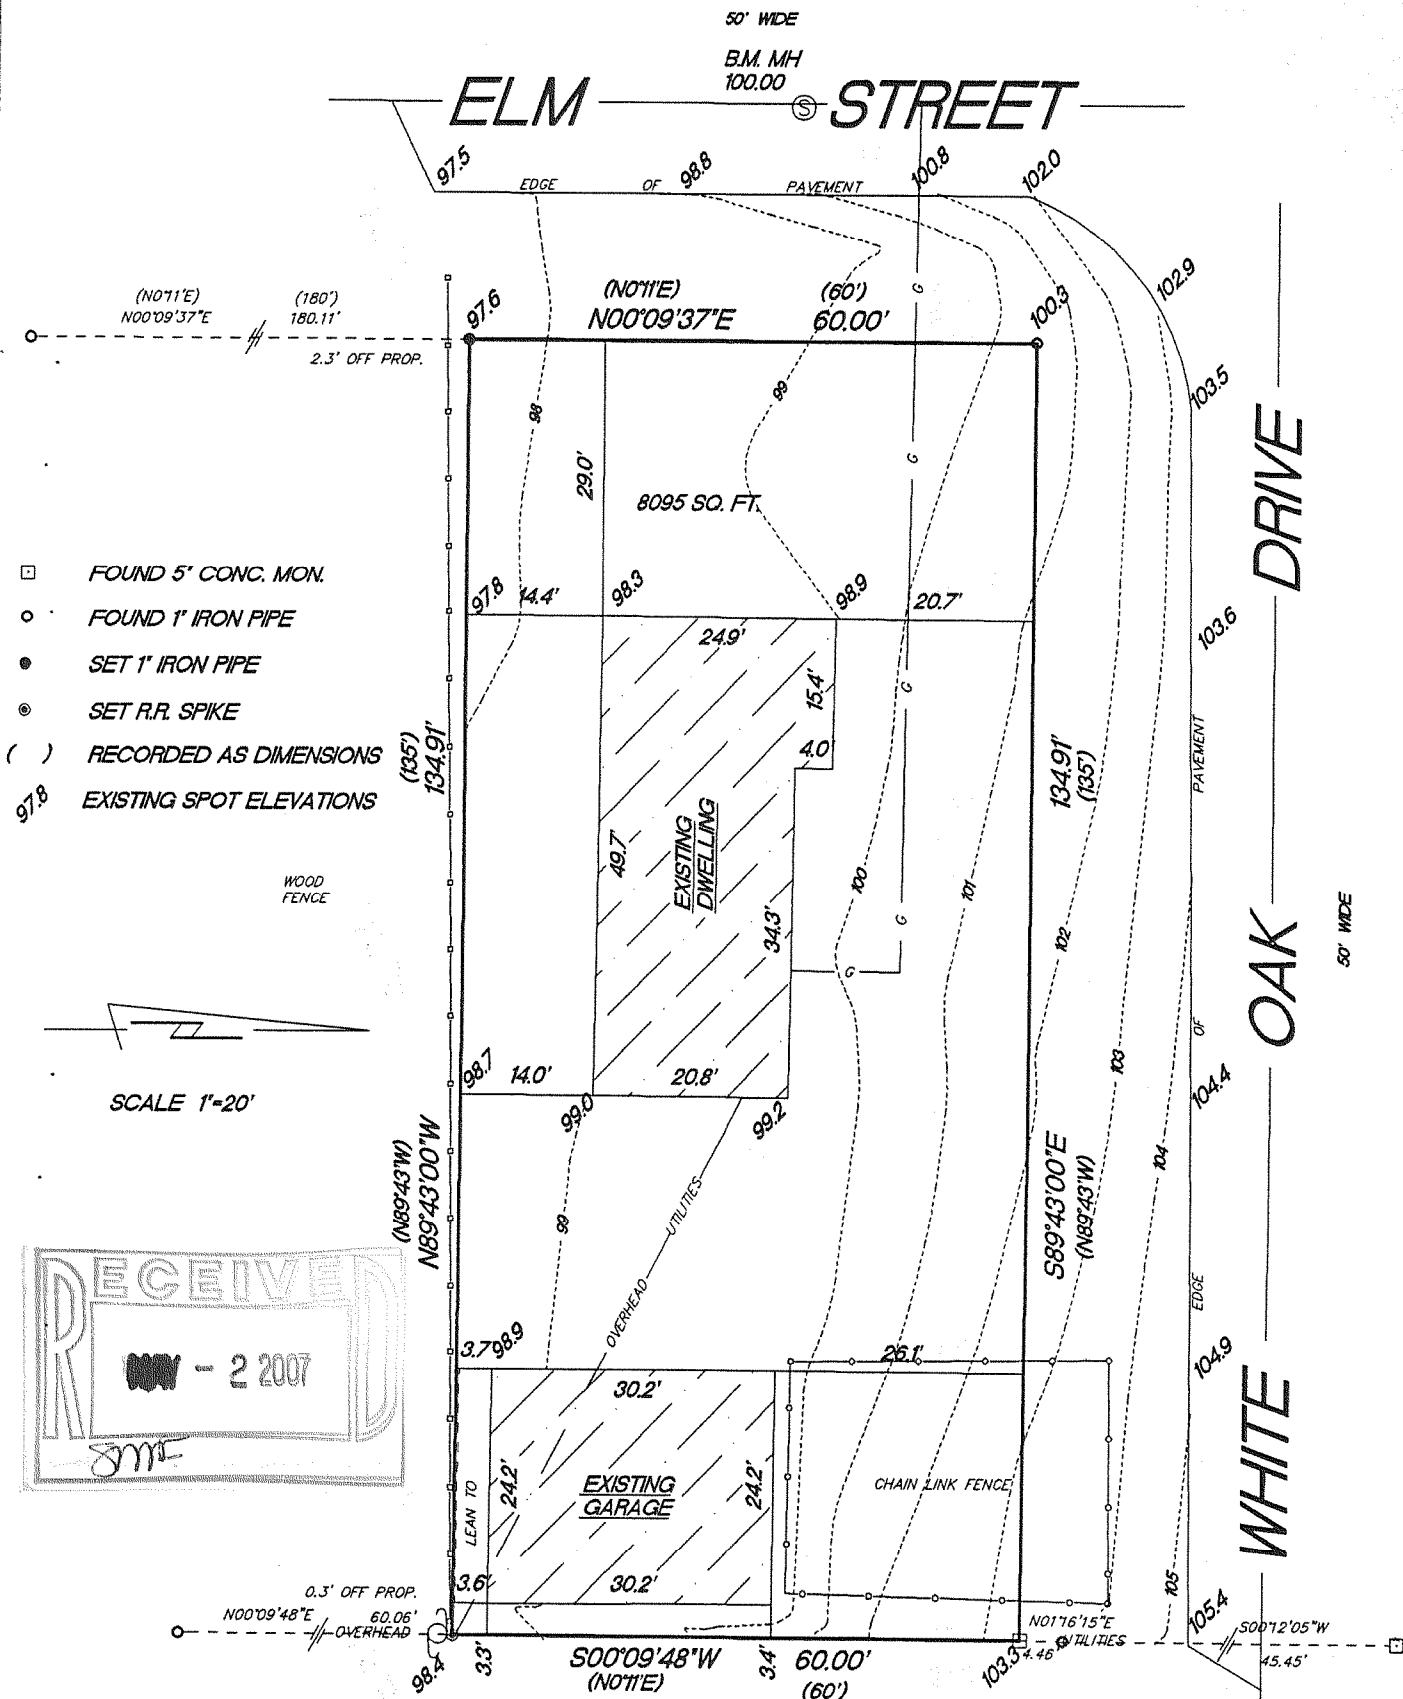


"I hereby certify that I have surveyed the above described property and that the above map is a true representation thereof and shows the size and location of the property, its exterior boundaries, the location of all visible structures and dimension of all principal buildings thereon, boundary fences, apparent easements, roadways and encroachments if any."

"This survey is made for the use of the present owners of the property, and also those who purchase, mortgage or guarantee the title thereto within one year from date hereof."

KETTLE MORaine SURVEYING INC.
W356 S9050 Godfrey Lane
Eagle Wisconsin 53119
P.O. Box 357
(262) 594-3484

Terrance E. Pisarek R.L.S.

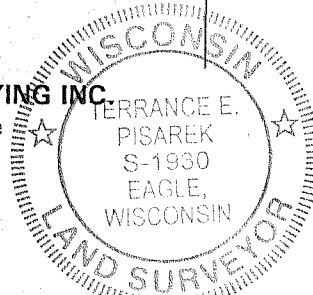

THIS IS NOT AN ORIGINAL SURVEY UNLESS THE SEAL IS RED.

1/12/07

DATE

TEP

FIELD WORK BY

TEP

DRAWN BY

07006

JOB NUMBER

PMRI-1

418-2011