

HOLLAND & THOMAS, L.L.C. - LAND SURVEYORS

202 West Street Johnson Creek, WI 53038 (920) 699-3305

PLAT OF SURVEY

FOR LOT 19, BLOCK 7 OF MIRIMAR SUBDIVISION, BEING A PART OF SECTIONS 10 AND 11, TOWN 4 NORTH, RANGE 18 EAST, TOWN OF EAST TROY, WALWORTH COUNTY, WISCONSIN.

LOT 20,
BLOCK 7

$N 86^{\circ}48'30'' E 140.00'$

1" I.D. IP

$S 03^{\circ}29'54'' E$
199.96'

1" I.D. IP


$S 03^{\circ}29'54'' E 50.00'$

P.K. NAIL

$S 03^{\circ}29'54'' E$
99.42'

1" I.D. IP

BEARINGS ARE REFERENCED TO THE WEST LINE OF HICKORY STREET RIGHT-OF-WAY, AS MONUMENTED, WHICH IS ASSUMED TO BEAR $S 03^{\circ}29'54'' E$.

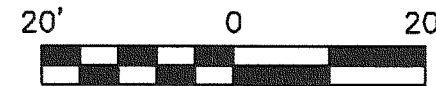


LEGEND: These standard symbols may be found in the drawing.

- Lot Corner (Found) w/desc.
- Lot Corner (Set) w/desc.
- ⊗ Utility Pole
- ⊠ Mail Box
- ⊙ Well
- ⊙ Air Conditioner
- Fence (Wood)
- OHP — Overhead Power Lines

HICKORY STREET

(40' R.O.W.)

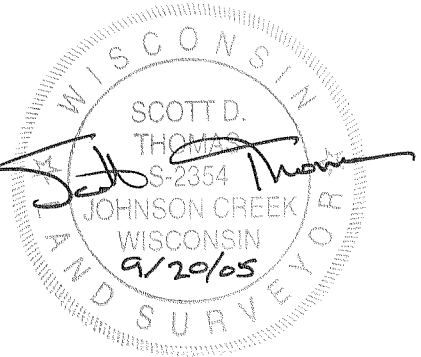

IF THE SURVEYOR'S SEAL IS NOT RED, THE PLAN IS A COPY THAT SHOULD BE ASSUMED TO CONTAIN UNAUTHORIZED ALTERATIONS. THE CERTIFICATION CONTAINED ON THIS DOCUMENT DOES NOT APPLY TO COPIES UNLESS THEY TOO HAVE A RED STAMP OVER THE PHOTOCOPIED STAMP BY SAME SURVEYOR.

FOR: MIKE LEMAY

State of Wisconsin } SS.
County of Jefferson }

We, Holland & Thomas, L.L.C., do hereby certify that we have made this survey and that the information as shown on the above Plat of Survey is a true and correct representation thereof.

PMR-09

418-2026