

PLAT OF SURVEY

UNPLATTED LANDS
TAX KEY # PET 2200002


UNPLATTED LANDS
TAX KEY # PET 220001A

33' HILLBURN
MILL RD. DEDICATED
FOR ROAD PURPOSES

FOR: JOHN NICKELS III
DATE: 3/20/2007
REV: 3/29/2007 CHANGED 20' SET BACK
TO 25' PER WALWORTH COUNTY
REV: 4/4/07 MOVED HOUSE AS REQUESTED BY OWNER
REV: 5/7/2007 RECERTIFICATION
PROJECT NO.: 07-027
LEGAL DESCRIPTION: BEING ALL THAT PART OF LOT 2
CERTIFIED SURVEY MAP NO. 3806 LOCATED IN PART OF
THE SW¹/₄ OF THE NE¹/₄ SECTION 22, TOWN 4 NORTH,
RANGE 18 EAST, TOWN OF EAST TROY, WALWORTH
COUNTY, WISCONSIN.


I MICHAEL A. GREESON, R.L.S. # 2770 HEREBY
CERTIFY THAT THIS SURVEY WAS MADE IN
ACCORDANCE WITH THE MINIMUM STANDARDS FOR
PROPERTY SURVEYS (CHAPTER A-ET) STATE OF
WISCONSIN AND HAS BEEN PREPARED UNDER MY
DIRECTION AND CONTROL AND IS CORRECT TO THE
BEST OF MY KNOWLEDGE AND BELIEF.

Michael A. Greeson
MICHAEL A. GREESON, R.L.S. # 2770

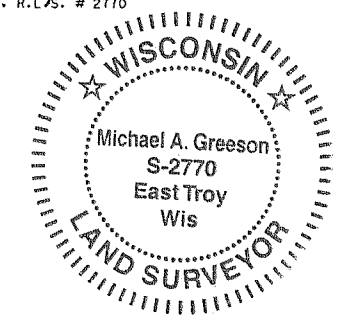



LEGEND

- FOUND IRON PIPE
- POWER POLE
- OHE OVER HEAD ELECTRIC
- ⊙ SEPTIC TANK
- ⊙ SEPTIC VENT

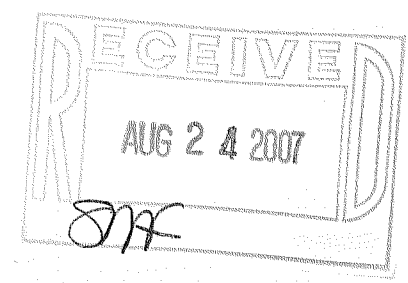

AS-BUILT BUILDING ELEVATIONS

ITEM	ELEV.
TOP OF FOOTING-UPPER	801.09
TOP OF WALL-UPPER	810.23
TOP OF WALL-LOWER	801.45

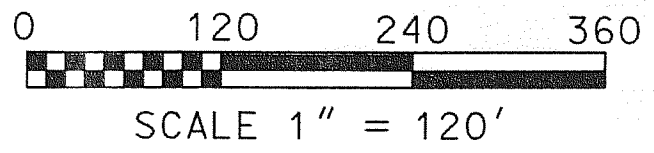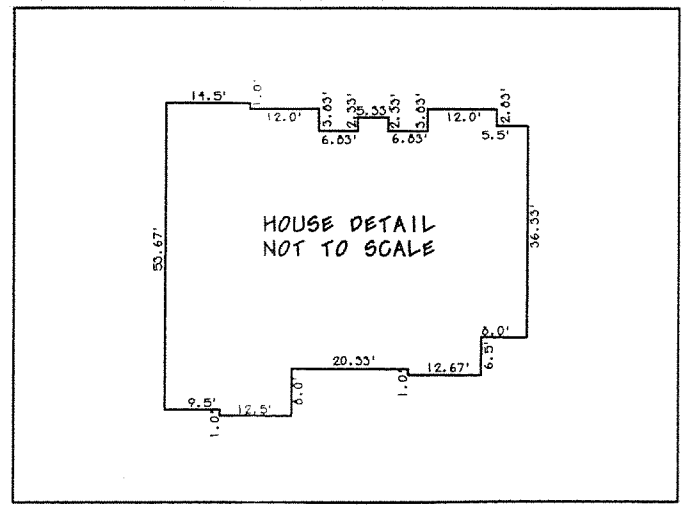

PA3806-2

418-2043