


RECERTIFICATION PLAT OF SURVEY

RECORDED LEGAL DESCRIPTION:

(TAKEN FROM WARRANTY DEED, DOCUMENT NO. 0584539)
LOT 1 OF CERTIFIED SURVEY MAP NO. 1818 RECORDED IN THE OFFICE OF THE REGISTER OF DEEDS FOR
WALWORTH COUNTY, WISCONSIN ON MAY 2, 1989 IN VOLUME 8 OF CERTIFIED SURVEY MAPS, PAGE 303, AS
DOCUMENT NO. 177303, LOCATED IN THE NORTHWEST 1/4 OF THE NORTHWEST 1/4 AND THE SOUTHWEST 1/4
OF THE NORTHWEST 1/4 OF SECTION 4, IN TOWNSHIP 4 NORTH, RANGE 18 EAST, IN THE TOWN OF EAST TROY,
WALWORTH COUNTY, WISCONSIN.

LEGEND:

1" ●	IRON PIPE-FOUND (SIZED AS NOTED)
1" ○	IRON ROD-FOUND
1.5" ○	"MAG" MASONRY NAIL-SET
⊙	POWER POLE
⊙	LIGHT POLE
⊙	ELECTRIC PEDESTAL
⊙	TELECOMMUNICATIONS PEDESTAL
⊙	CABLE TV PEDESTAL
—	OVERHEAD UTILITY LINE
⊙	SEPTIC TANK
⊙	SEPTIC VENT

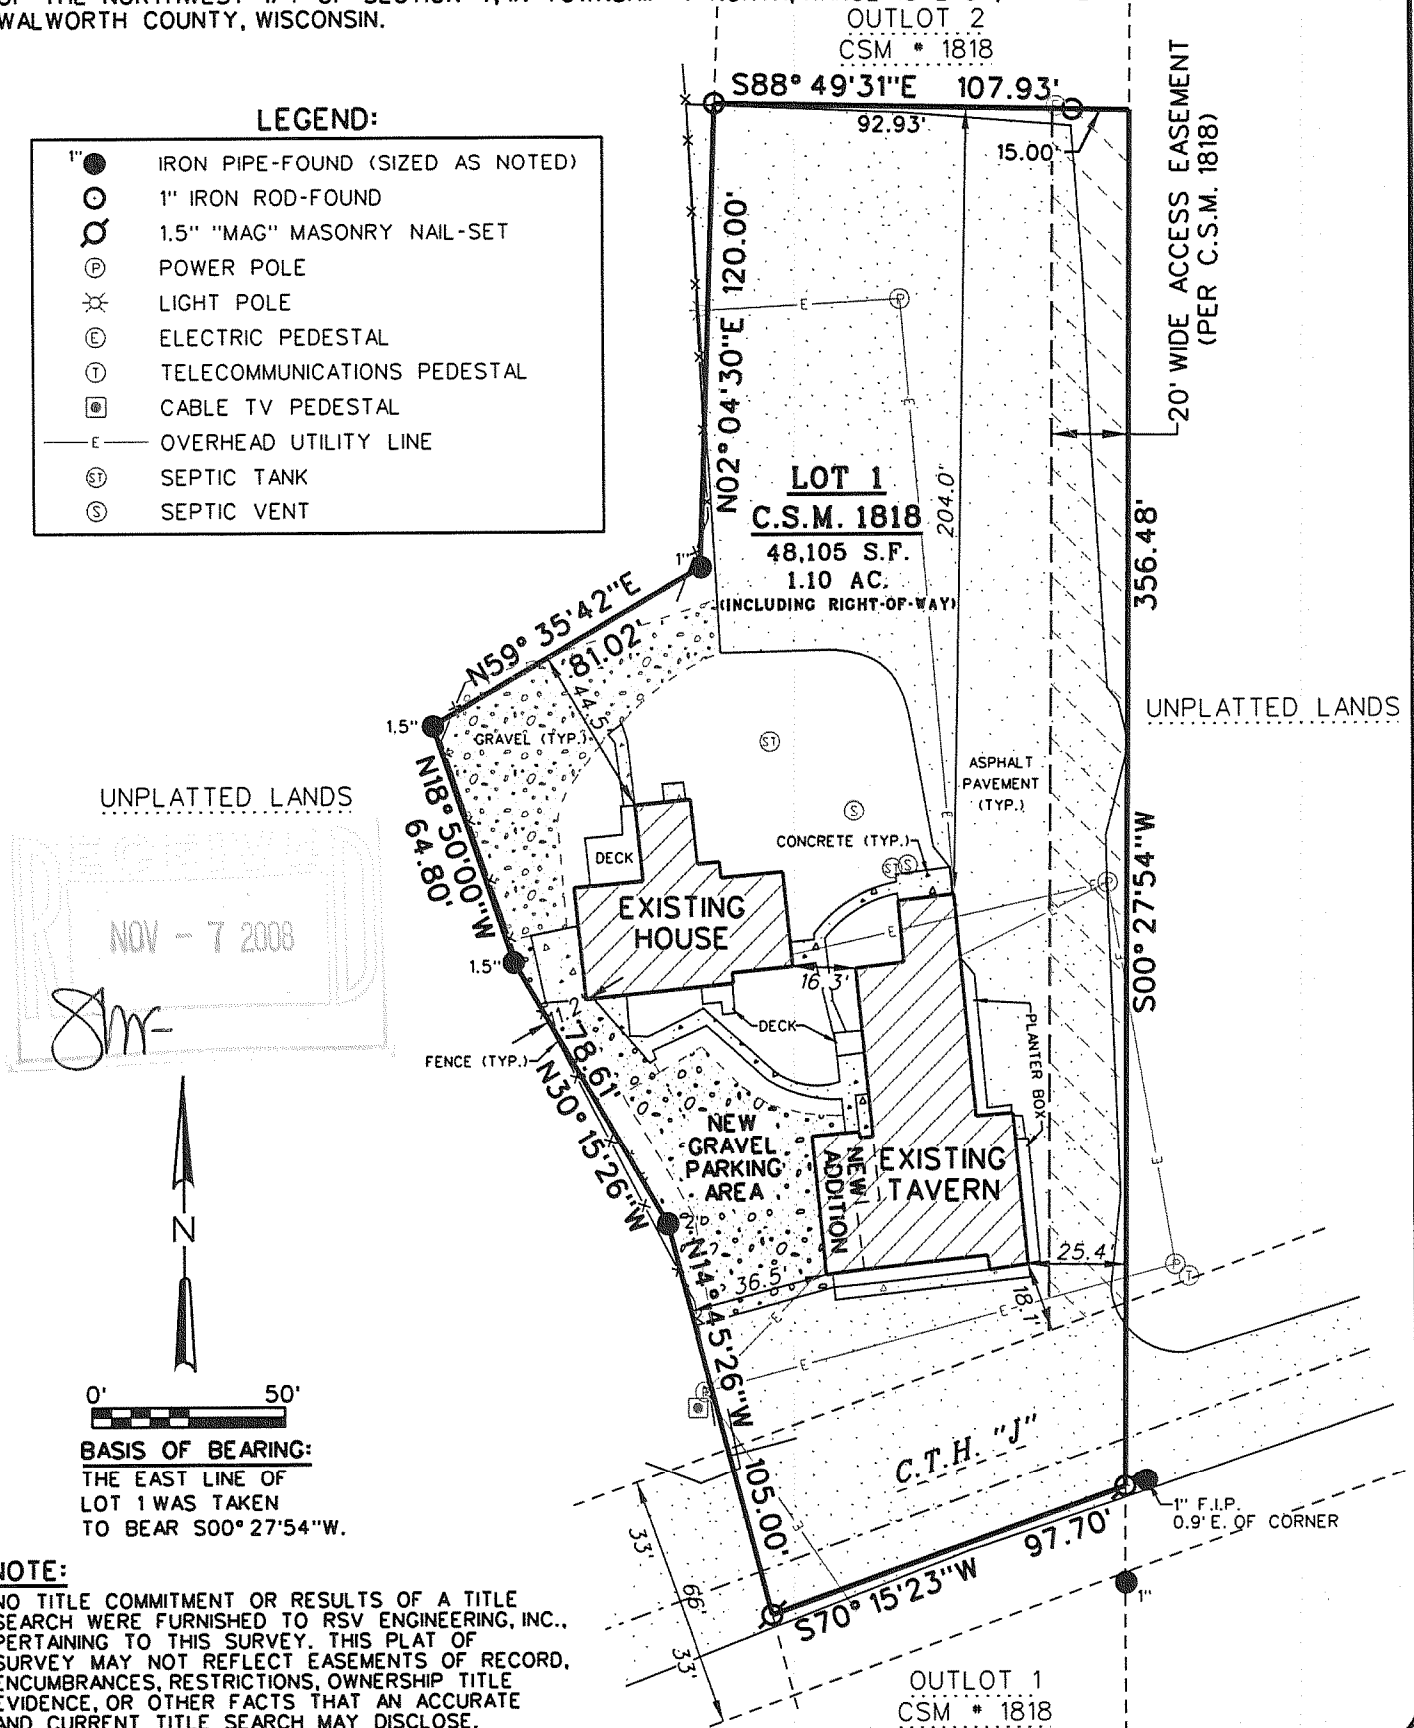

NOTE:


NO TITLE COMMITMENT OR RESULTS OF A TITLE SEARCH WERE FURNISHED TO RSV ENGINEERING, INC., PERTAINING TO THIS SURVEY. THIS PLAT OF SURVEY MAY NOT REFLECT EASEMENTS OF RECORD, ENCUMBRANCES, RESTRICTIONS, OWNERSHIP TITLE EVIDENCE, OR OTHER FACTS THAT AN ACCURATE AND CURRENT TITLE SEARCH MAY DISCLOSE.

LAST REVISED: 09/03/2008
SURVEY DATE: 03/26/2008
SURVEY MADE FOR:
STRAIGHT ARROW
BUILDERS, LLC

RSV
ENGINEERING, INC.
W232 S7530 BIG BEND DRIVE
BIG BEND, WI 53103
(262) 662-4292

THIS SURVEY IS MADE FOR THE USE OF THE PRESENT OWNERS OF THE PROPERTY, AND ALSO THOSE WHO PURCHASE, MORTGAGE OR GUARANTEE TITLE TO WITHIN ONE (1) YEAR FROM DATE HERETO.

I, KENNETH B. MEHRING R.L.S. *2838, HEREBY CERTIFY THAT THIS SURVEY WAS MADE IN ACCORDANCE WITH THE MINIMUM STANDARDS FOR PROPERTY SURVEYS (CHAPTER A-E 7) FOR THE STATE OF WISCONSIN AND HAS BEEN PREPARED UNDER MY DIRECTION AND CONTROL AND IS CORRECT TO THE BEST OF MY KNOWLEDGE AND BELIEF.

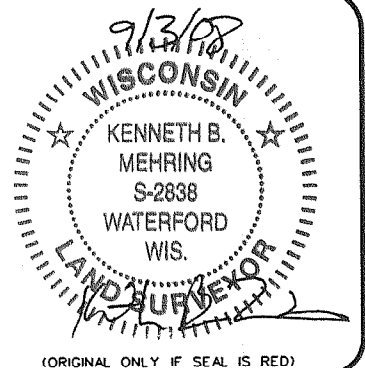

(ORIGINAL ONLY IF SEAL IS RED)

FILE NAME: F:\1 - Projects\2008\08-026 Mike Senft POS Double D's\CAD\Survey\08026 RECERT.dgn

PLOT DATE: 9/3/2008

RSV JOB#: 08-026

CAD: Survey\08026 RECERT.dgn 9/3/2008 7:00:57 AM D:\1818

418-2135