


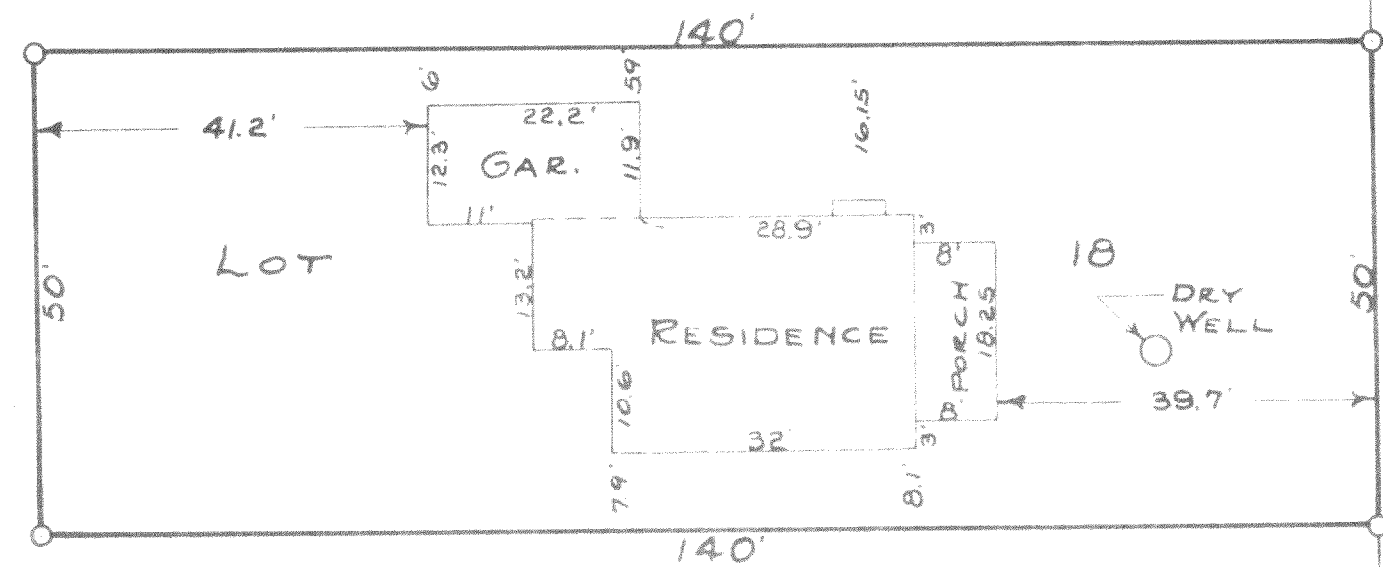

STREET

HICKORY

40'

WHITEOAK

DRIVE

40'



SCALE 1"=20'
O-IRON PIPE

[HEREBY CERTIFY: THAT I HAVE SURVEYED THE LAND SHOWN HEREON, THE DESCRIPTION OF WHICH IS AS FOLLOWS; LOT 18 OF BLOCK 12 OF MIRAMAR SUBDIVISION, WHICH SUBDIVISION IS LOCATED IN SECTIONS 10 AND 11 OF T4N R18E OF WALWORTH COUNTY WISCONSIN; THAT I HAVE LOCATED ALL BUILDINGS, FENCES, PROPERTY LINE HEDGES AND OTHER IMPROYEMENTS THAT ARE ON THE PROPERTY AS DESCRIBED ABOVE AND THAT I HAVE CORRECTLY LOCATED THE SAME ON THIS PLAT; THAT THE PLAT IS DRAWN TO SCALE AND THAT IRON PIPE STAKES WERE PLACED ATEACH OF THE FOUR CORNERS OF THE LOT.

Lloyd L. Luren
COUNTY SURVEYOR